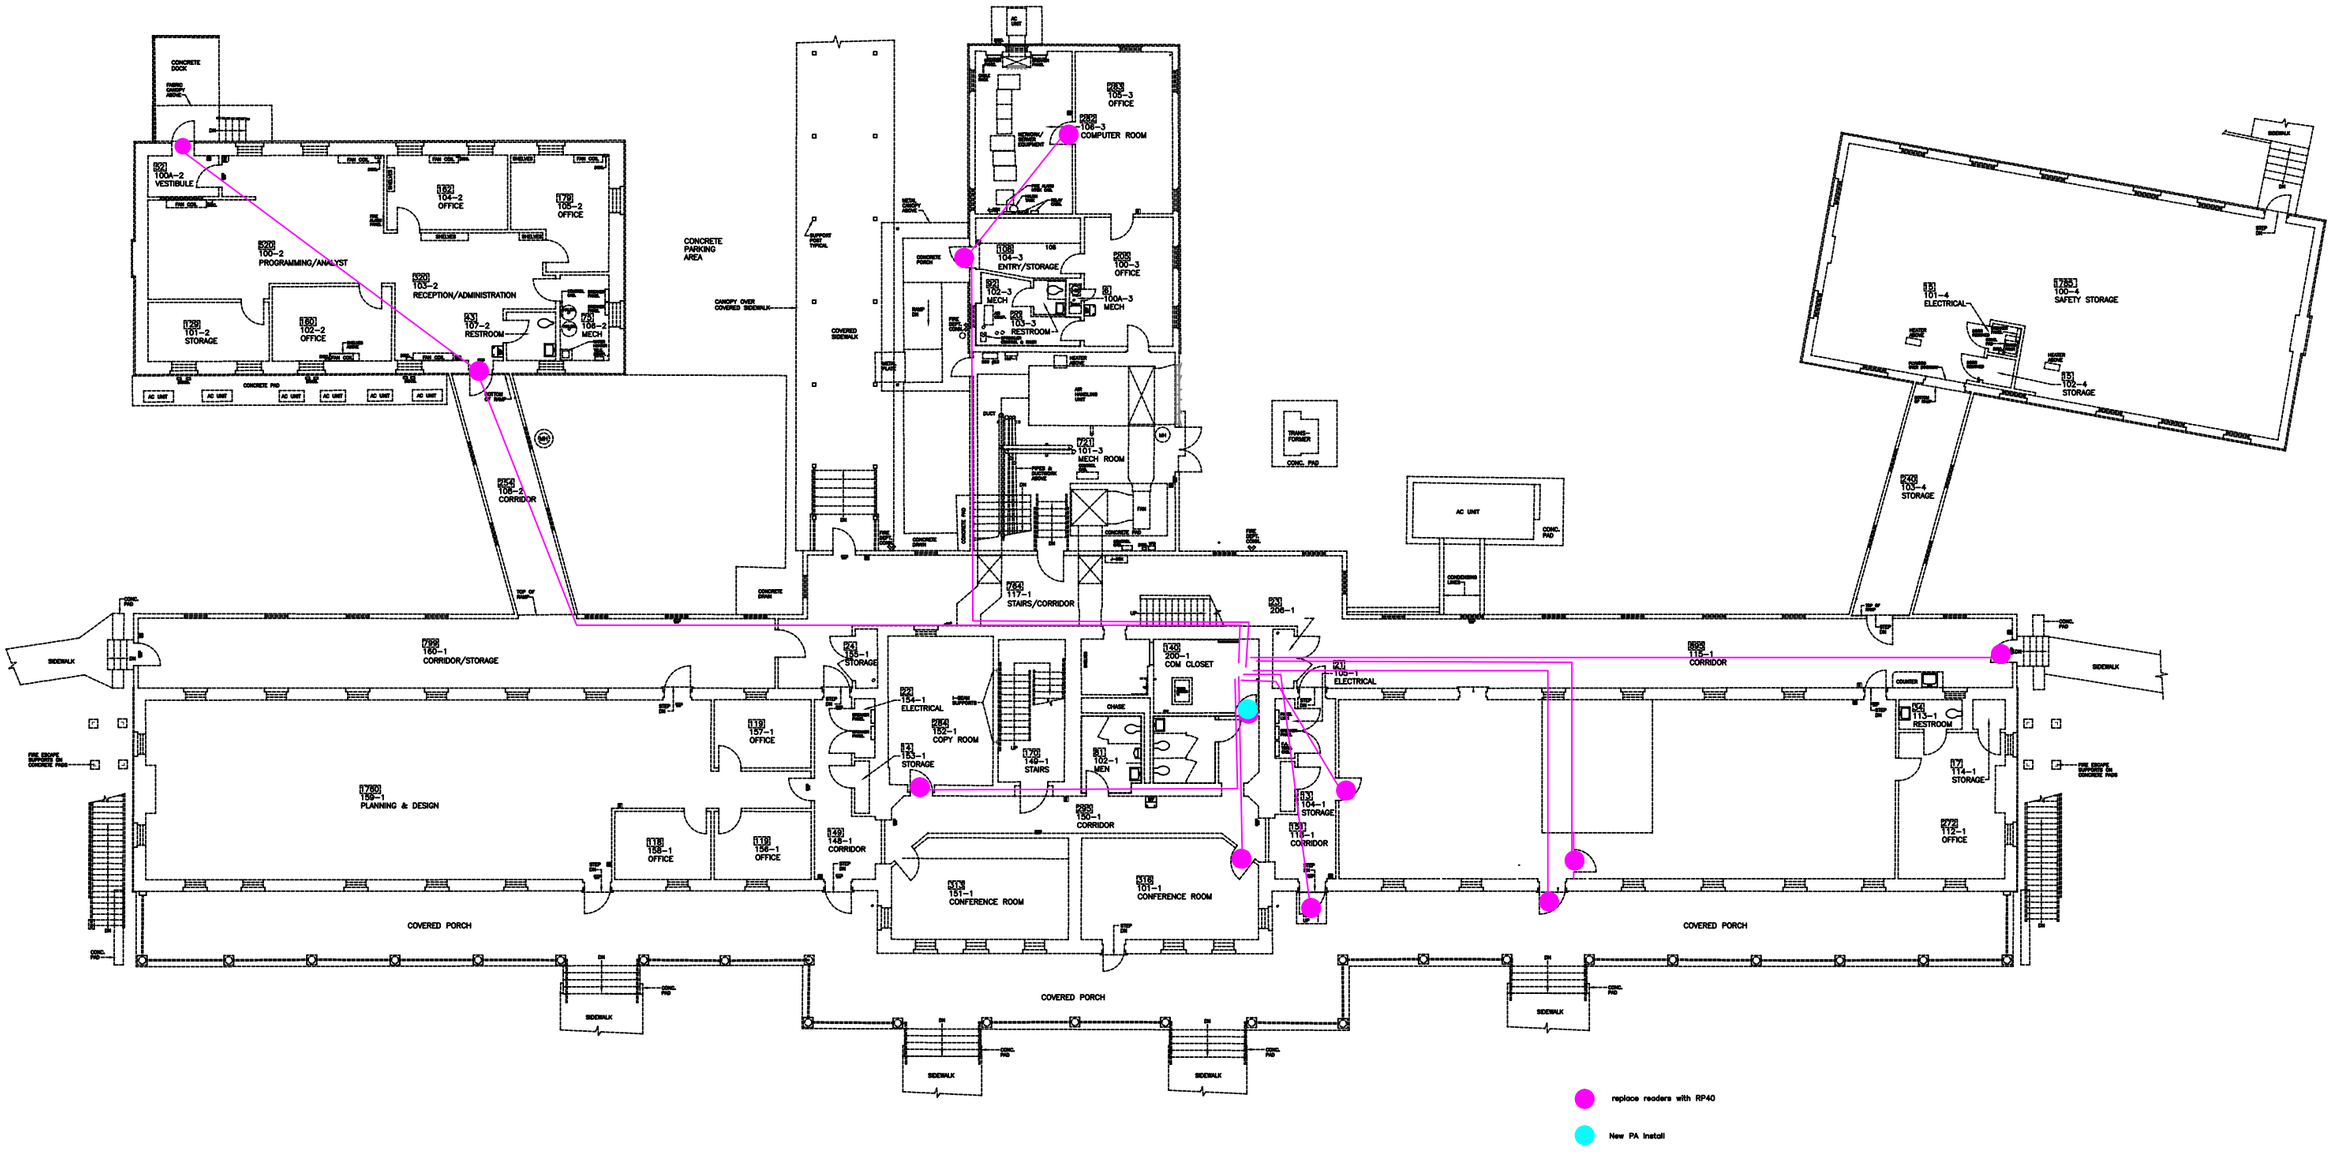

CONCRETE DOCK
100A-2 VESTIBULE
100-2 PROGRAMMING/ANALYST
103-2 RECEPTION/ADMINISTRATION
104-2 OFFICE
105-2 OFFICE
101-2 STORAGE
102-2 OFFICE
107-2 RESTROOM
106-2 MECH
CONCRETE PARKING AREA
CANOPY OVER COVERED SIDEWALK
COVERED SIDEWALK
105-3 OFFICE
106-3 COMPUTER ROOM
104-3 ENTRY/STORAGE
100-3 OFFICE
102-3 MECH
100A-3 MECH
103-3 RESTROOM
101-3 MECH ROOM
TRANS-FORMER
CONC. PAD
AC UNIT
108-2 CORRIDOR
117-1 STAIRS/CORRIDOR
206-1
160-1 CORRIDOR/STORAGE
155-1 STORAGE
154-1 ELECTRICAL
152-1 COPY ROOM
153-1 STORAGE
149-1 STAIRS
200-1 COM CLOSET
102-1 MEN
105-1 ELECTRICAL
115-1 CORRIDOR
113-1 RESTROOM
114-1 STORAGE
112-1 OFFICE
159-1 PLANNING & DESIGN
157-1 OFFICE
158-1 OFFICE
156-1 OFFICE
148-1 CORRIDOR
150-1 CORRIDOR
104-1 STORAGE
116-1 CORRIDOR
151-1 CONFERENCE ROOM
101-1 CONFERENCE ROOM
COVERED PORCH
SIDEWALK
101-4 ELECTRICAL
100-4 SAFETY STORAGE
102-4 STORAGE
103-4 STORAGE
replace readers with RP40
New PA Install