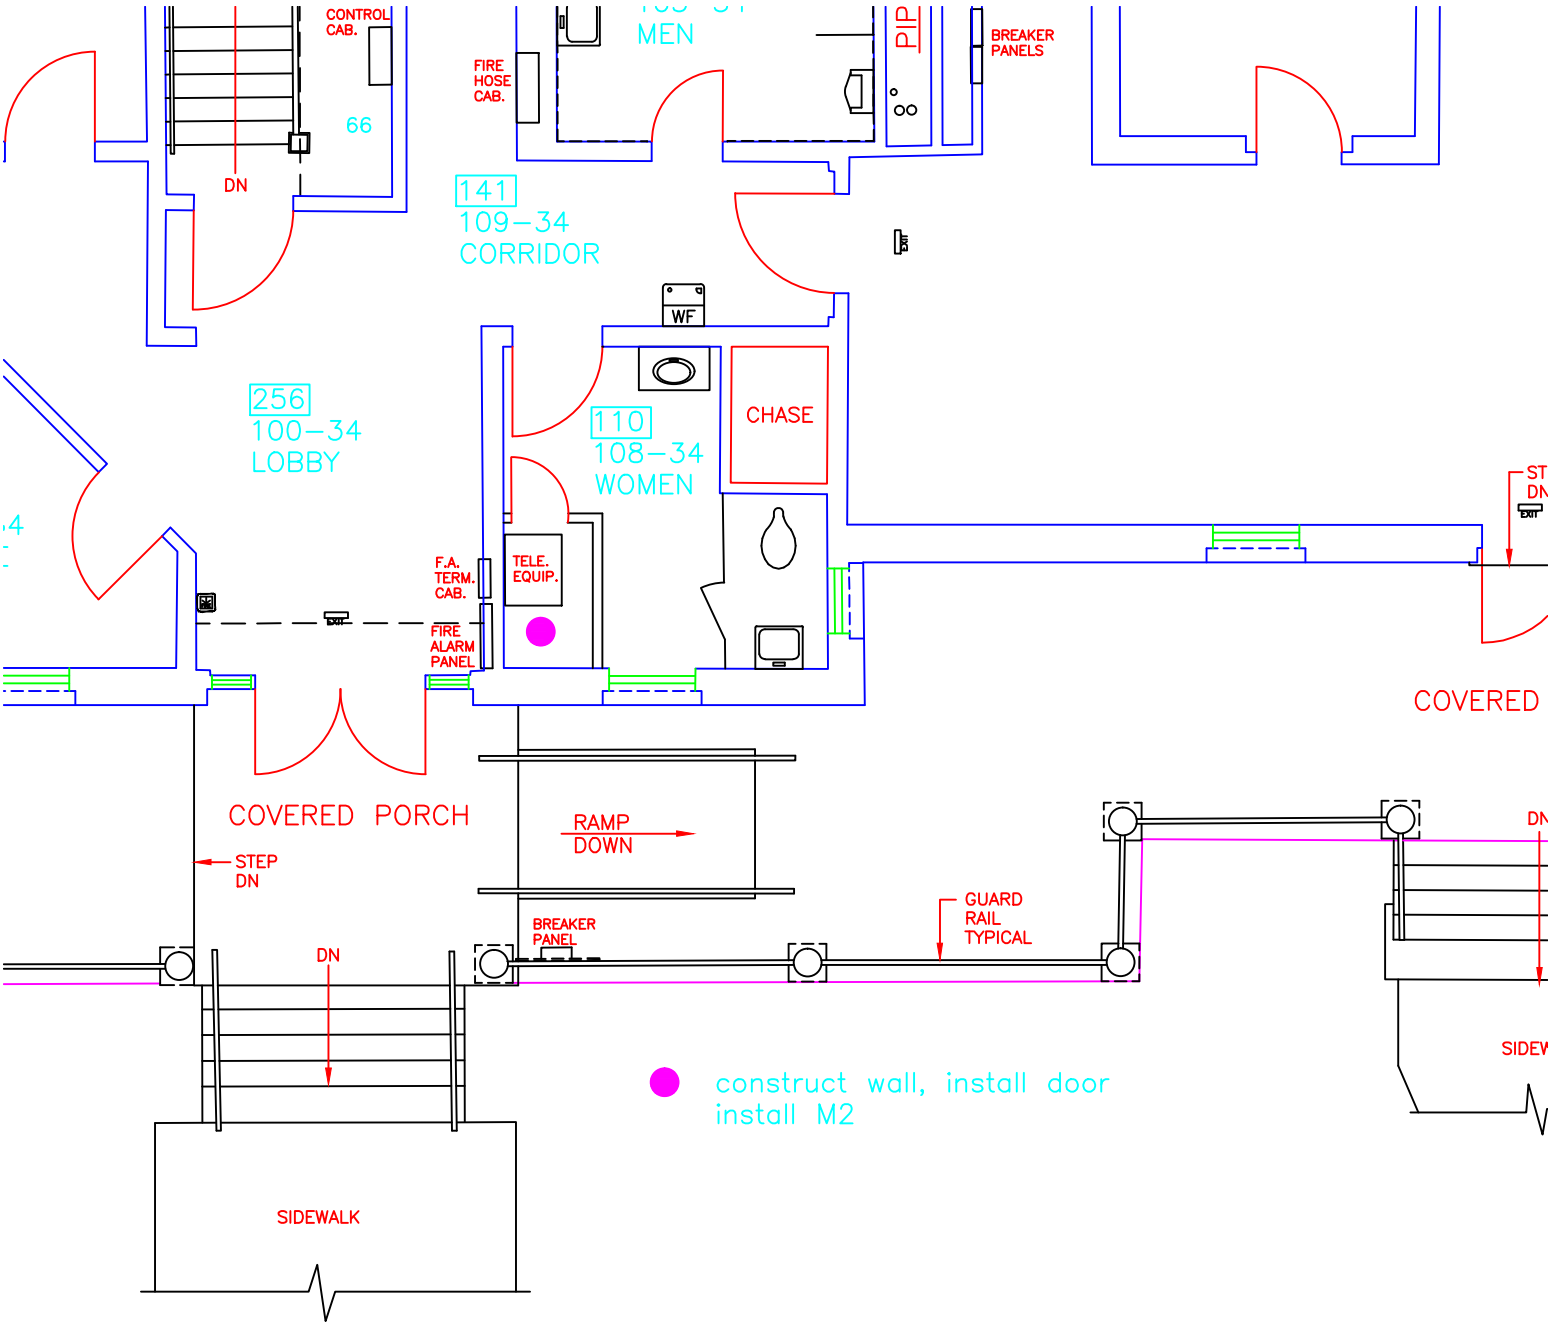
CONTROL CAB.
66
DN
FIRE HOSE CAB.
MEN
BREAKER PANELS
141
109–34
CORRIDOR
WF
256
100–34
LOBBY
110
108–34
WOMEN
CHASE
F.A. TERM. CAB.
TELE. EQUIP.
FIRE ALARM PANEL
COVERED
COVERED PORCH
RAMP DOWN
STEP DN
BREAKER PANEL
GUARD RAIL TYPICAL
DN
SIDEWALK
construct wall, install door
install M2