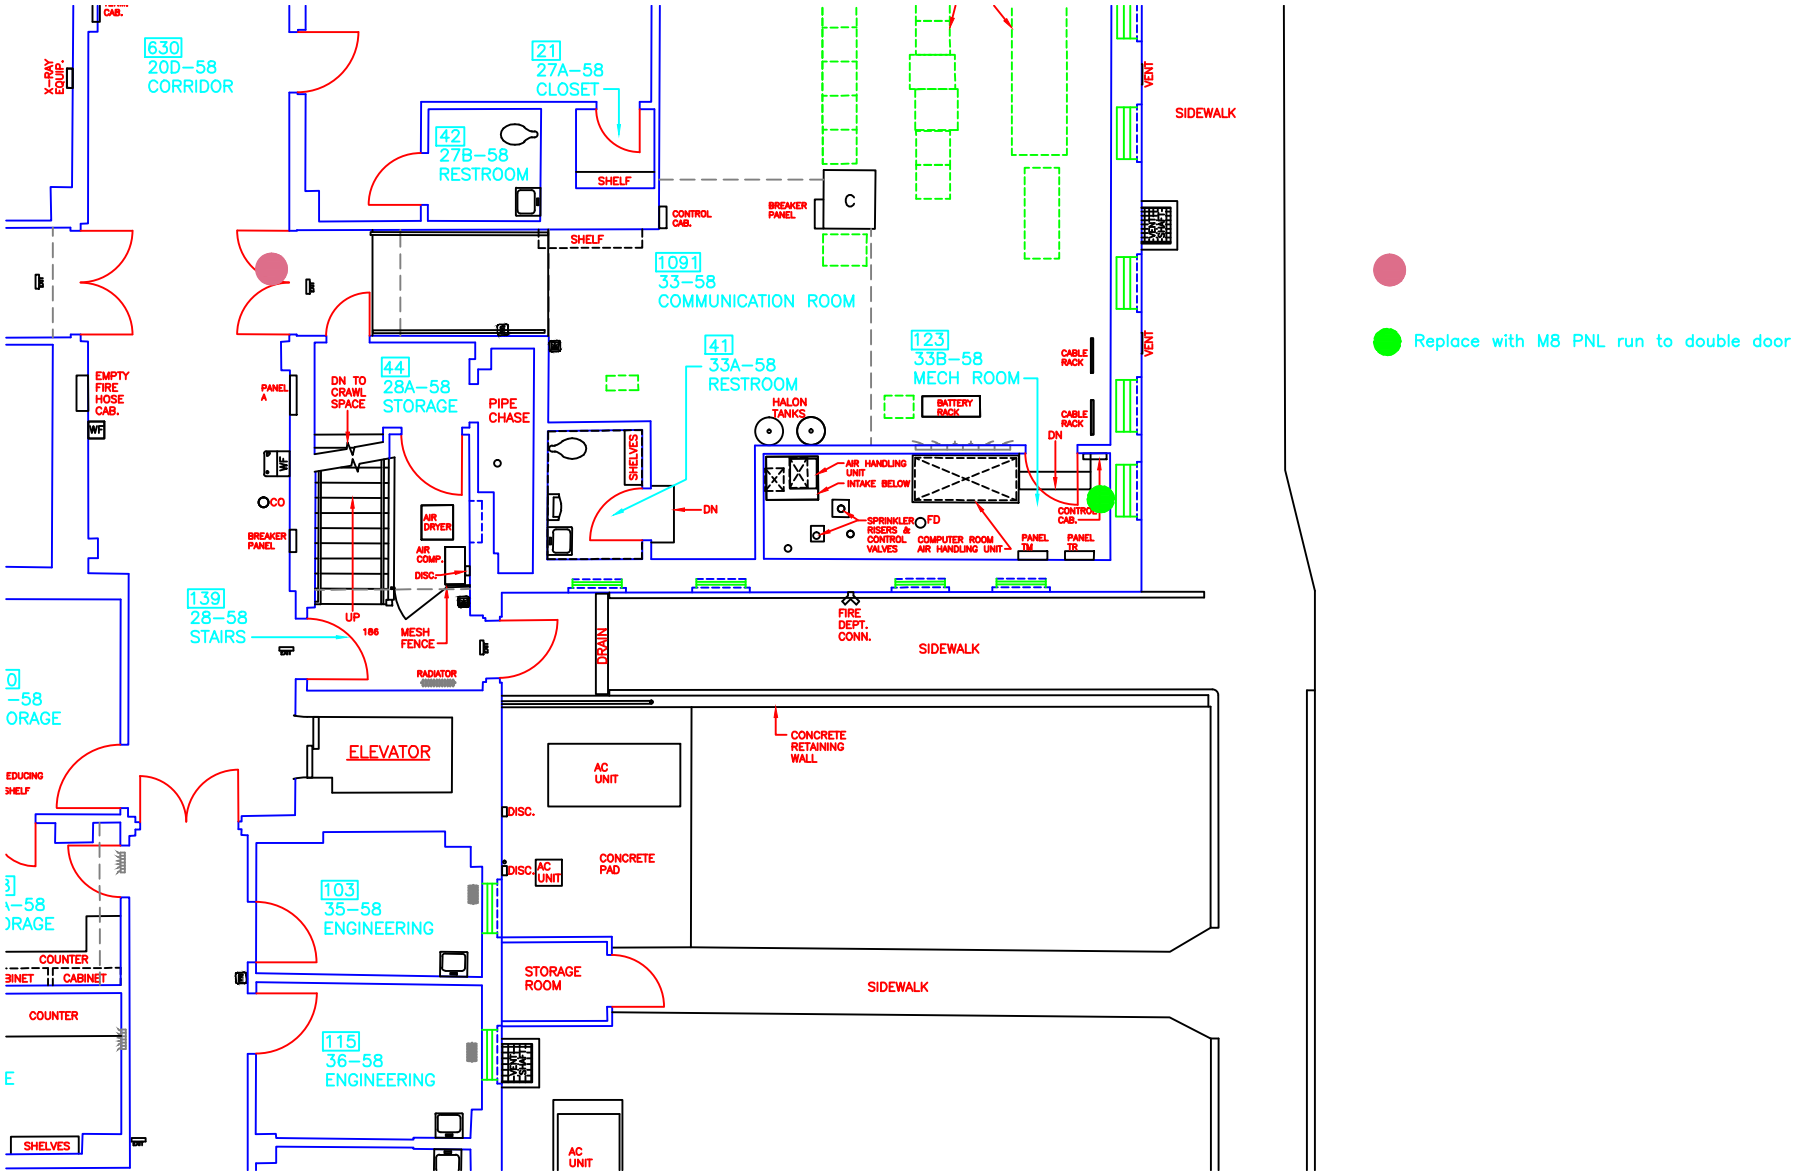
630
20D–58
CORRIDOR
21
27A–58
CLOSET
42
27B–58
RESTROOM
SHELF
CONTROL CAB.
BREAKER PANEL
C
1091
33–58
COMMUNICATION ROOM
41
33A–58
RESTROOM
123
33B–58
MECH ROOM
CABLE RACK
BATTERY RACK
HALON TANKS
AIR HANDLING UNIT INTAKE BELOW
SPRINKLER RISERS & CONTROL VALVES
FD
COMPUTER ROOM AIR HANDLING UNIT
PANEL TM
PANEL TR
VENT
SIDEWALK
EMPTY FIRE HOSE CAB.
X-RAY EQUIP.
44
28A–58
STORAGE
PIPE CHASE
DN TO CRAWL SPACE
PANEL A
SHELVES
DN
AIR DRYER
AIR COMP.
DISC.
CO
139
28–58
STAIRS
UP
186
MESH FENCE
RADIATOR
FIRE DEPT. CONN.
DRAIN
ELEVATOR
AC UNIT
CONCRETE RETAINING WALL
CONCRETE PAD
103
35–58
ENGINEERING
STORAGE ROOM
115
36–58
ENGINEERING
COUNTER
CABINET
SHELVES
Replace with M8 PNL run to double door