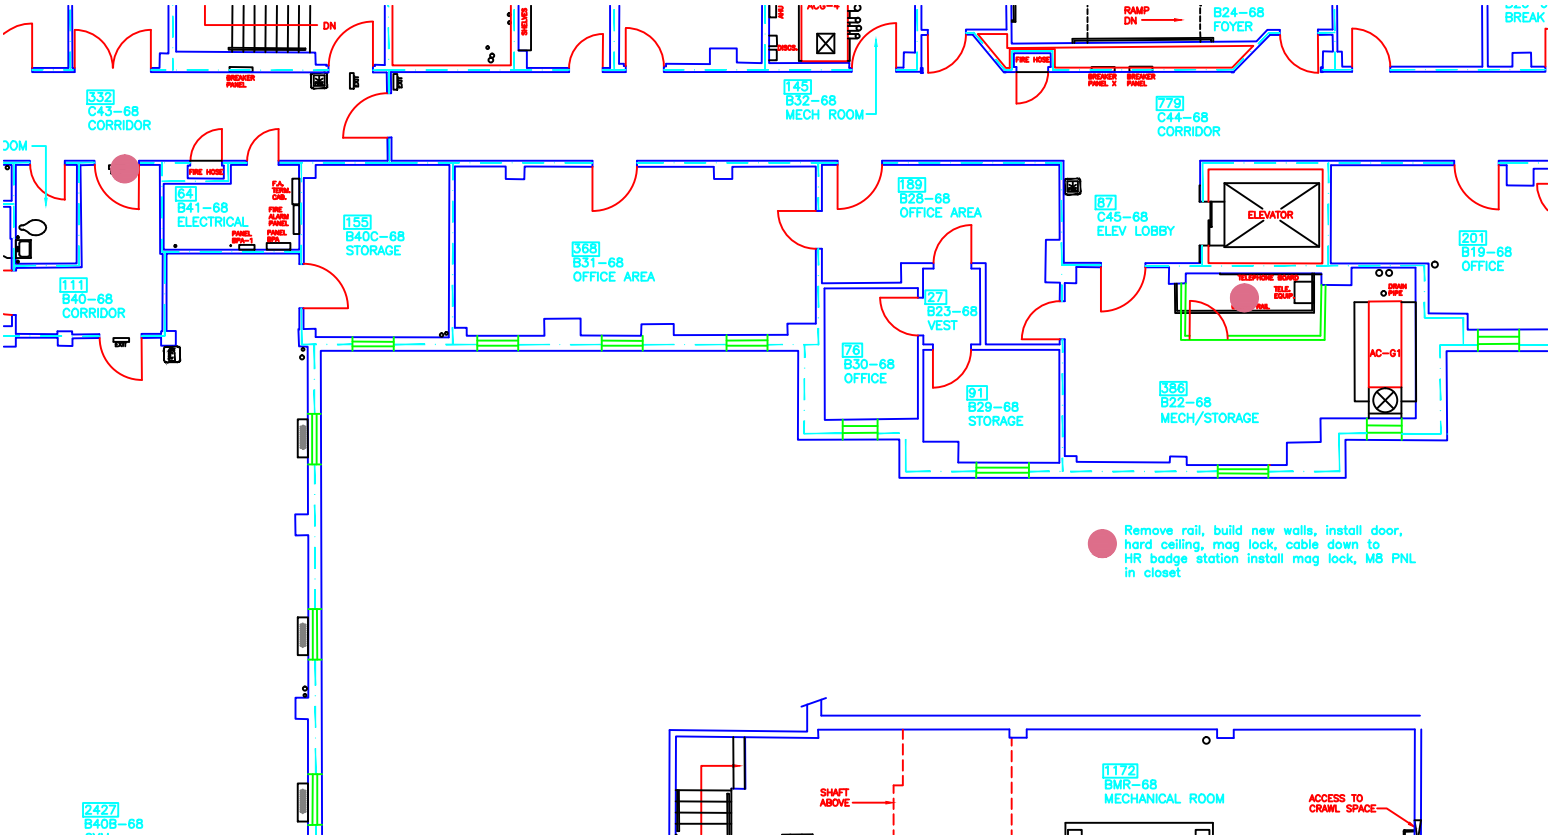

DN
BREAKER PANEL
332
C43-68
CORRIDOR
FIRE HOSE
64
B41-68
ELECTRICAL
F.A. TERM. CAB.
FIRE ALARM PANEL
PANEL BPA-1
PANEL BPA
155
B40C-68
STORAGE
111
B40-68
CORRIDOR
368
B31-68
OFFICE AREA
145
B32-68
MECH ROOM
RAMP DN
B24-68
FOYER
BREAKER PANEL X
BREAKER PANEL
779
C44-68
CORRIDOR
189
B28-68
OFFICE AREA
87
C45-68
ELEV LOBBY
ELEVATOR
TELEPHONE BOARD
TELE. EQUIP
RAIL
DRAIN PIPE
201
B19-68
OFFICE
27
B23-68
VEST
76
B30-68
OFFICE
91
B29-68
STORAGE
386
B22-68
MECH/STORAGE
AC-G1
Remove rail, build new walls, install door, hard ceiling, mag lock, cable down to HR badge station install mag lock, M8 PNL in closet
SHAFT ABOVE
1172
BMR-68
MECHANICAL ROOM
ACCESS TO CRAWL SPACE
2427
B40B-68