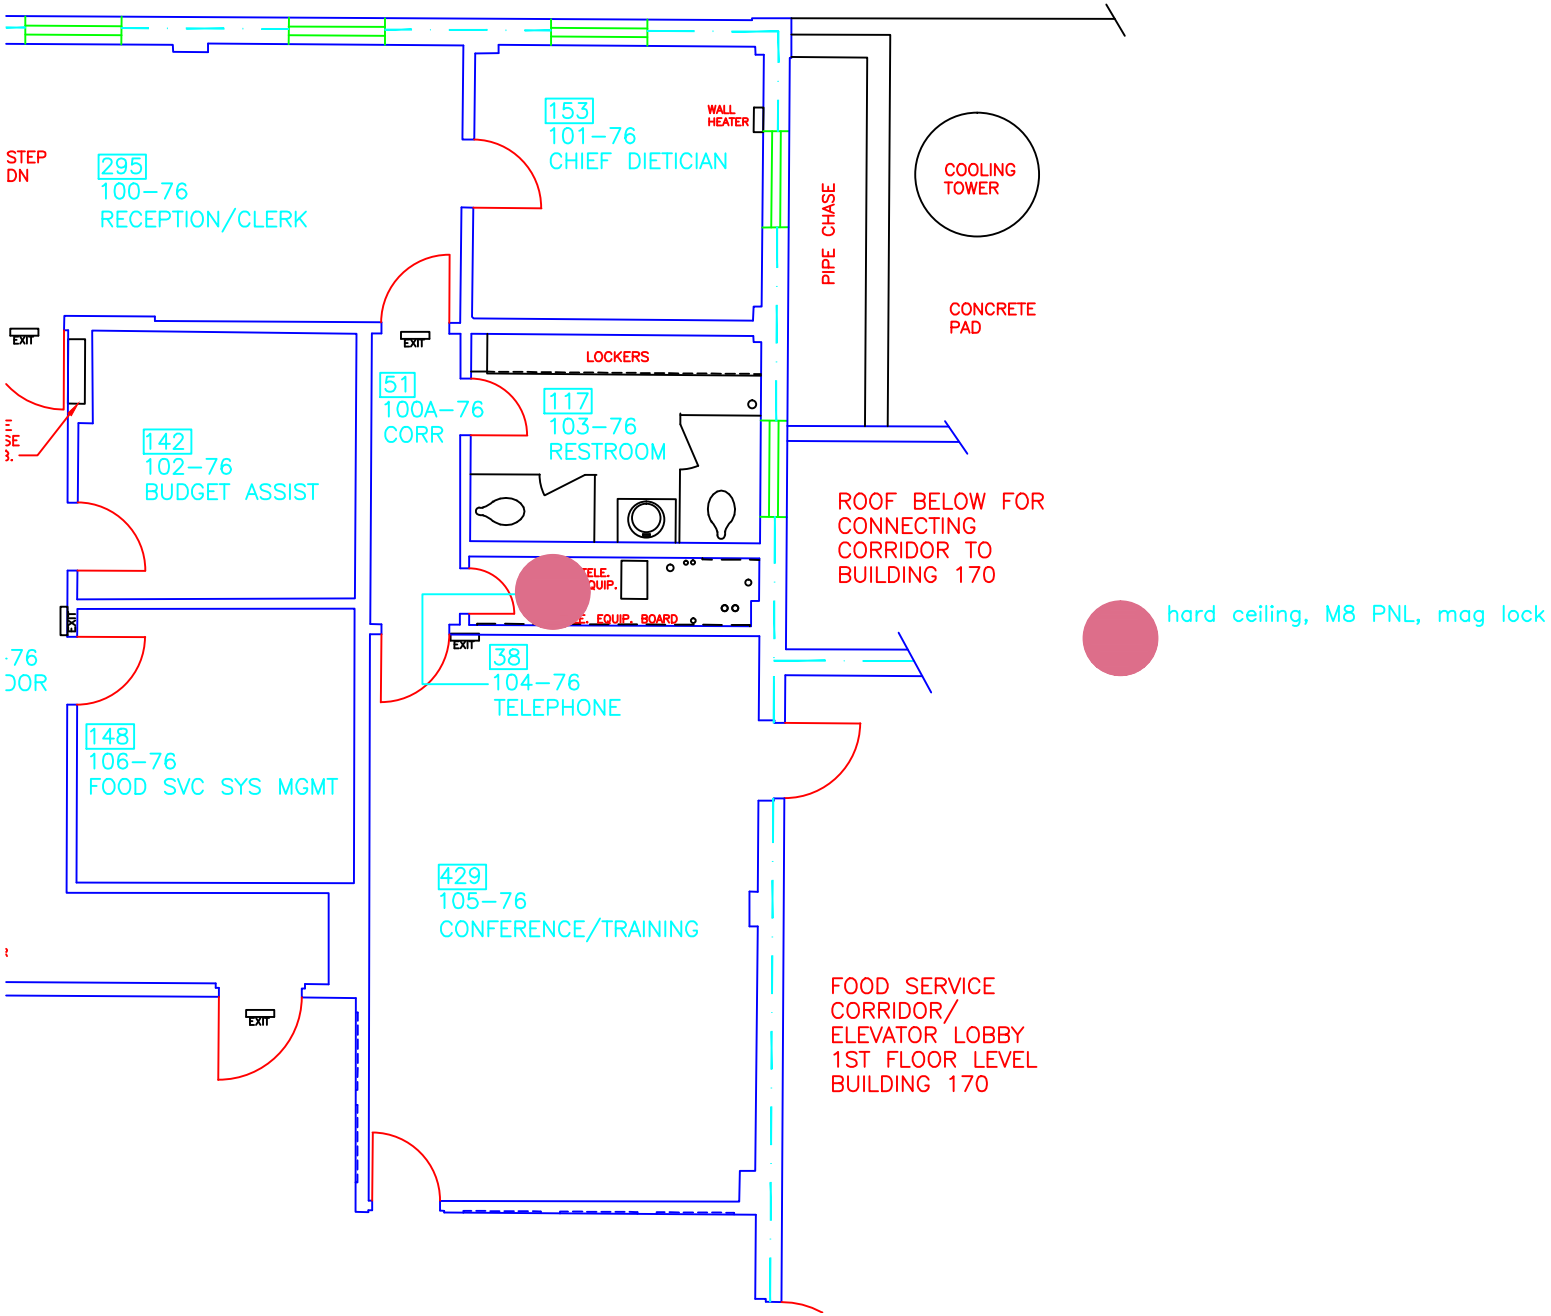

hard ceiling, M8 PNL, mag lock