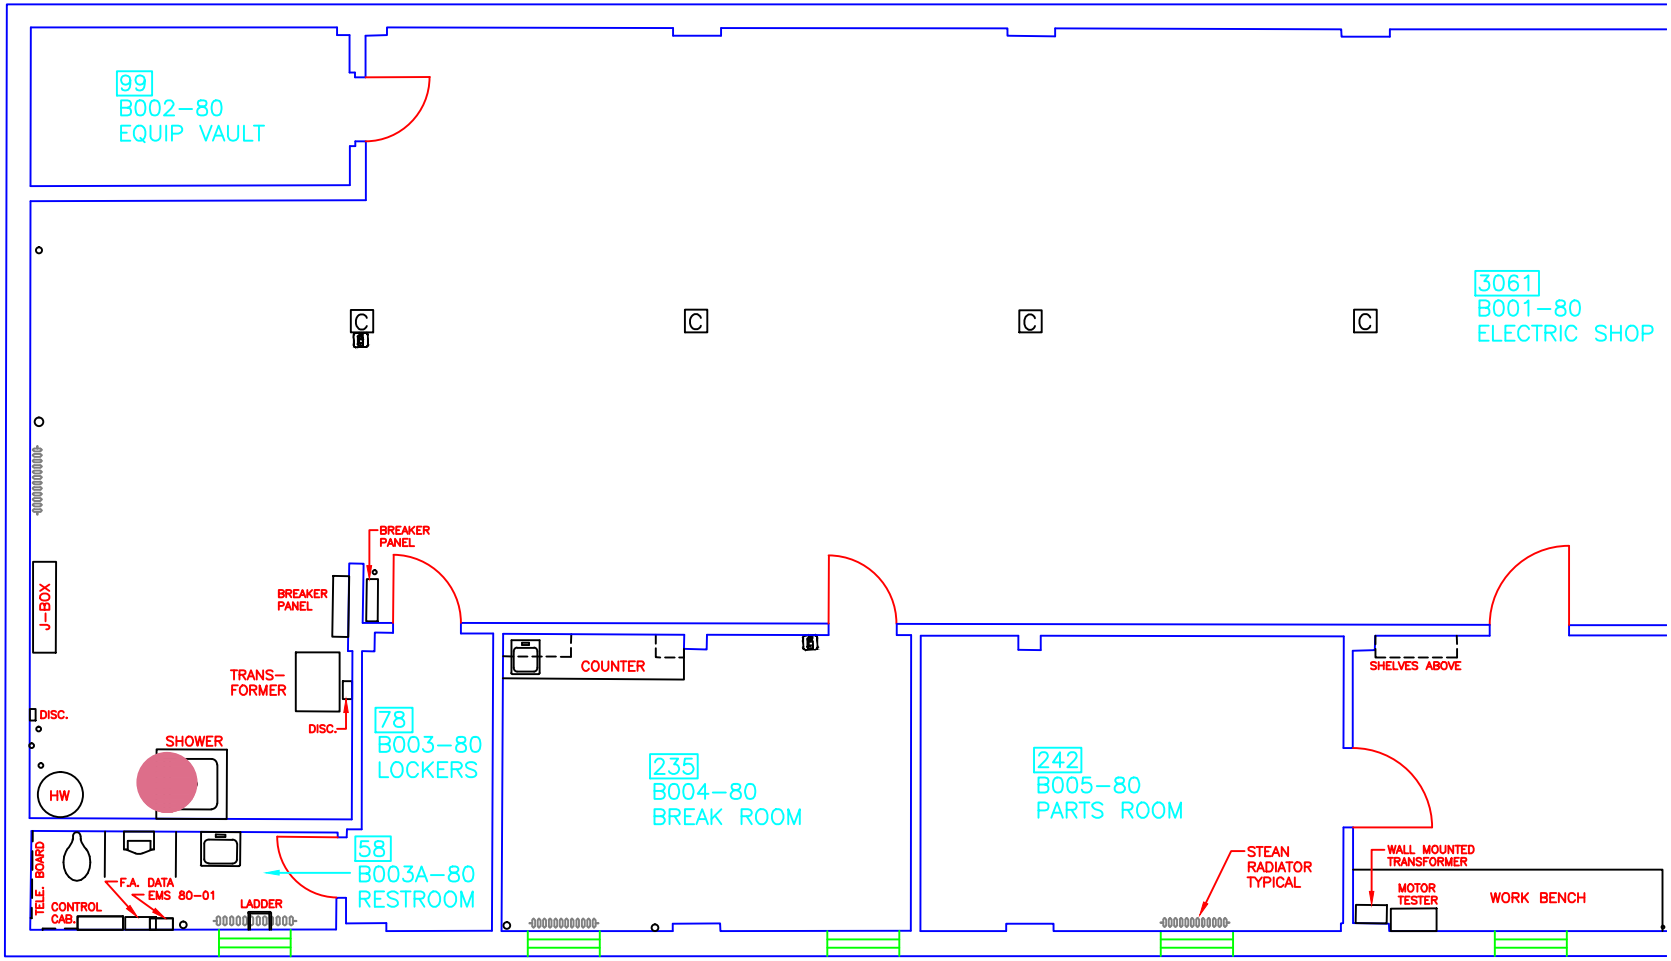demo shower, relocate, Blue rack cabinet, latch locks, expanded metal