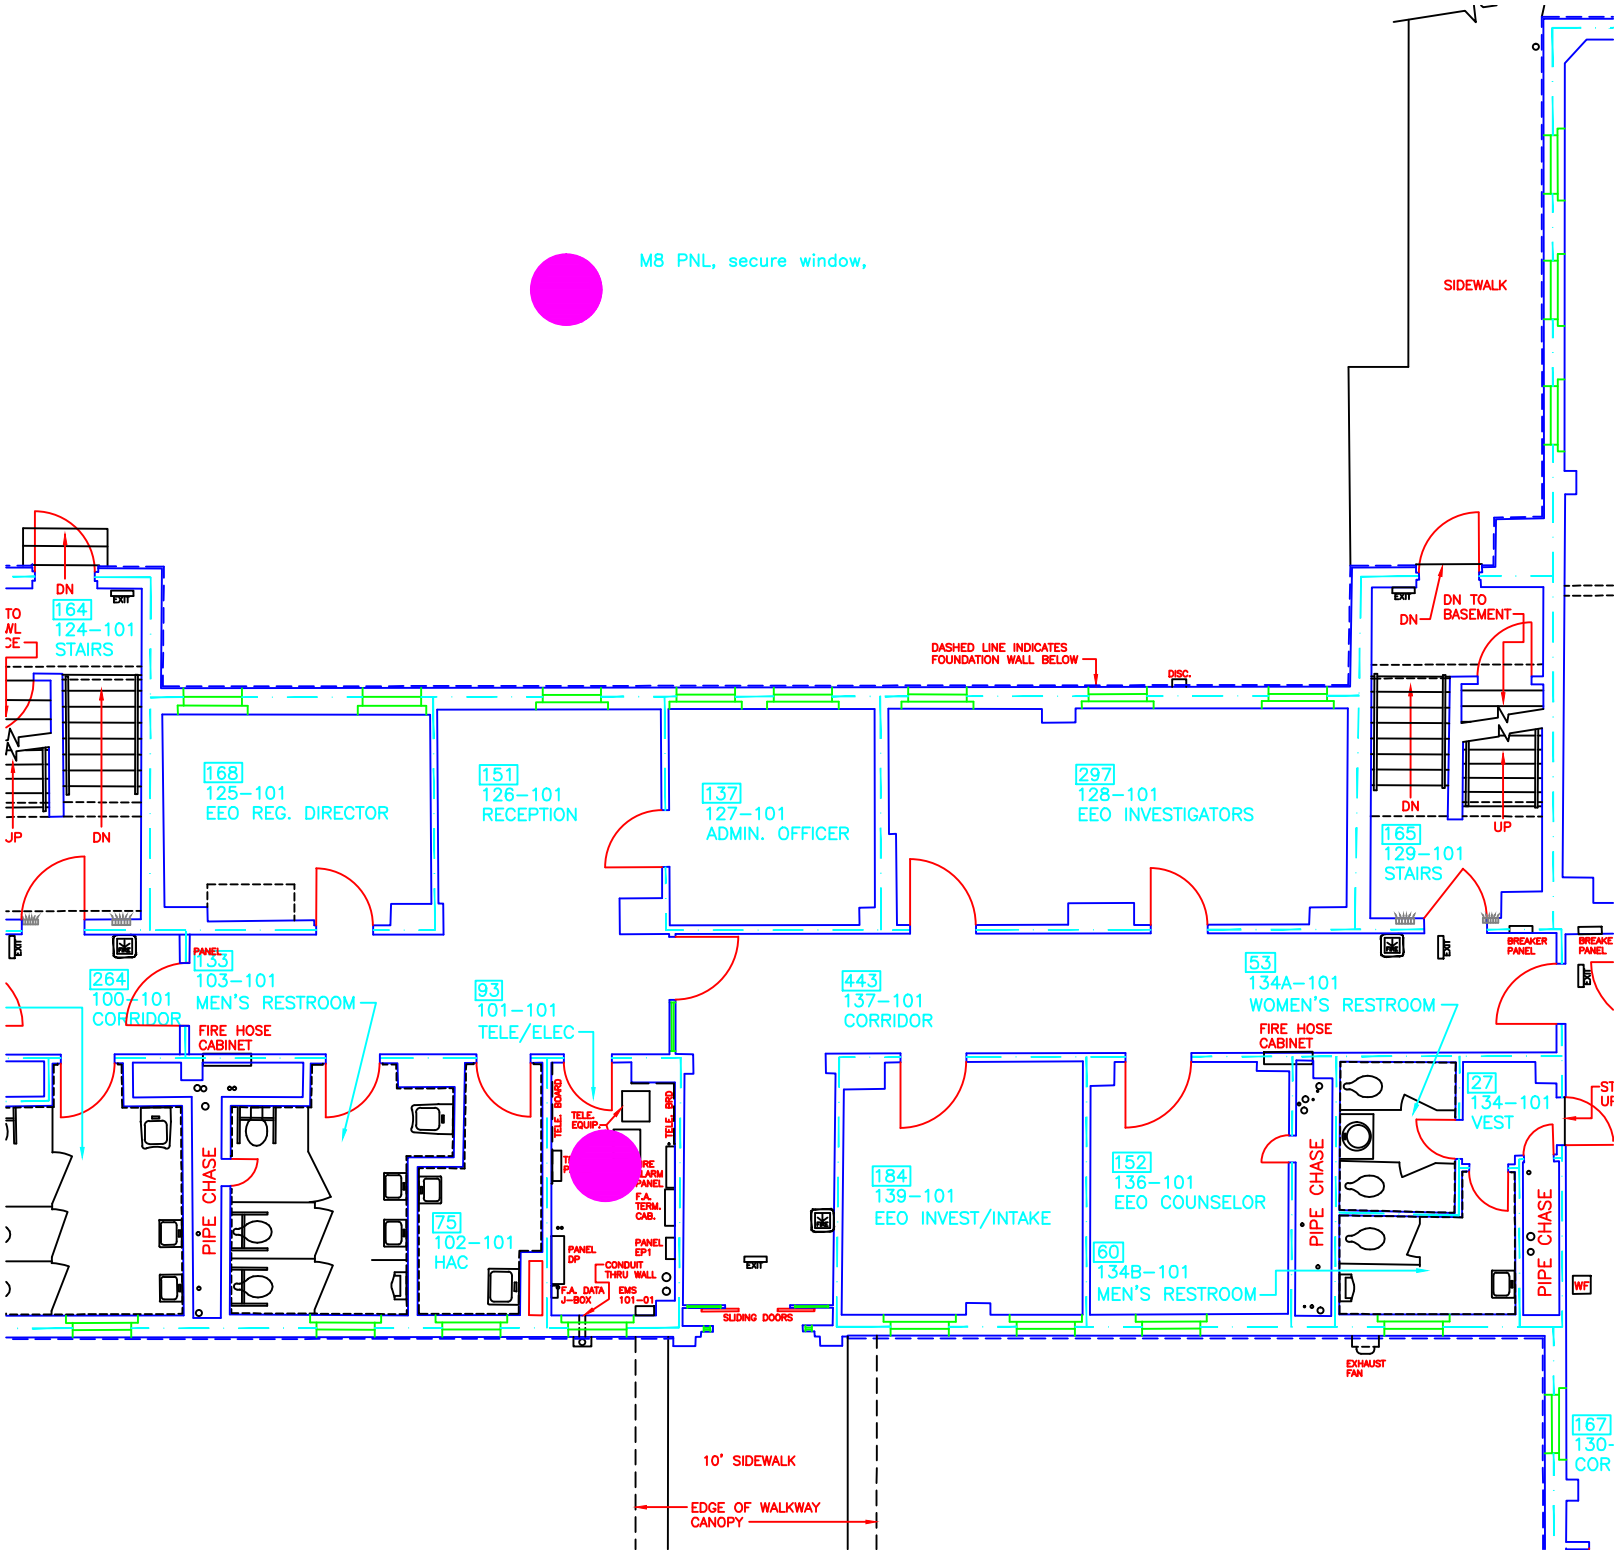
M8 PNL, secure window,
SIDEWALK
DN
164
124-101
STAIRS
EXIT
DN
UP
168
125-101
EEO REG. DIRECTOR
151
126-101
RECEPTION
137
127-101
ADMIN. OFFICER
297
128-101
EEO INVESTIGATORS
DASHED LINE INDICATES
FOUNDATION WALL BELOW
DISC.
DN TO
BASEMENT
DN
UP
165
129-101
STAIRS
BREAKER
PANEL
264
100-101
CORRIDOR
PANEL
133
103-101
MEN'S RESTROOM
FIRE HOSE
CABINET
PIPE CHASE
93
101-101
TELE/ELEC
TELE. BOARD
TELE. EQUIP.
FIRE ALARM PANEL
F.A. TERM. CAB.
PANEL EP1
PANEL DP
CONDUIT THRU WALL
F.A. DATA J-BOX
EMS 101-01
75
102-101
HAC
443
137-101
CORRIDOR
184
139-101
EEO INVEST/INTAKE
152
136-101
EEO COUNSELOR
60
134B-101
MEN'S RESTROOM
53
134A-101
WOMEN'S RESTROOM
FIRE HOSE
CABINET
27
134-101
VEST
WF
SLIDING DOORS
EXHAUST
FAN
10' SIDEWALK
EDGE OF WALKWAY
CANOPY
167
130-
COR