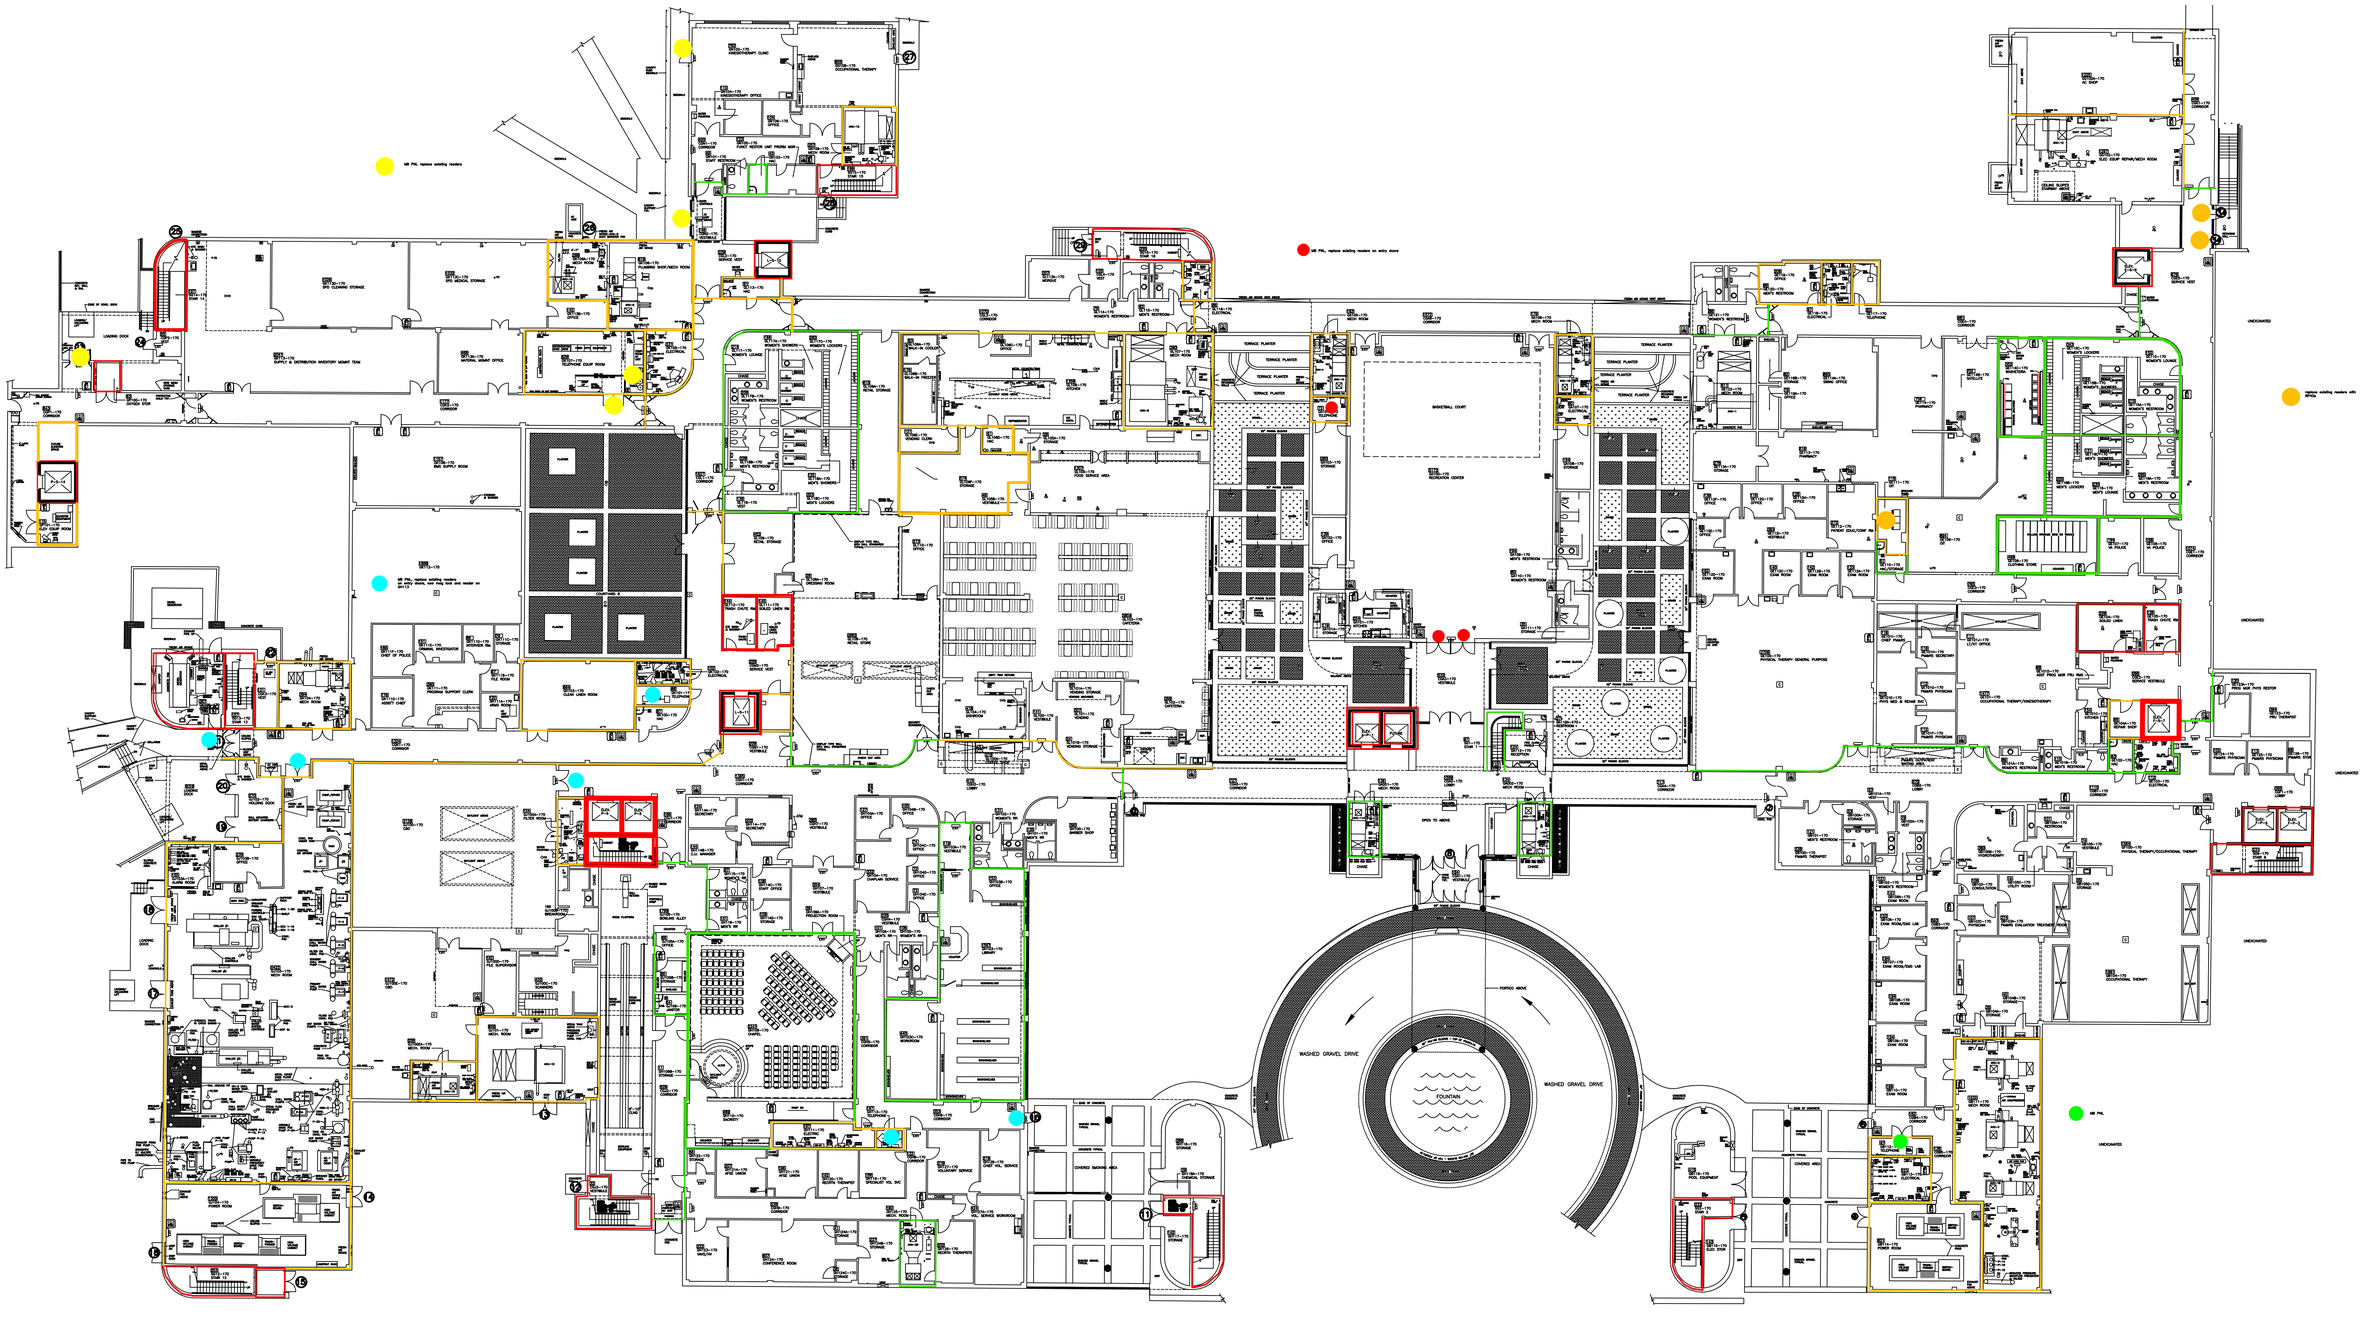
WASHED GRAVEL DRIVE
FOUNTAIN
WASHED GRAVEL DRIVE
PORTICO ABOVE
OPEN TO ABOVE
BASKETBALL COURT
UNDEDICATED
UNDEDICATED
UNDEDICATED
UNDEDICATED