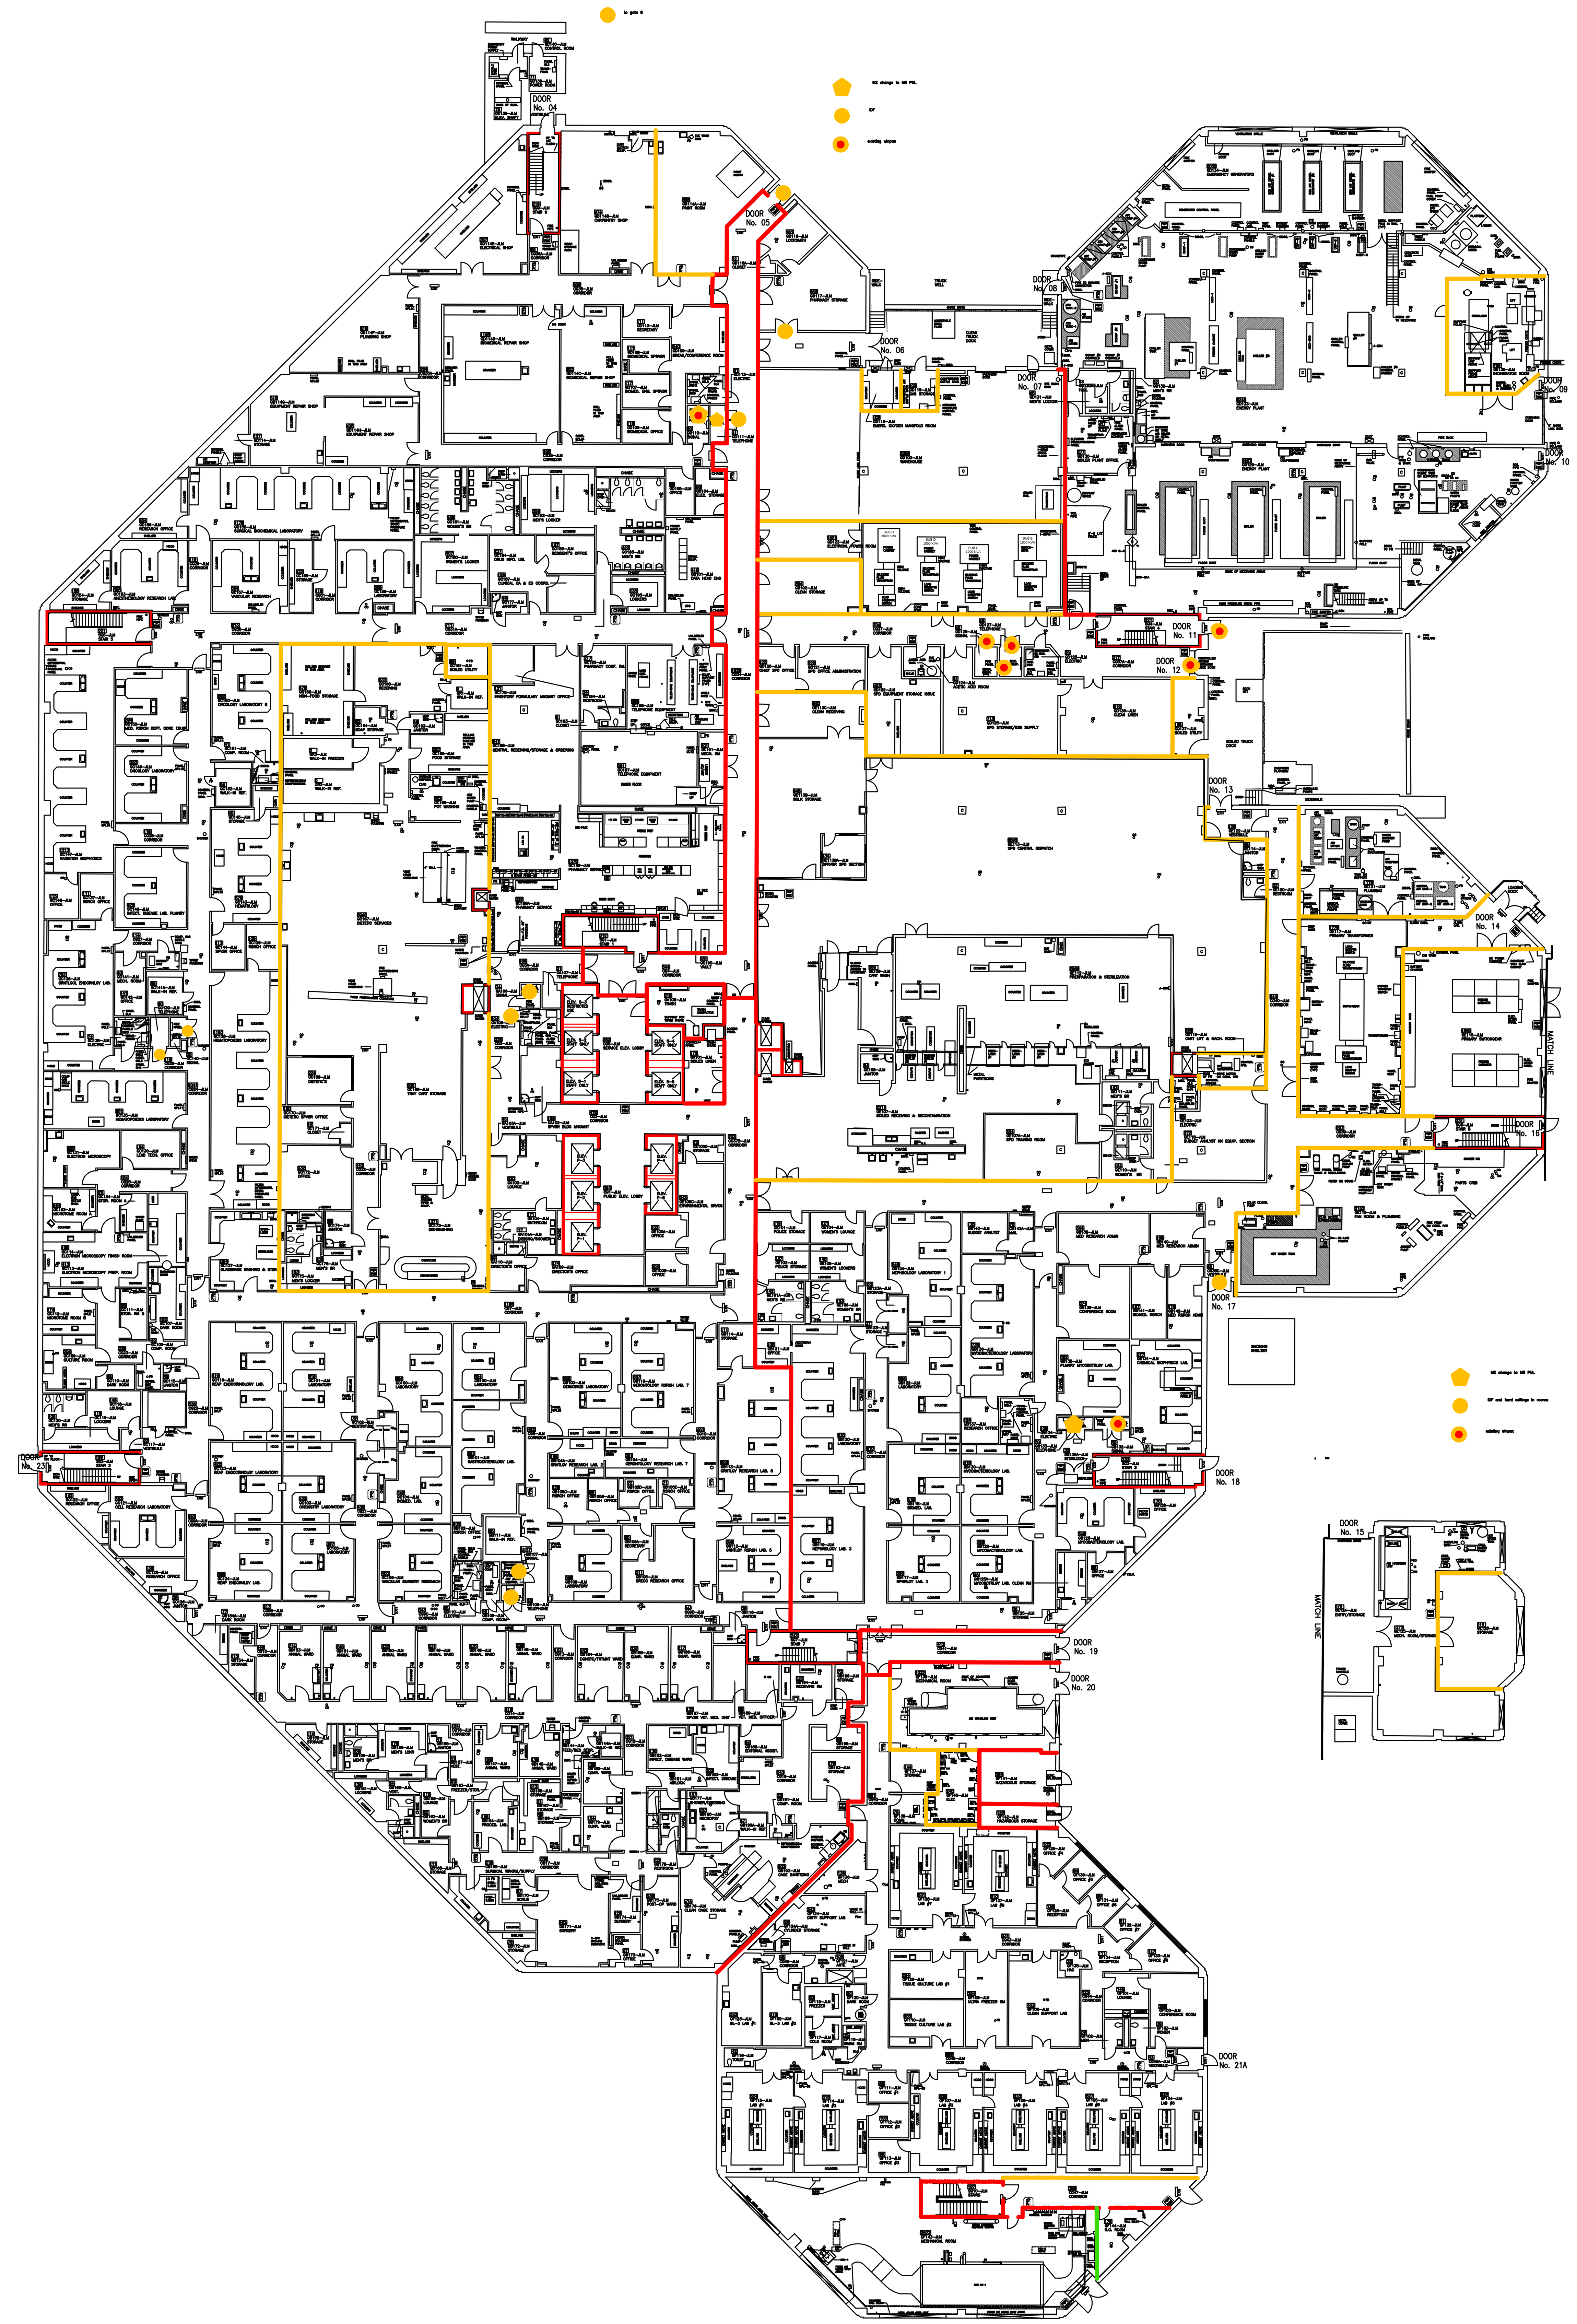
to gate 6
M2 change to M3 PNL
IDF
existing sleeve
DOOR No. 04
DOOR No. 05
DOOR No. 06
DOOR No. 07
DOOR No. 08
DOOR No. 09
DOOR No. 10
DOOR No. 11
DOOR No. 12
DOOR No. 13
DOOR No. 14
DOOR No. 15
DOOR No. 16
DOOR No. 17
DOOR No. 18
DOOR No. 19
DOOR No. 20
DOOR No. 21A
DOOR No. 23
MATCH LINE
M2 change to M3 PNL
IDF and hard ceilings in rooms
existing sleeves