


OFS BRANDS



OFS FirstOffice Carolina Loewenstein Highmark

		List Price	Qty	Total List Price
1	MM-182433BC2 - ? - ? - ? - NL - VK - Q3	\$1,016	1	\$1,016
BASE 2 DRAWER 18w x 24.25d x 33h. EXTERIOR-STANDARD TFL LAMINATE DR/DWR COLOR-STANDARD TFL LAMINATE. DR/DWR EDGE-STANDARD 3MM PVC. NO LOCK (NL). PULL OPTION-ERA SATIN NICKEL (VK). DRAWER LINER-NONE (Q3).				
		List Price	Qty	Total List Price
2	MM-1521SB - B5X	\$153	1	\$153
SUPPORT BRACKETS COLOR - STANDARD COLOR				
		List Price	Qty	Total List Price
3	MM-4224TWBL- ? - ? - X9 - X9 - X9 - X9 - X9	\$390	1	\$390
HPL LAMINATE TOP 42w x 24.5d x 5h LAMINATE COLOR-UNKNOWN. EDGE COLOR-UNKNOWN. FINISHED EDGE-NONE (X9). SIDE SPLASH-NONE (X9). SINK OPTION-NONE (X9). FAUCET OPTION-NONE (X9). WASTE RING-NONE (X9).				
TOTAL				\$1,559

VITAL ROOM

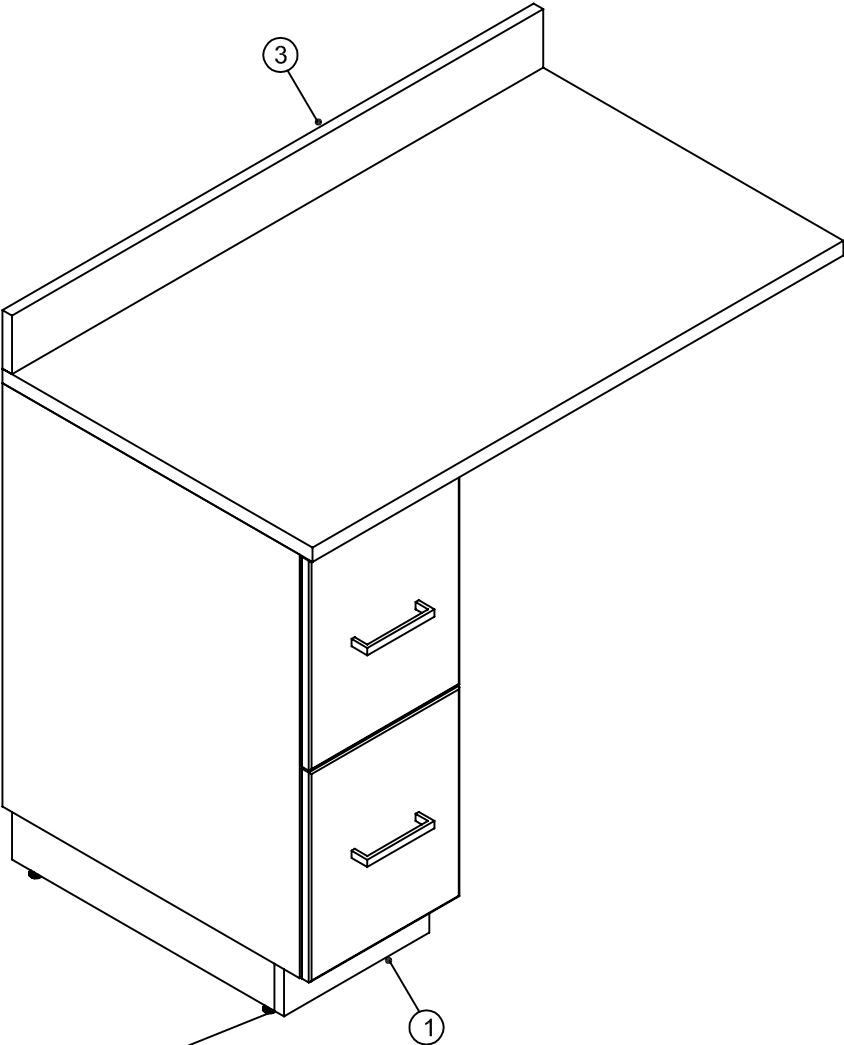

COVE MOLDING IS SUPPLIED AND INSTALLED BY OWNER..

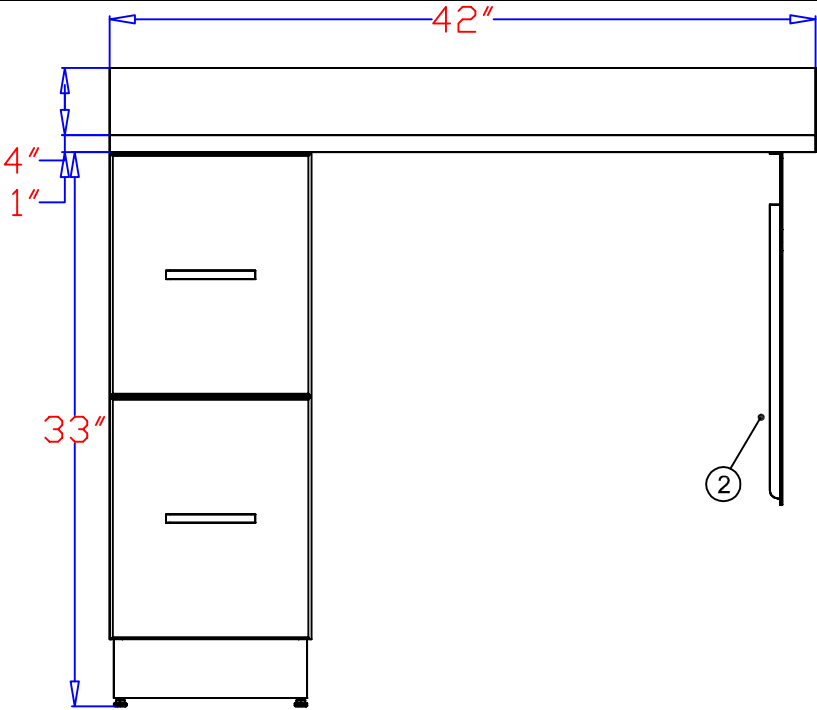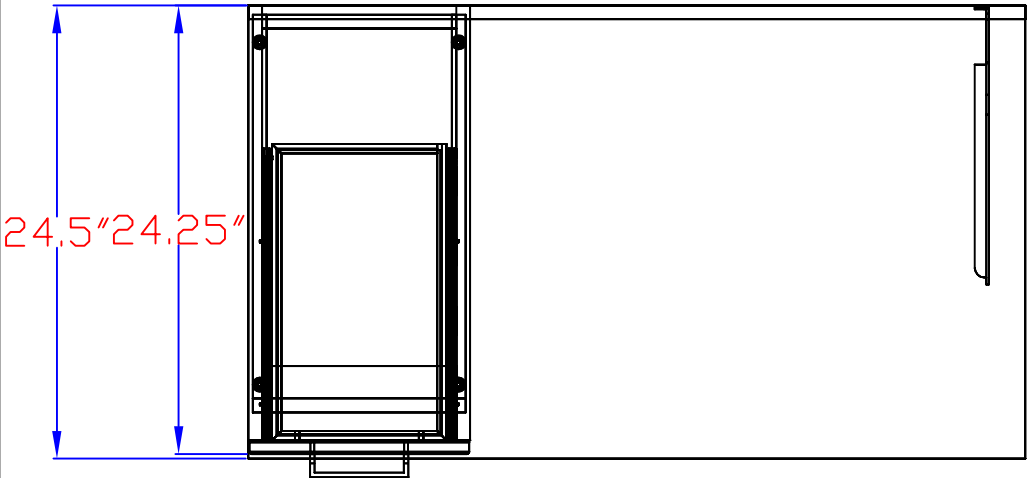

OFS BRANDS

OFS FirstOffice Carolina Loewenstein Highmark

CONCEPT ONLY

Special Req #: 352940

Item #:

Series: MILE MARKER

Tag:

Dwg #: 0442JJ-1

Desc:

Date: 3/23/17 Drawn By: J_JOCHUM

OFS BRANDS

OFS FirstOffice Carolina Loewenstein Highmark

		List Price	Qty	Total List Price
1	(SPECIAL) MM-847699	\$1,435	1	\$1,435
	BASE MEDIA CABINET MAGAZINE 20w x 24.25d x 33h EXTERIOR-STANDARD TFL LAMINATE INTERIOR-EXTERIOR MATCHING (B4A). 3 DVD/MAGAZINE RAILS.			
2	MM-362433BCD - ? - B4A - ? - ? - R8 - B3G - NL - VK	\$927	2	\$1,854
	BASE 2 DOOR 36w x 24.25d x 33h. EXTERIOR-STANDARD TFL LAMINATE INTERIOR-EXTERIOR MATCHING (B4A). DR/DWR COLOR-STANDARD TFL LAMINATE. DR/DWR EDGE-STANDARD 3MM PVC. SHELF OPTION-ADJ. SHELF (R8). HINGE-EURO 120 (B3G). NO LOCK (NL). PULL OPTION-ERA SATIN NICKEL (VK).			
	These should be replaced with a 2 or 3 High File cabinet.			
3	(SPECIAL) MM-847565	\$875	1	\$875
	MILE MARKER SERIES BASE 1 DOOR 20w x 24.25d x 33h EXTERIOR-STANDARD TFL LAMINATE INTERIOR-EXTERIOR MATCHING (B4A). DR/DWR COLOR-STANDARD TFL LAMINATE. DR/DWR EDGE-STANDARD 3MM PVC. SHELF OPTION-ADJ. SHELF (R8). HINGE LOCATION RIGHT (B3L). HINGE-EURO 120 (B3G). NO LOCK (NL). PULL OPTION-ERA SATIN NICKEL (VK).			
	These should be replaced with a 2 or 3 High File cabinet.			
4	(SPECIAL) MM-847567	\$848	1	\$848
	HPL LAMINATE TOP 112w x 24.5d x 5h LAMINATE COLOR-UNKNOWN. EDGE COLOR-UNKNOWN. FINISHED EDGE-NONE (X9). SIDE SPLASH-NONE (X9). SINK OPTION-NONE (X9). FAUCET OPTION-NONE (X9). WASTE RING-NONE (X9). FIELD CUT BACK SPLASH.			
5	(SPECIAL) MM-847701	\$1,535	1	\$1,535
	UPPER MEDIA CABINET MAGAZINE SLOPED 20w x 14d x 54.7999h EXTERIOR-STANDARD TFL LAMINATE INTERIOR-EXTERIOR MATCHING (B4A). 4 DVD/MAGAZINE RAILS.			
6	MM-361435UCLS-?-BA4-/-/X9-NL-VK	\$1,114	2	\$2,228


UPPER LIFT DOORS SLOPED 36w x 14d x 35h

EXTERIOR-STANDARD TFL LAMINATE
INTERIOR-EXTERIOR MATCHING (B4A).
DR/DWR COLOR-STANDARD TFL LAMINATE.
DR/DWR EDGE-STANDARD 3MM PVC.
SHELF OPTION-NONE (X9).
NO LOCK (NL).
PULL OPTION-ERA SATIN NICKEL (VK).



	List Price	Qty	Total List Price
(SPECIAL) MM-847569	\$1,016	1	\$1,016
MILE MARKER UPPER LIFT DOORS SLOPED 20w x 14d x 35h			
EXTERIOR-STANDARD TFL LAMINATE INTERIOR-EXTERIOR MATCHING (B4A). DR/DWR COLOR-STANDARD TFL LAMINATE. DR/DWR EDGE-STANDARD 3MM PVC. SHELF OPTION-NONE (X9). NO LOCK (NL). PULL OPTION-ERA SATIN NICKEL			

TOTAL \$9,791

LITERATURE AREA

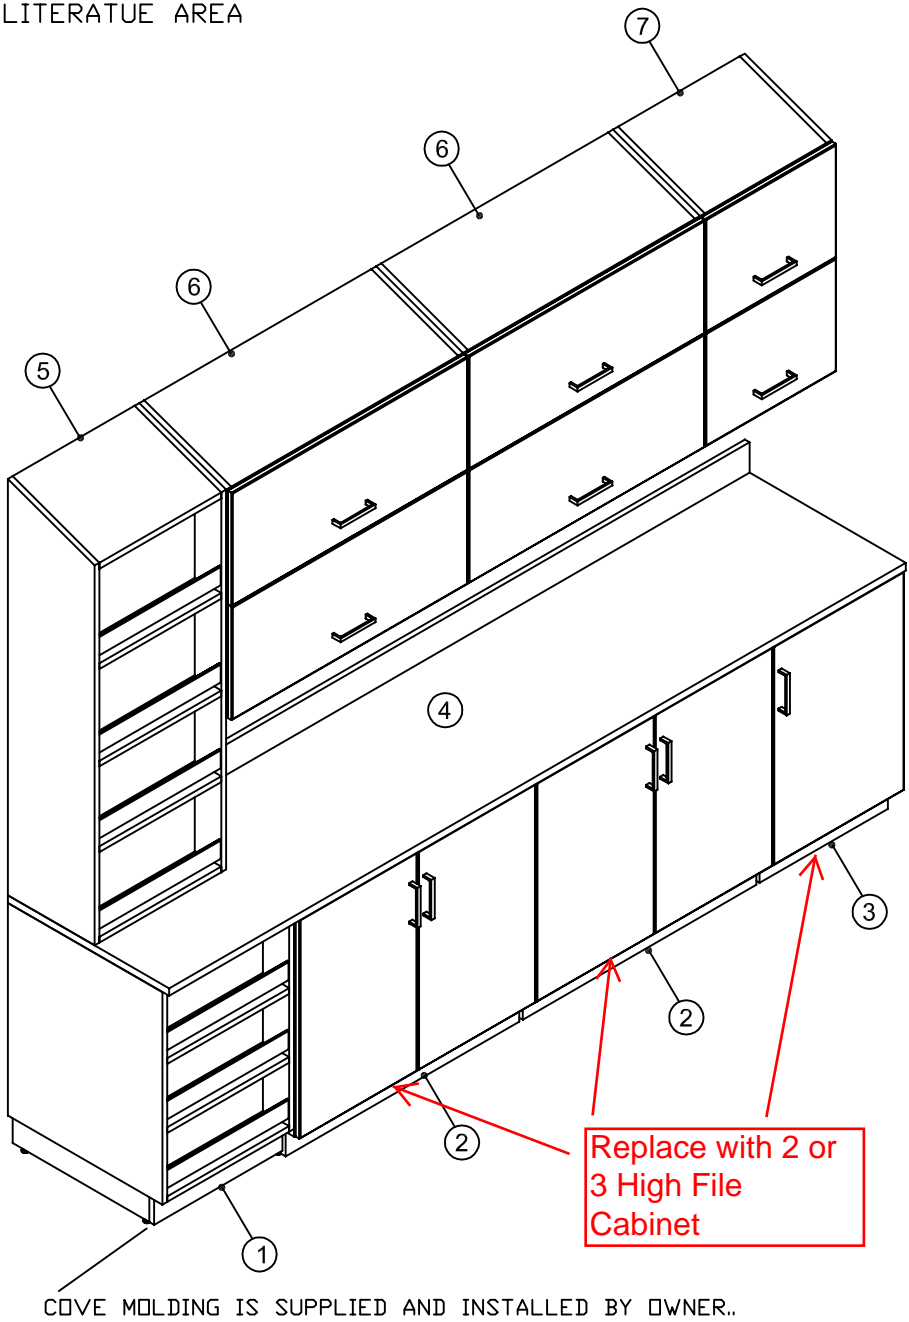

COVE MOLDING IS SUPPLIED AND INSTALLED BY OWNER..

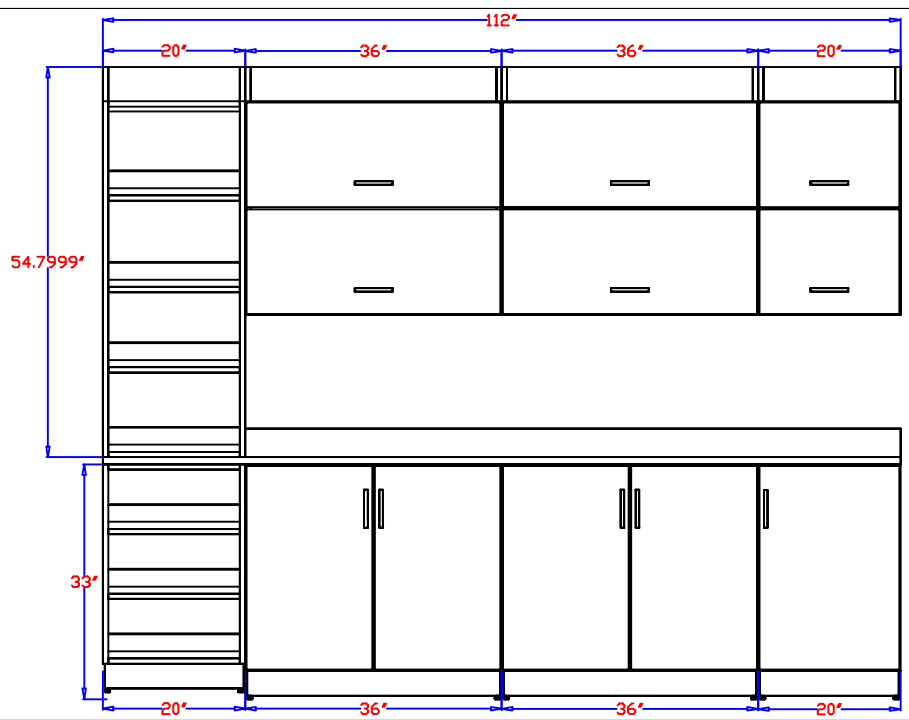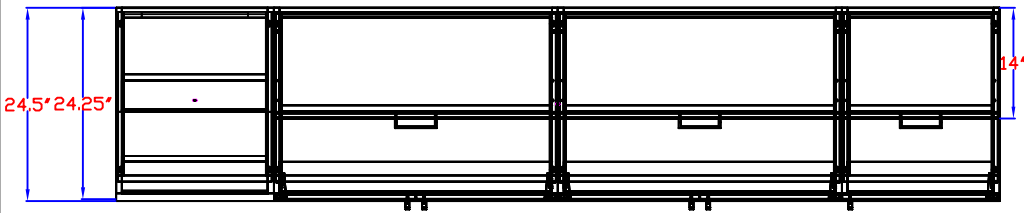

OFS BRANDS

OFS FirstOffice Carolina Loewenstein Highmark

CONCEPT ONLY

Special Req #: 352940		Dwg #: 0442JJ-2	
Item #:		Desc:	
Series: MILE MARKER	Tag:	Date: 3/23/17	Drawn By: J_JOCHUM