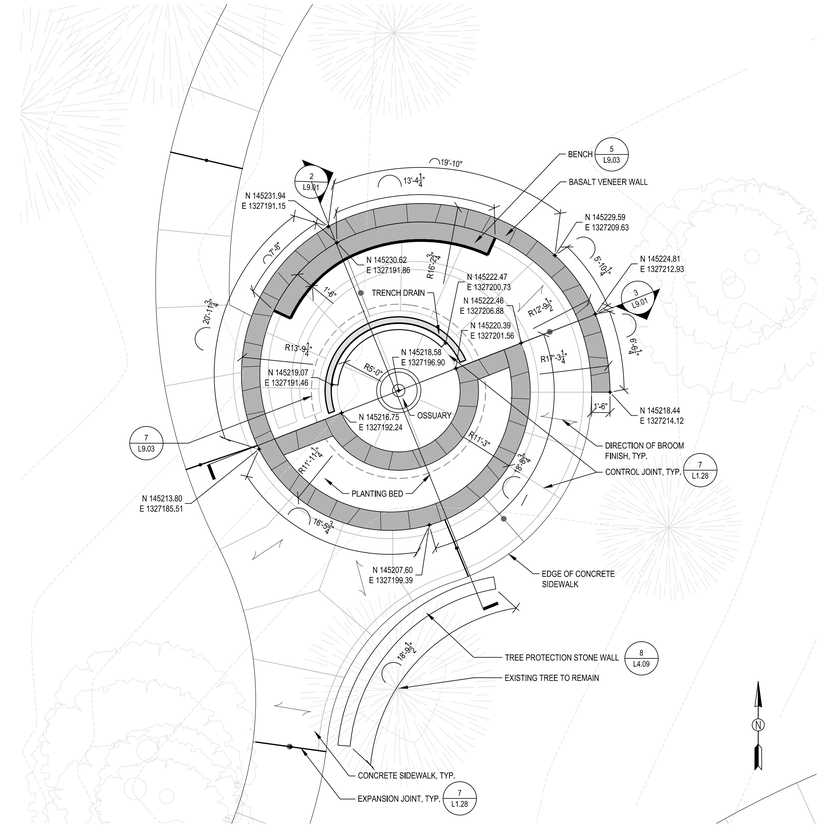

1 L9.01 OSSUARY ENLARGEMENT PLAN — 1" = 5'-0"

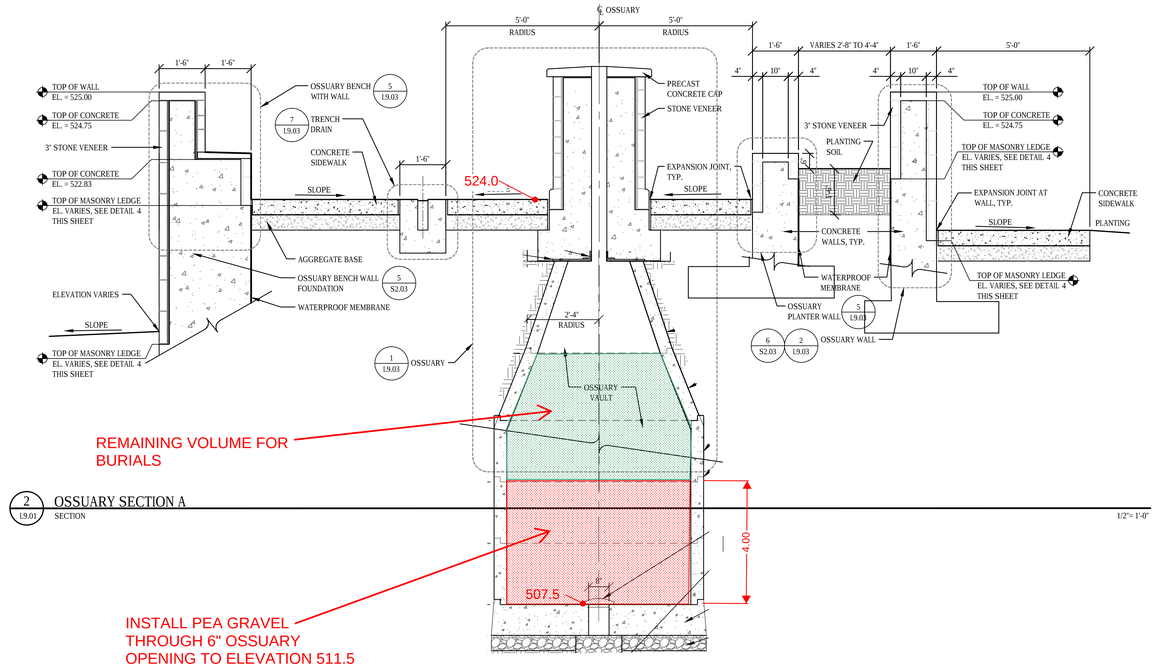

2 L9.01 OSSUARY SECTION A — SECTION — 1/2" = 1'-0"

OPTION D - FILL WITH PEA GRAVEL TO HIGH WATER MARK

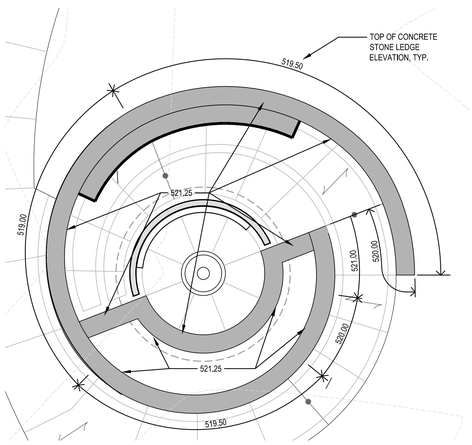

4 L9.01 STONE LEDGE ELEVATIONS — PLAN — 1" = 5'-0"

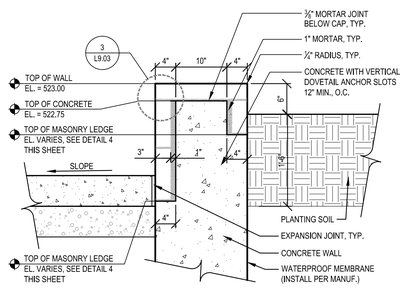

5 L9.01 OSSUARY PLANTER WALL — SECTION — 1" = 1'-0"

Revisions	Date

CONSULTANTS:

Anderson Engineering of Minnesota, LLC
13605 1st AVENUE NORTH, SUITE 100, PLYMOUTH, MN 55441
TEL (763) 412-4000 FAX (763) 412-4090

Aqua Engineering, Inc.
Innovative Water Solutions
4803 Innovation Drive
Fort Collins, Colorado 80525
Phone (970) 229-9668
FAX (970) 226-3855

JJR
landscape architecture planning urban design civil engineering environmental science
JJR, LLC
110 MILLER AVENUE,
ANN ARBOR, MICHIGAN 48104
734.662.4457 T 734.662.0779 F
www.jjr-us.com

RUSHING Engineering - Essentials - Delivery
BLACKBIRD

ALLEGIANCE GROUP, LLC

STATE OF MICHIGAN — HENRY L. BYMA — LANDSCAPE ARCHITECT — No. 1538 — REGISTERED LANDSCAPE ARCHITECT

ARCHITECT/ENGINEERS:

kpff Consulting Engineers
1601 Fifth Avenue, Suite 1600
Seattle, Washington 98101-3665
(206) 622-5822 Fax (206) 622-8130

Drawing Title: OSSUARY ENLARGED PLAN

Approved: Project Director

Project Title: TAHOMA NATIONAL CEMETERY
PHASE 2 GRAVESITE DEVELOPMENT
18600 SE 240TH STREET, KENT WASHINGTON

Location: KENT, WASHINGTON

Date: 9-15-2011 | Checked: CG/PE | Drawn: JS/JM

Project Number: 919PC2007

Drawing Reference Number: 142

Drawing Number: L9.01

Office of Construction and Facilities Management
Department of Veterans Affairs

VA FORM 08-6231

Sep 15, 2011 - 12:09am jmcfeyh
W:\ef Filenames \ ACAD-X \ TNC2-TB_3DV42 \ X-TNC2-TB_3DV42 \ X-TNC2-FD \ SURVEY \ X-TNC2-SV \ X-TNC2-SV+ \ X-TNC2-SV-PHT \ X-TNC2-CONST-PHT \
P:\2007710000\040\Sheet\A5077-CMBM-PHT.dwg
\ COLB-COMPONENTS \ LAYOUT \ X-TNC2-FG \ X-TNC2-SD \ COLB-4-LAYOUT \ COLB-5-LAYOUT \ COLB-3-LAYOUT \ 919BASE_CIVIL \ 919BASE_CIVIL \
\ LANDSCAPE \ Ossuary plaza section \
one eighth inch = one foot one quarter inch = one foot three quarters inch = one foot one inch = one foot one and one half inches = one foot three inches = one foot