


WHITNEY ST


Smoking Shelter #1
will be placed 8 feet
from sidewalk

Smoking Shelter #2
Placed 8 feet from
sidewalk

Smoking Shelter #3
4 feet from sidewalk

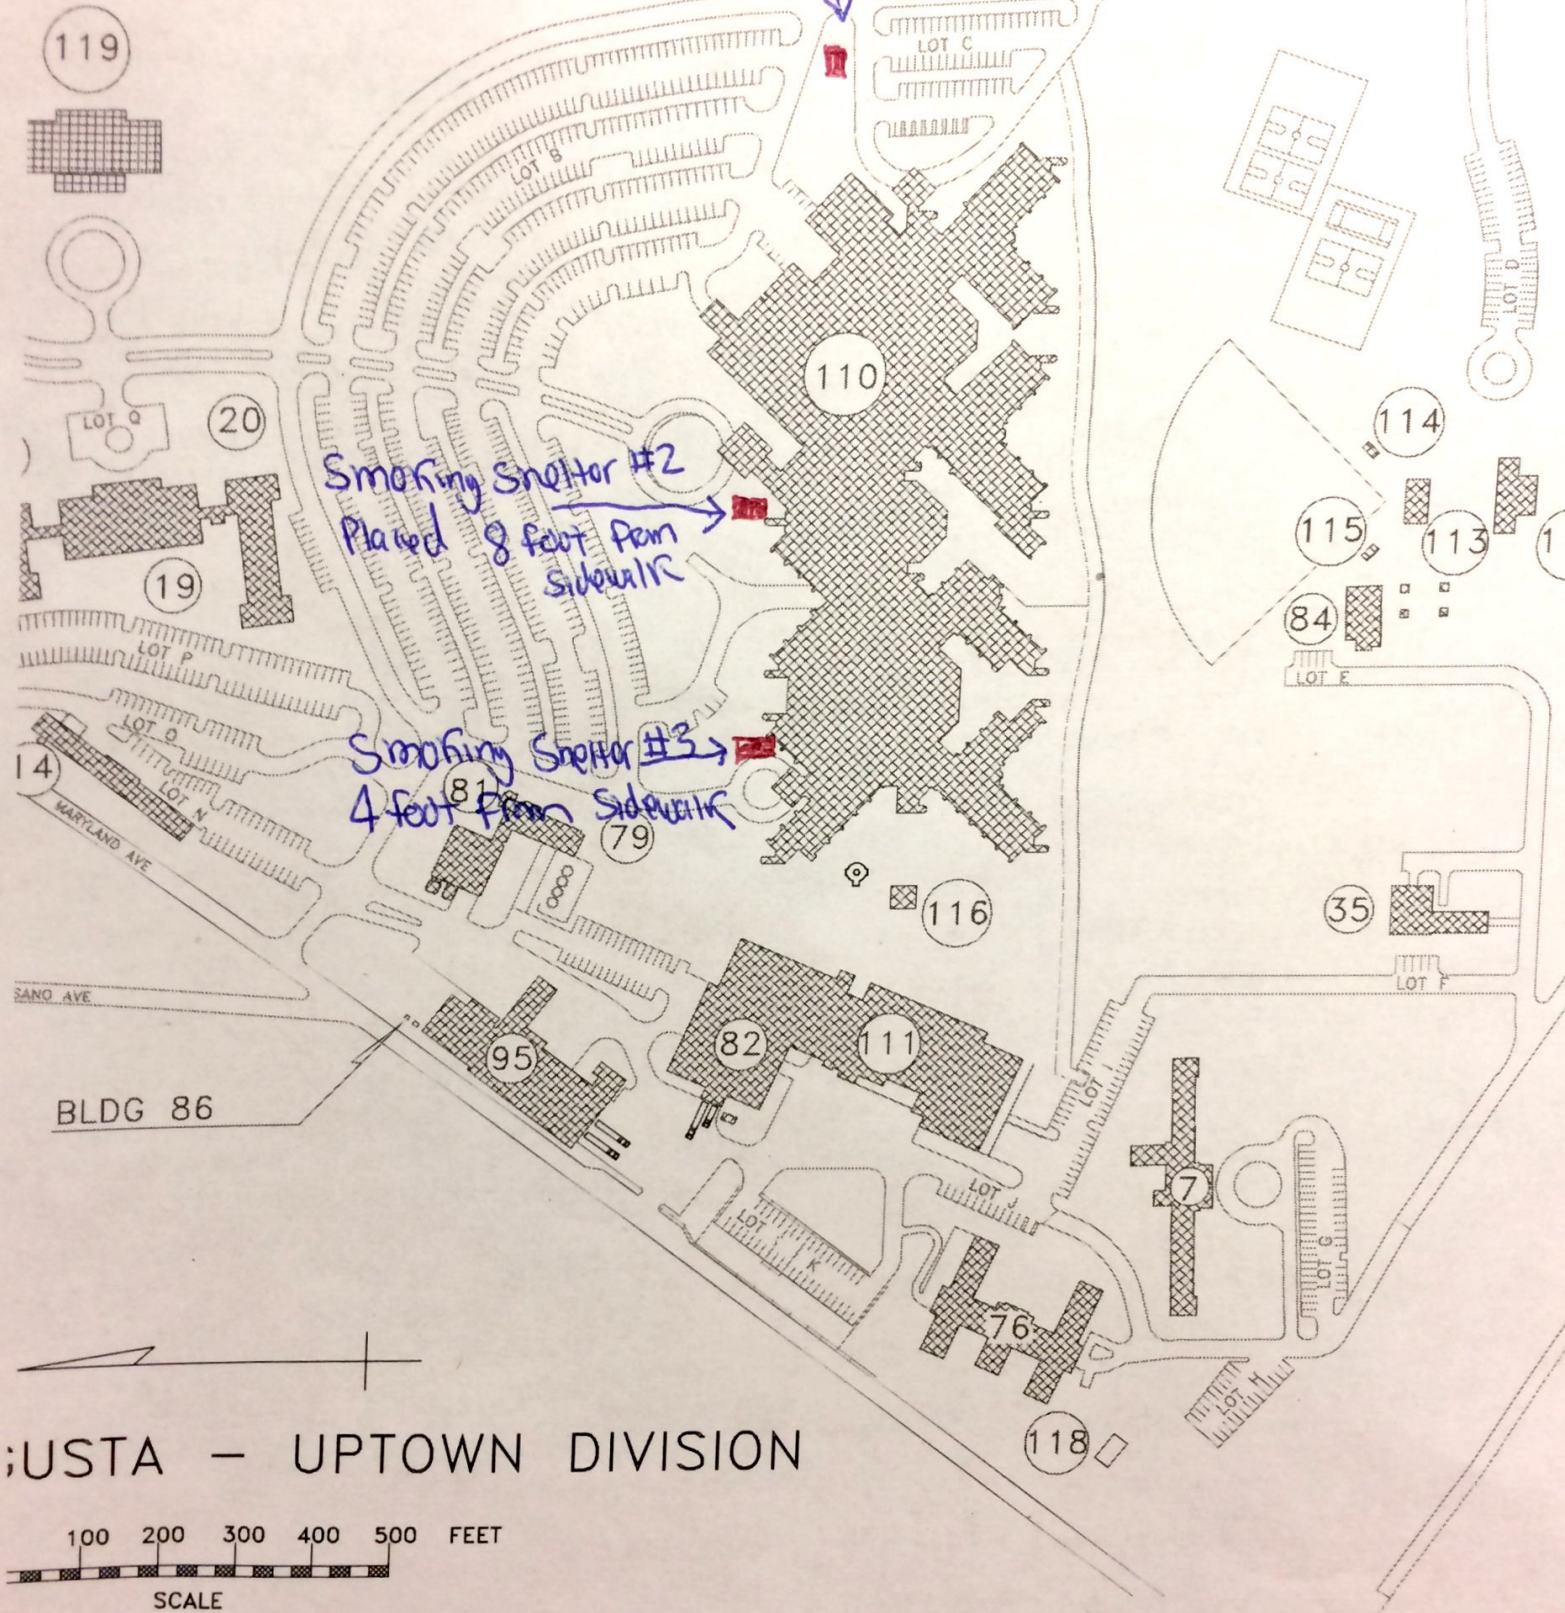

UST - UPTOWN DIVISION

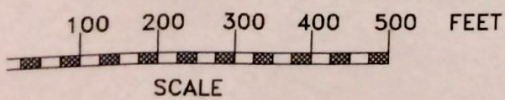

By: Recommended: Approved: