

A

B

C

D

E

F

A

B


C

D

E

F

three inches = one foot
one and one half inches = one foot
one inch = one foot
three quarters inch = one foot
one half inch = one foot
three eighths inch = one foot
one quarter inch = one foot
one eighth inch = one foot

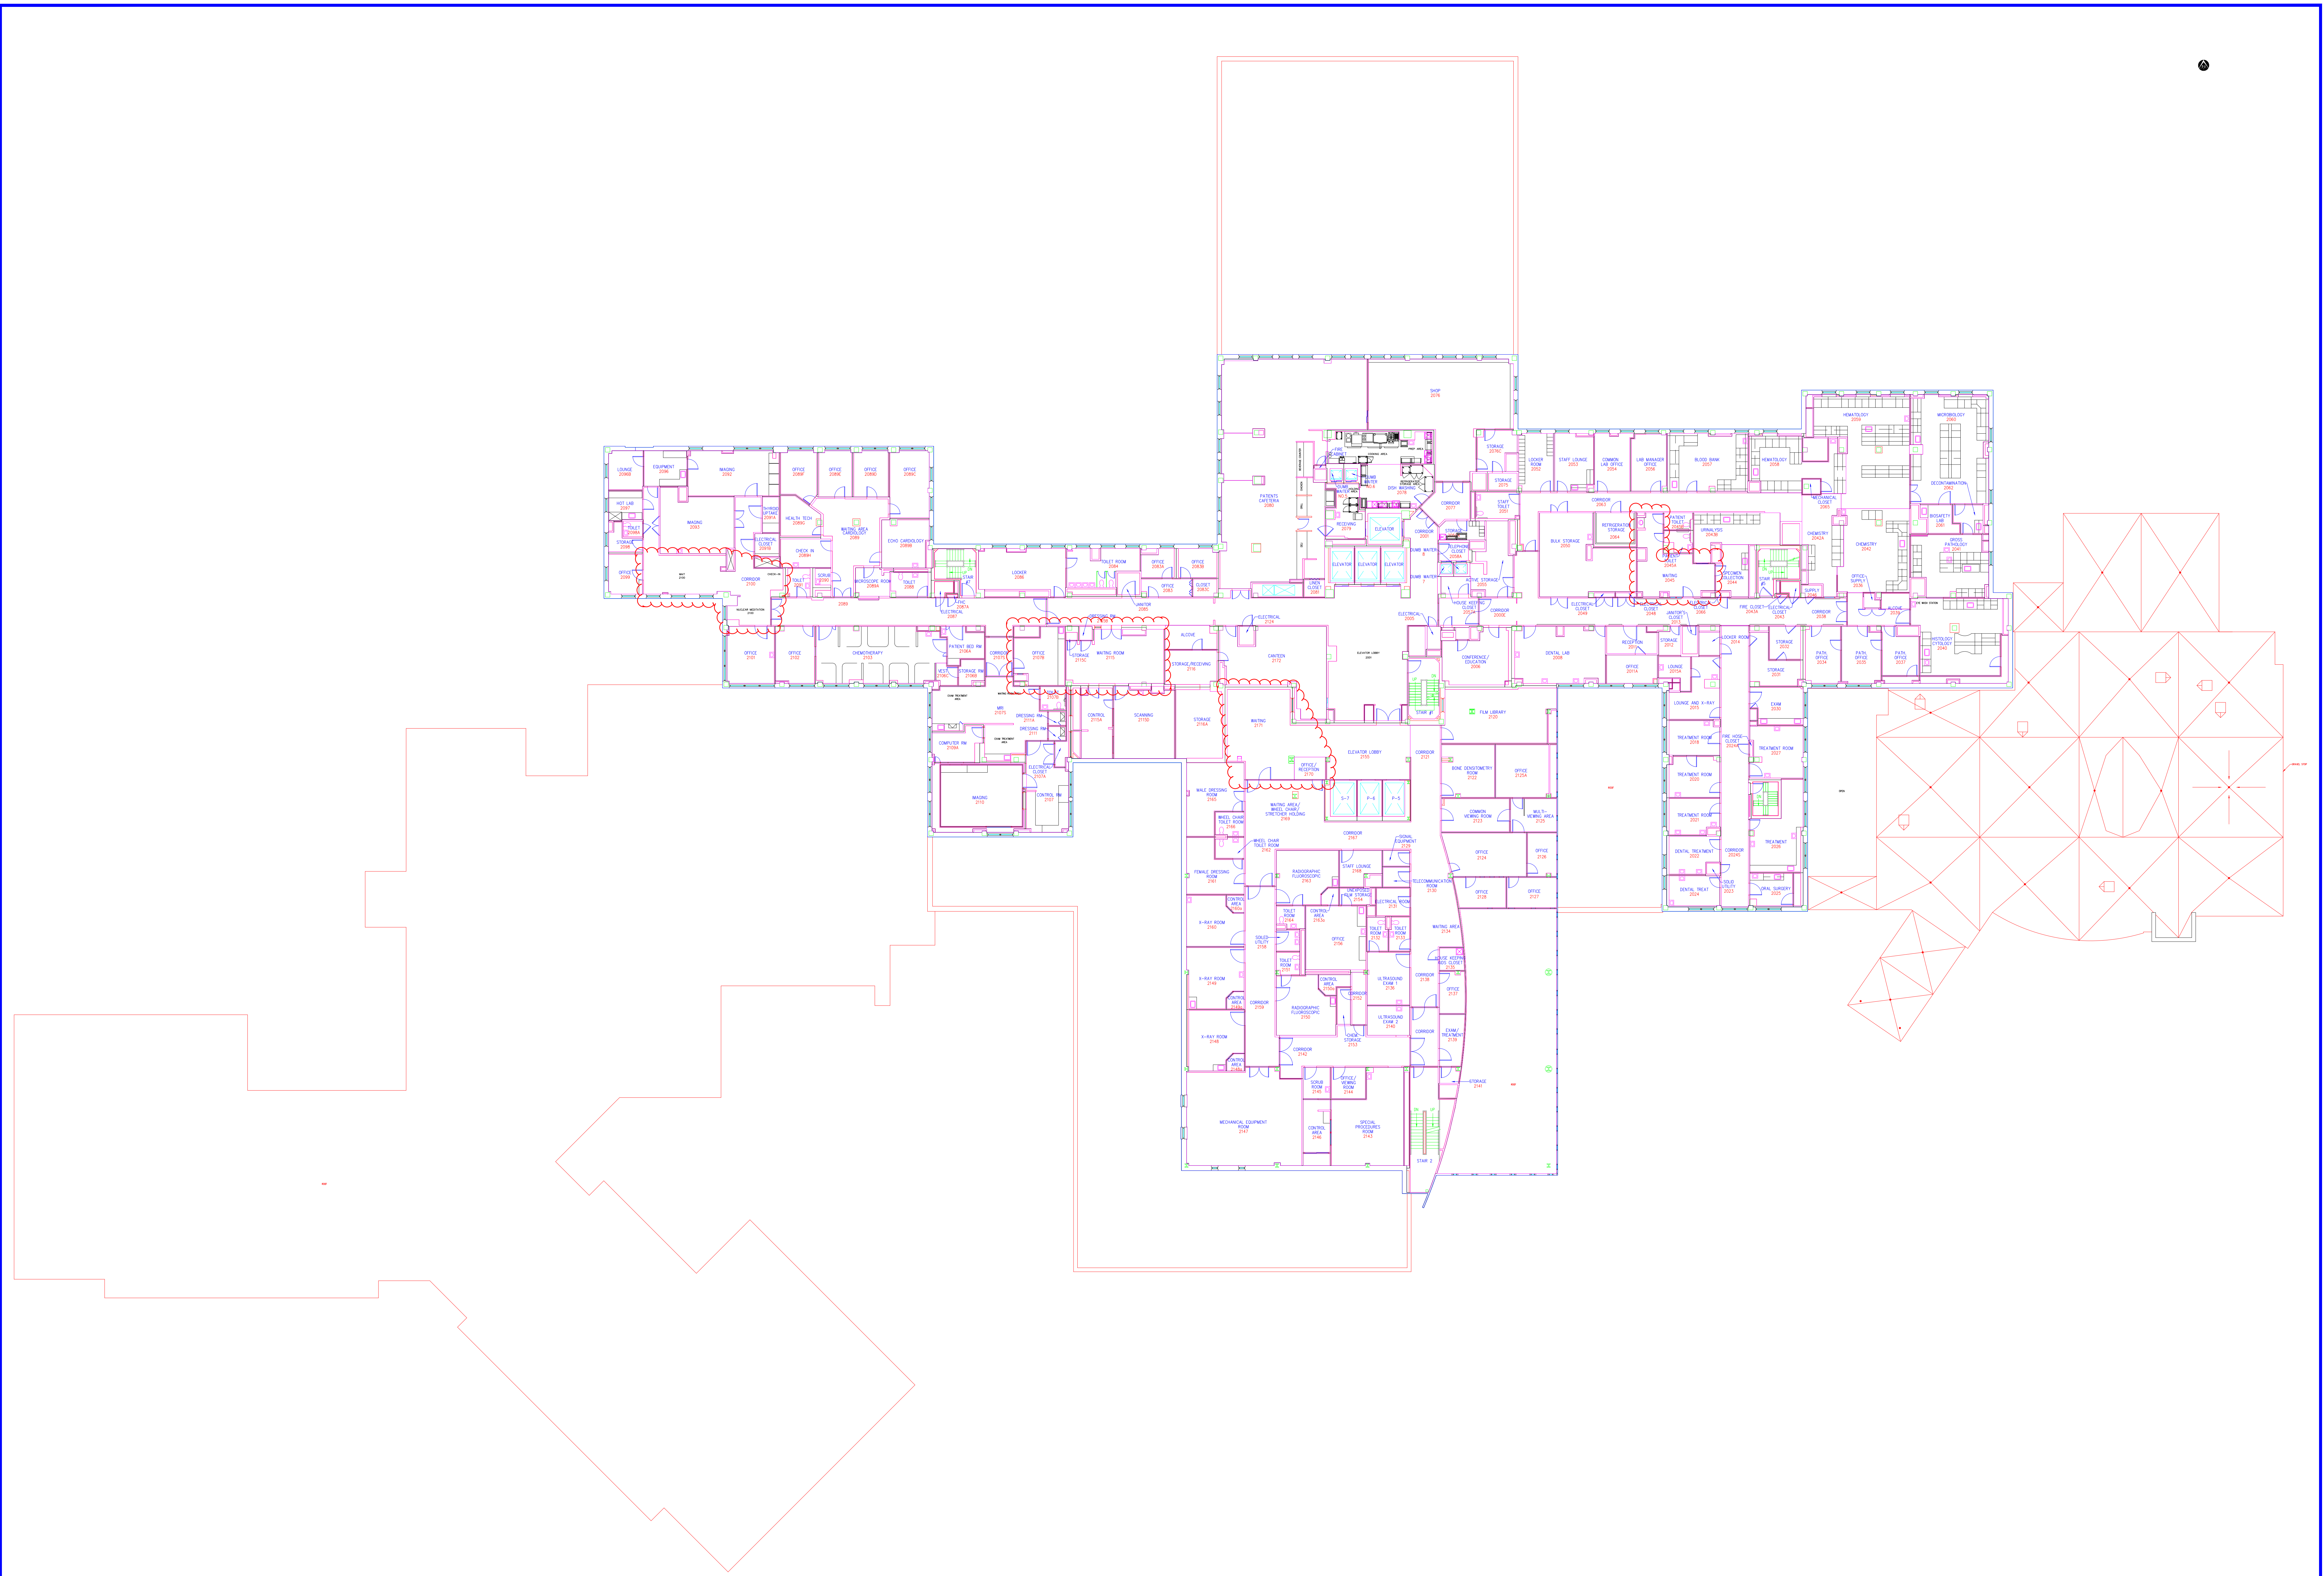

				<div><div></div><div>Indus Systems, Inc. 2352, Main Street, Concord MA 01742 Tel: 978-461-0555 www.indus-systems.com</div></div>	Drawing Title SECOND FLOOR PLAN ARCHITECTURAL		Project Title AS-BUILT Drawings		Date 10-25-2013	Project No.	<div><div></div></div>	VA Department of Veterans Affairs
					Site:		Building Number 01	Checked	Drawn			
Revisions		Date	Professional Seal		Approved:		Location VAMC WILMINGTON DELAWARE					