



Overall Facility Online

Clouded area shows the
area of work for this project

A	1	REVISION	
---	---	----------	--	--	

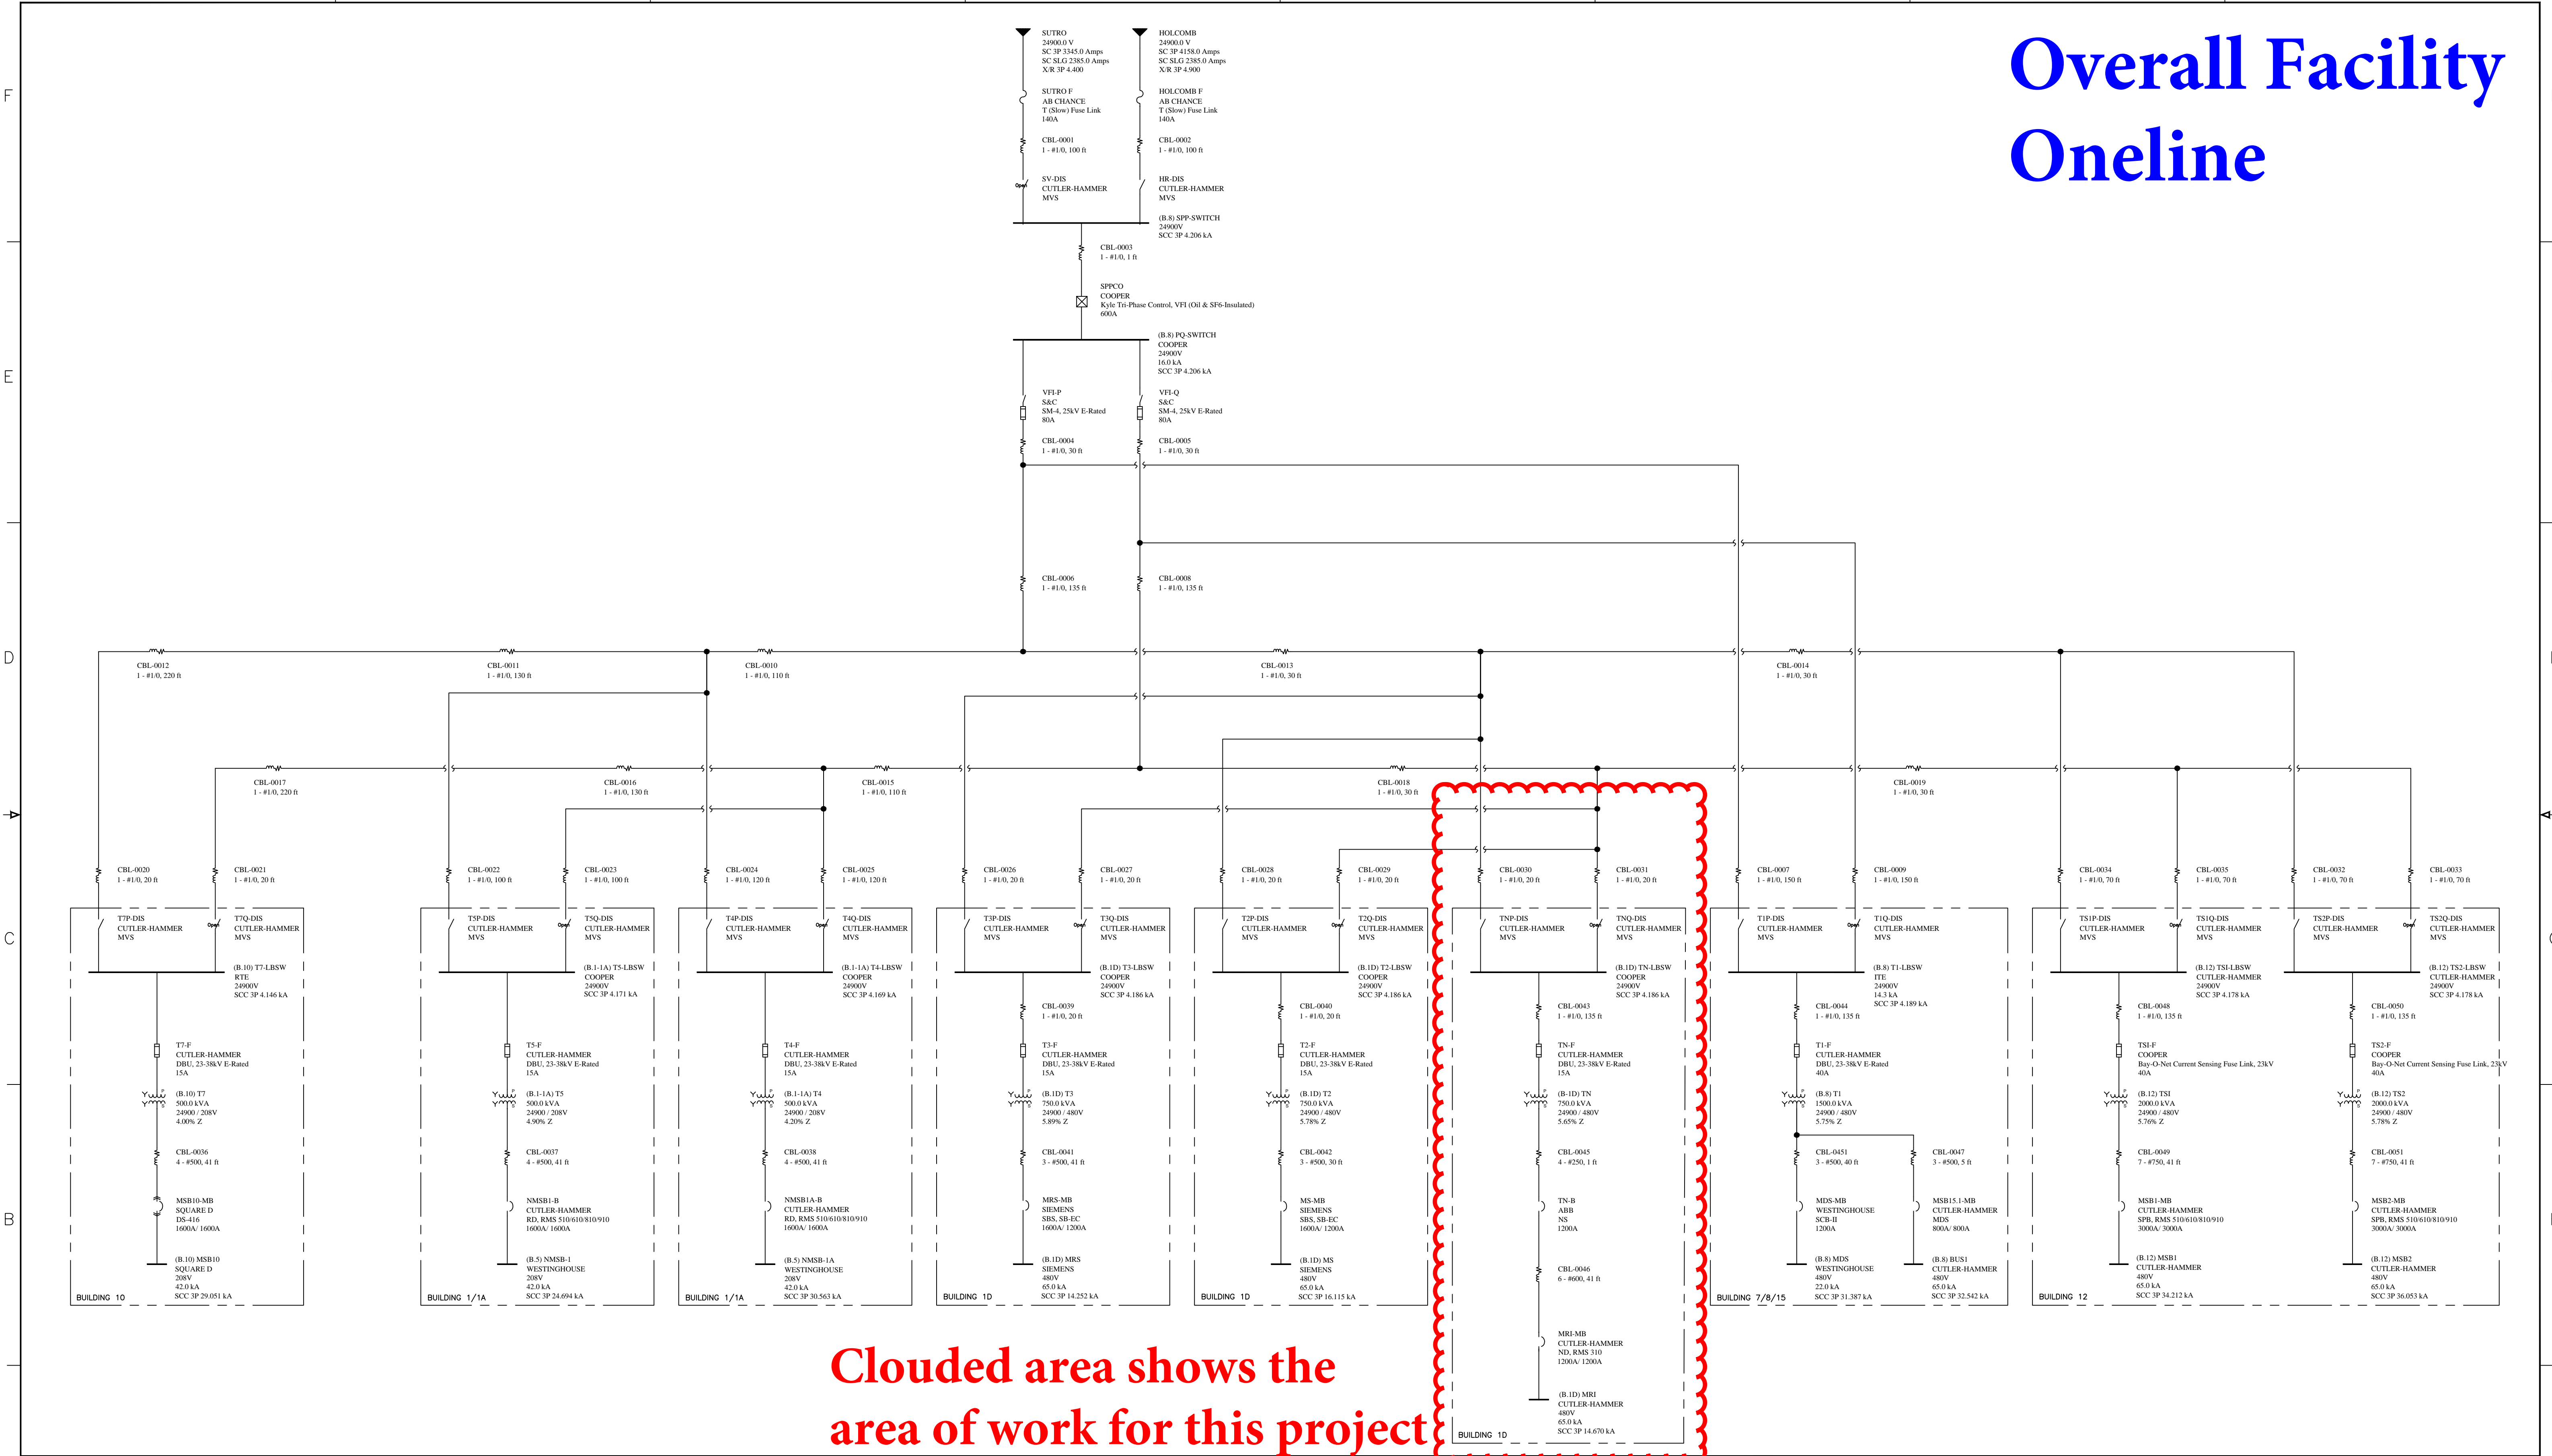

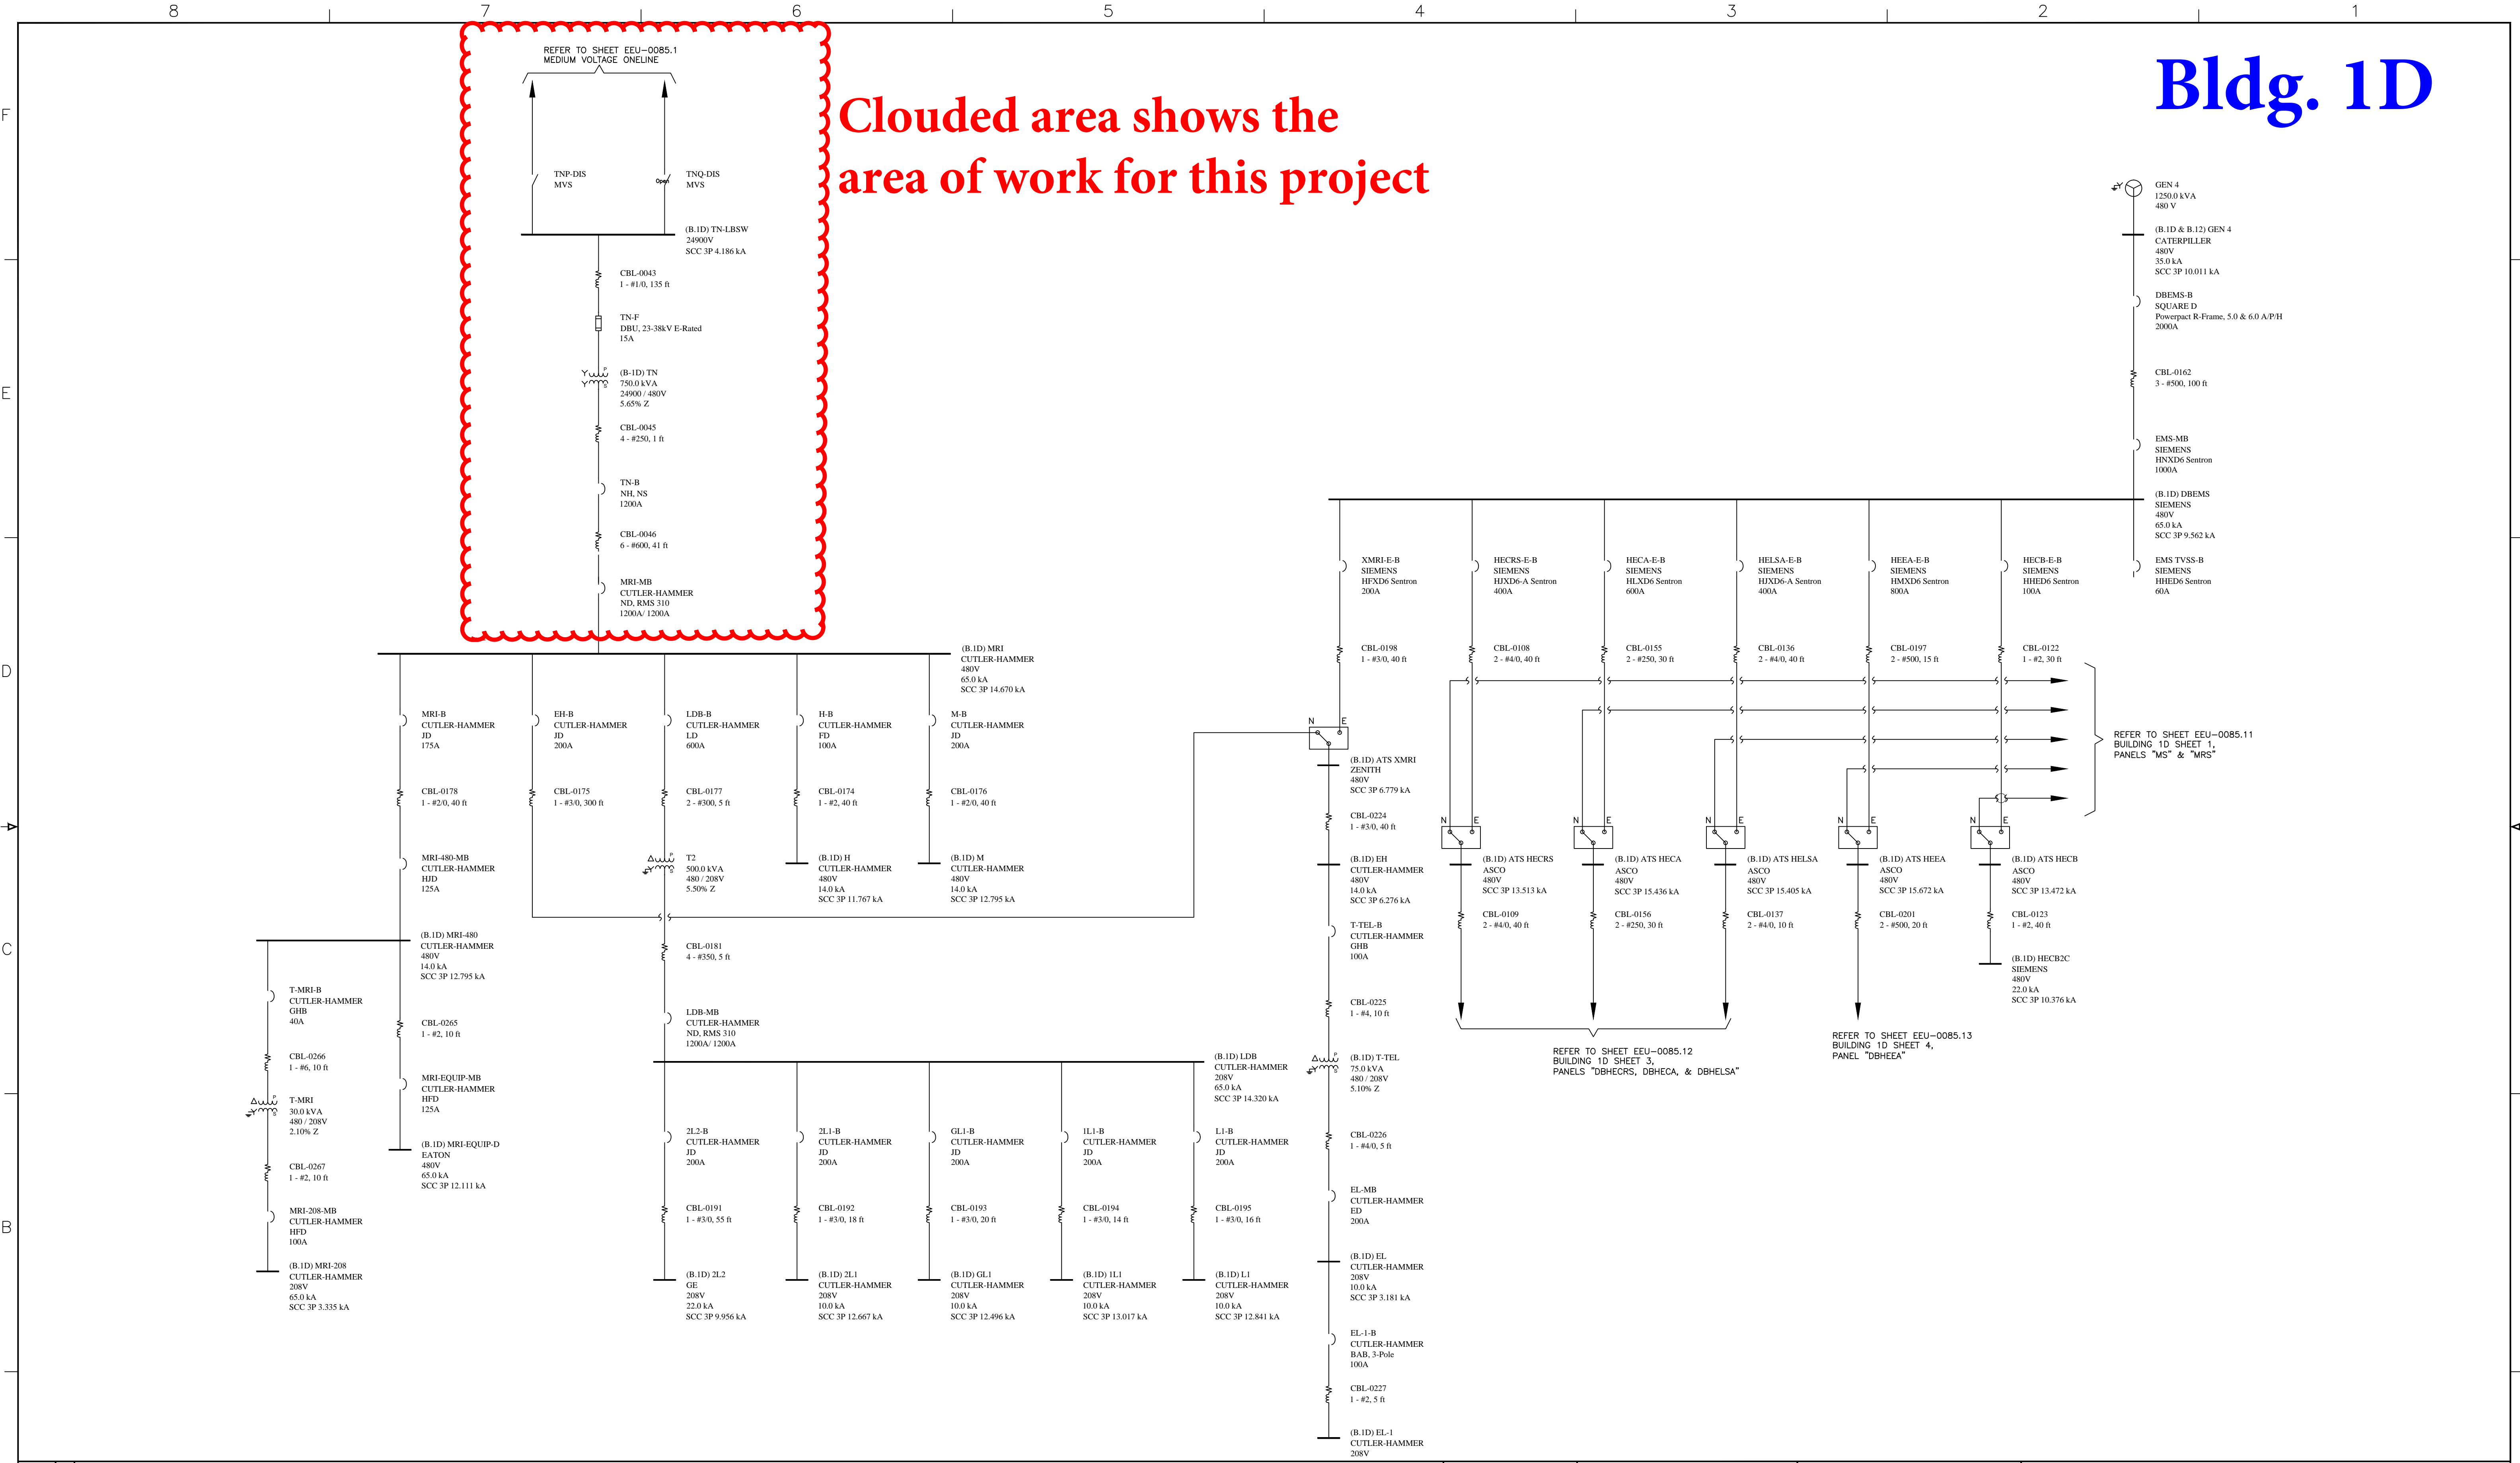

Bldg. 1D

Clouded area shows the
area of work for this project

A	1	REVISION	
---	---	----------	--	--	