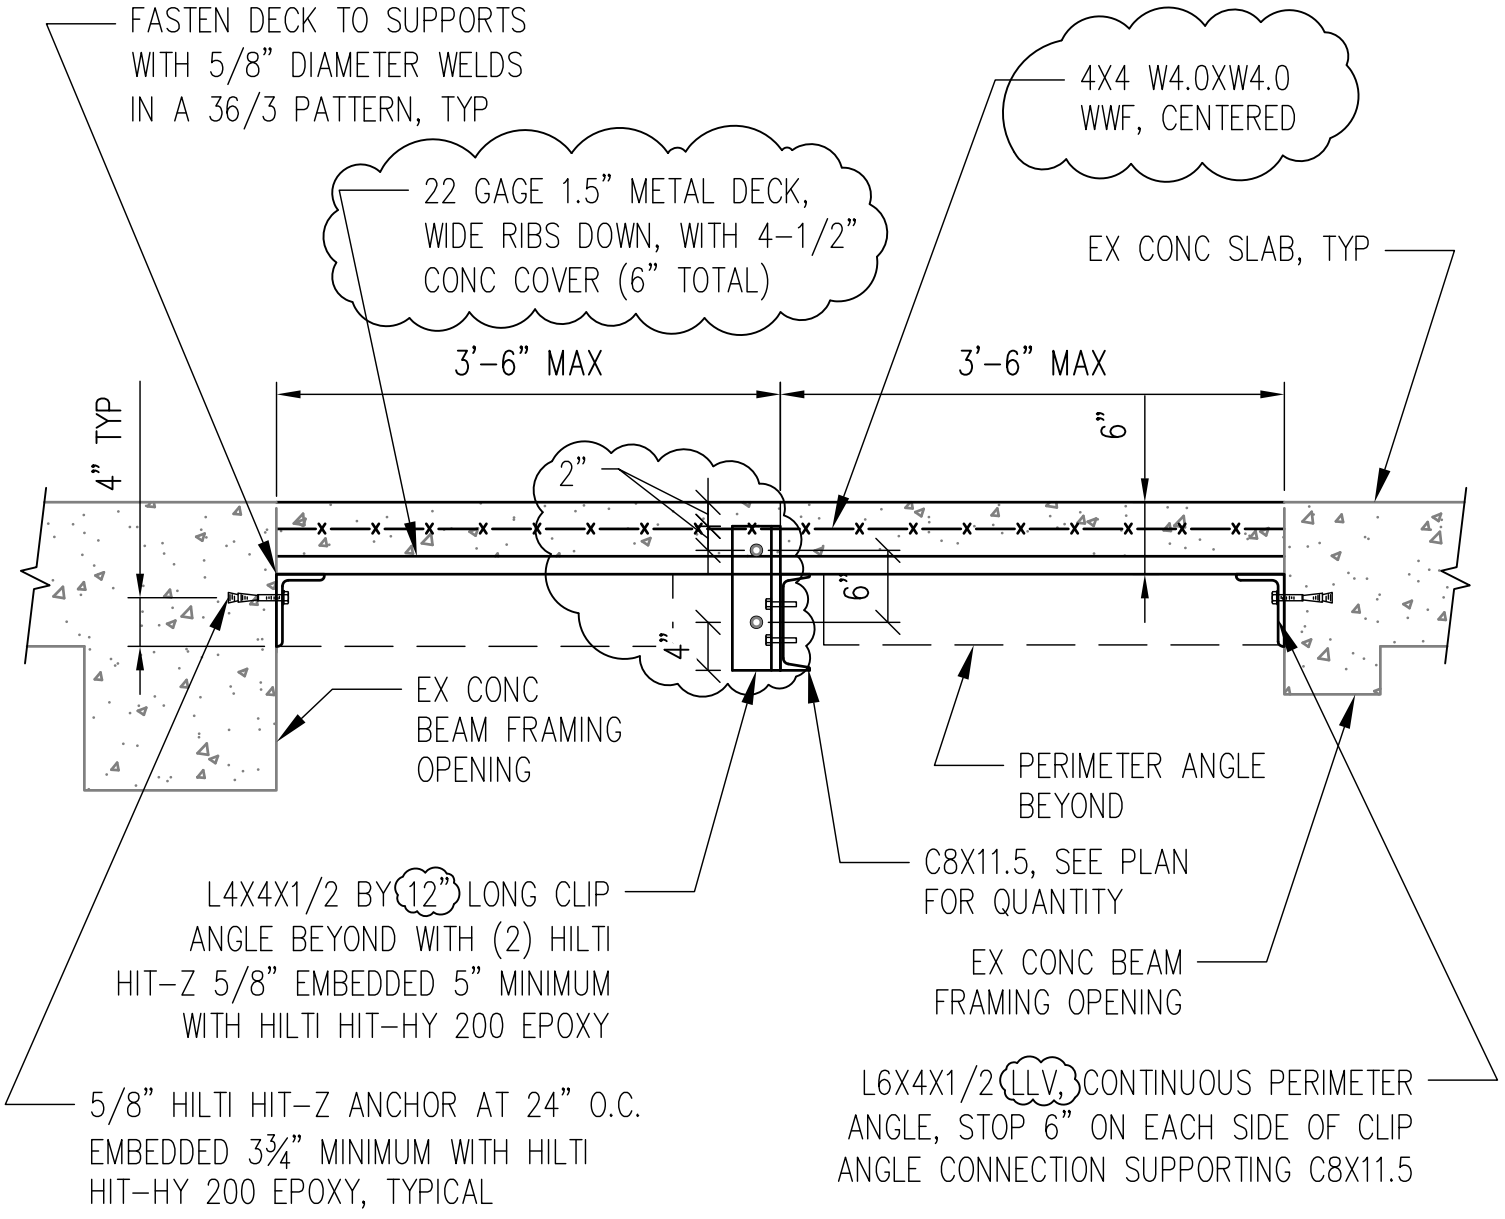

A SECTION

SF101 | SKS-1 SCALE: 1-1/2" = 1'-0"

NOTES:

1. ALL STEEL AND DECKING TO BE SPRAYED WITH FIREPROOFING. REFER TO ARCH AND/OR FIRE PROTECTION DRAWINGS FOR MORE INFO.
2. INFILL TO BE USED AT LEVEL SHOWN AND UPPER LEVEL WHERE DUMBWAITER IS REMOVED.

CHANGES TO SECTION A ON SS303 ARE CLOUDED AS PART OF SKS-1. NO OTHER CHANGES ARE BEING MADE TO THE DRAWINGS AS PART OF THIS SKETCH.

08-15-17

EBA Ernest Bland Associates Architecture and Planning
802 Sligo Ave, Silver Spring MD 20910

Addendum No. 1

SPS RENOVATION

VAMC - Washington, DC

SKS-1