
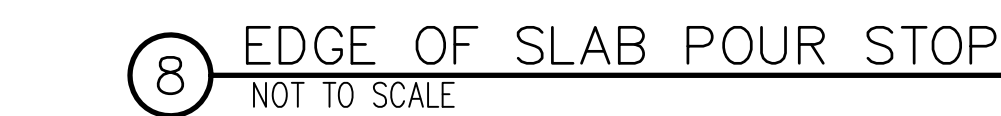



NOTE: ALL STEEL TO BE HOT DIP GALVANIZED

BASEPLATE FOR MEP EQ  
ACCU-1 INTERMEDIATE COLUMN  
NOT TO SCALE


3 ACCU-1 DUNNAGE  
NOT TO SCALE

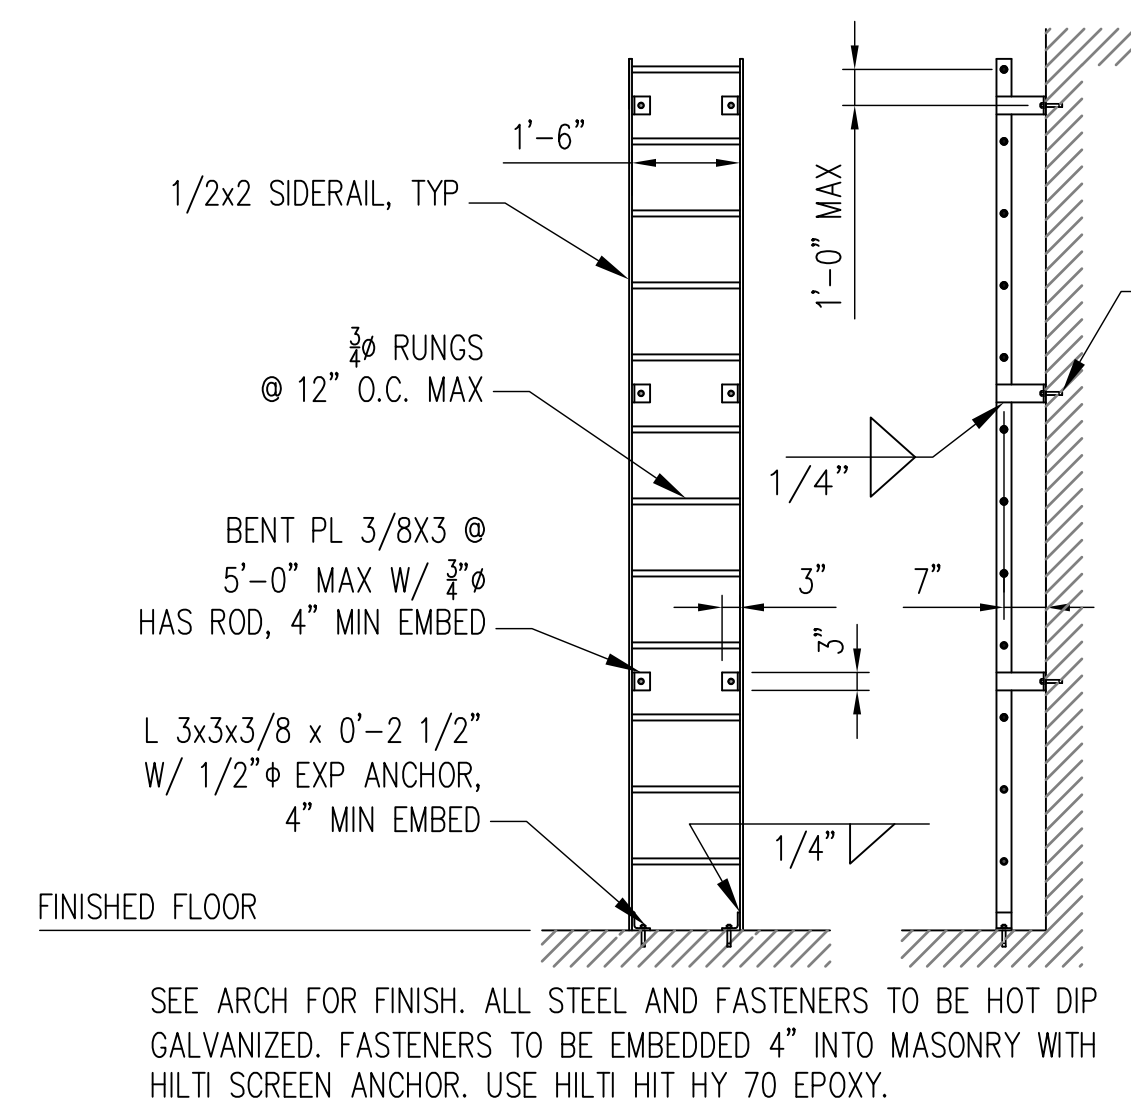

6 BEAM TO COLUMN CONNECTION  
FOR REINFORCING OF ELEVATED SLAB  
NOT TO SCALE

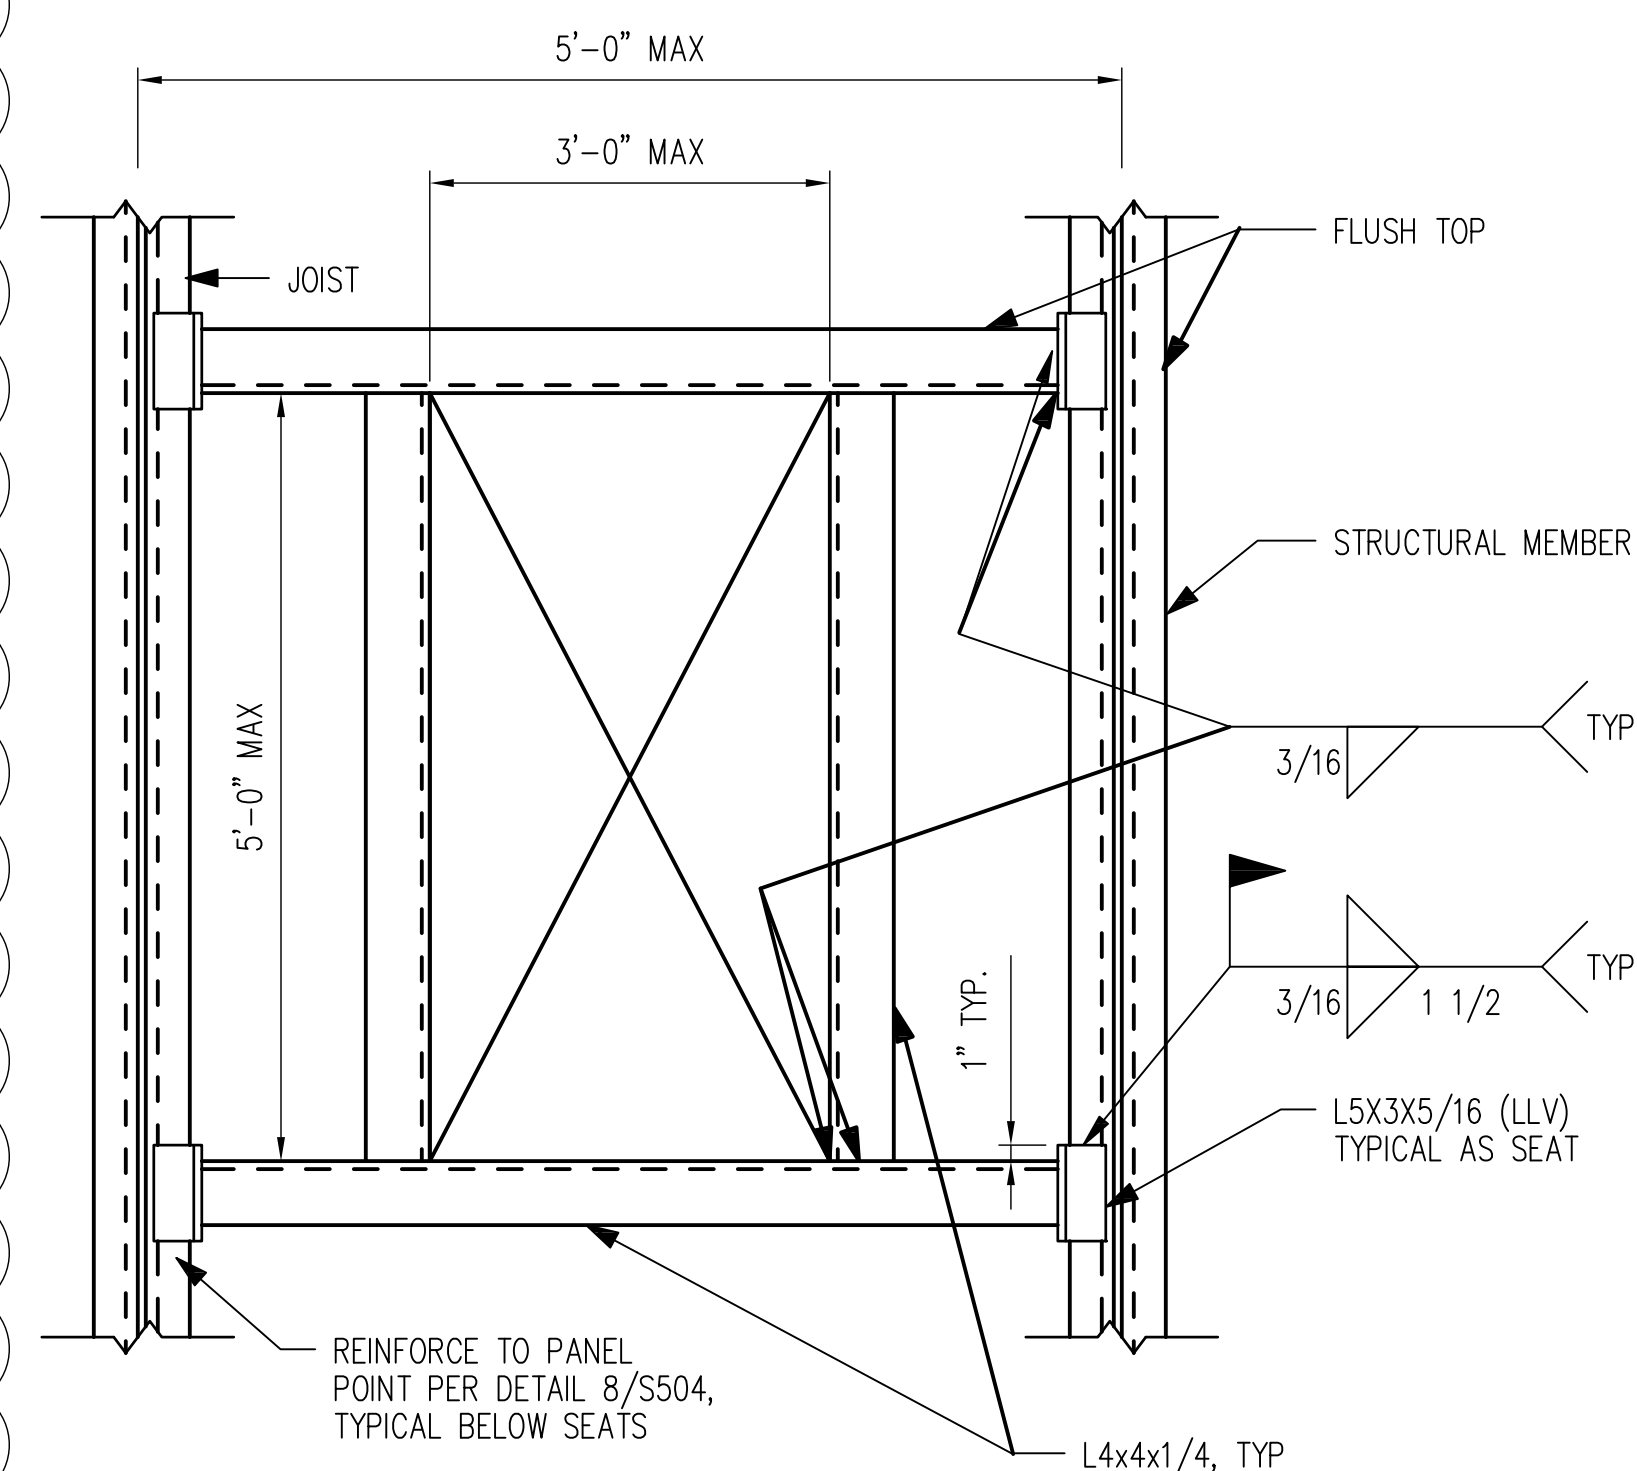

10 TYPICAL ROOF FRAMING FOR  
OPENINGS LARGER THAN 6"X6"  
NOT TO SCALE

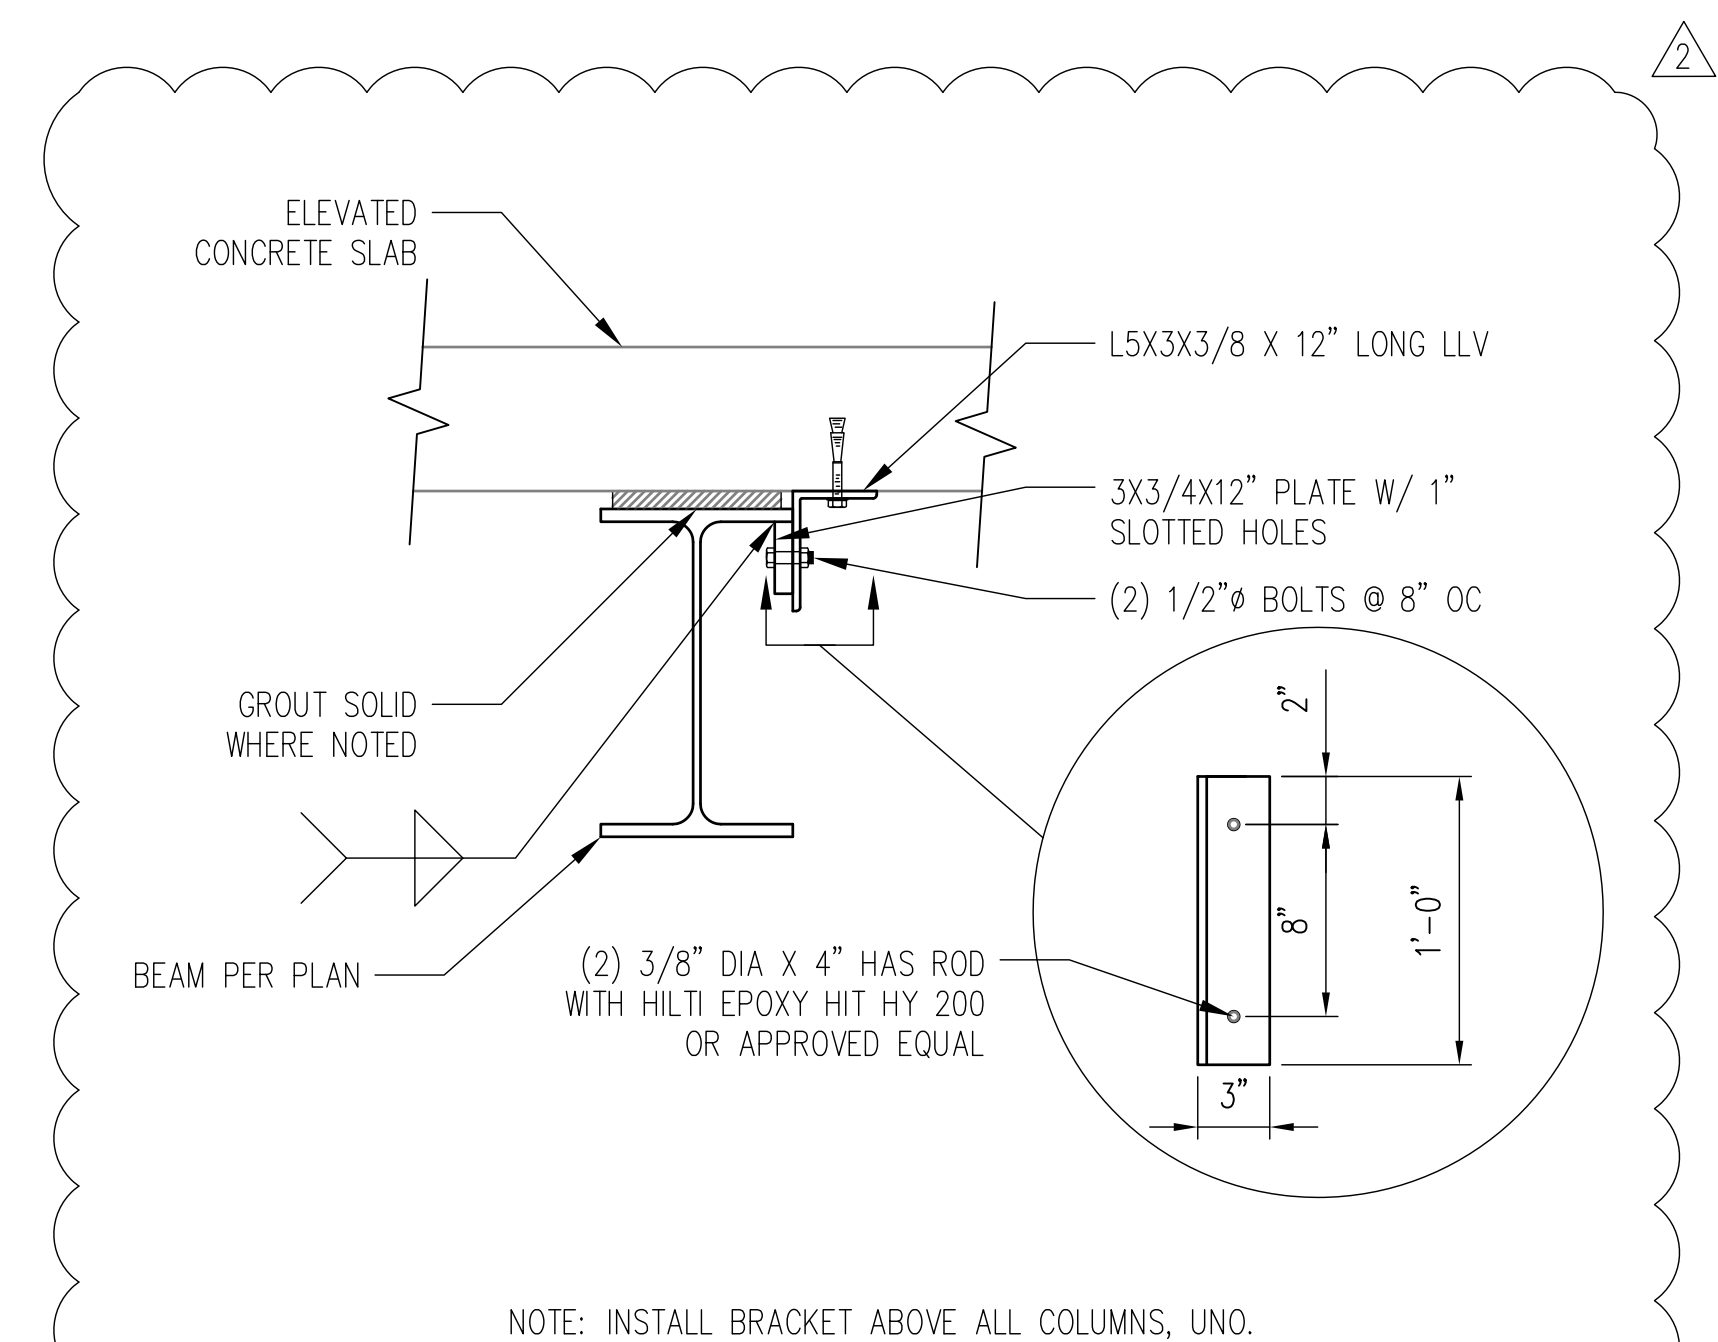

11 TYP BRACKET CONNECTION  
NOT TO SCALE



Department of  
Veterans Affairs



