



EXISTING

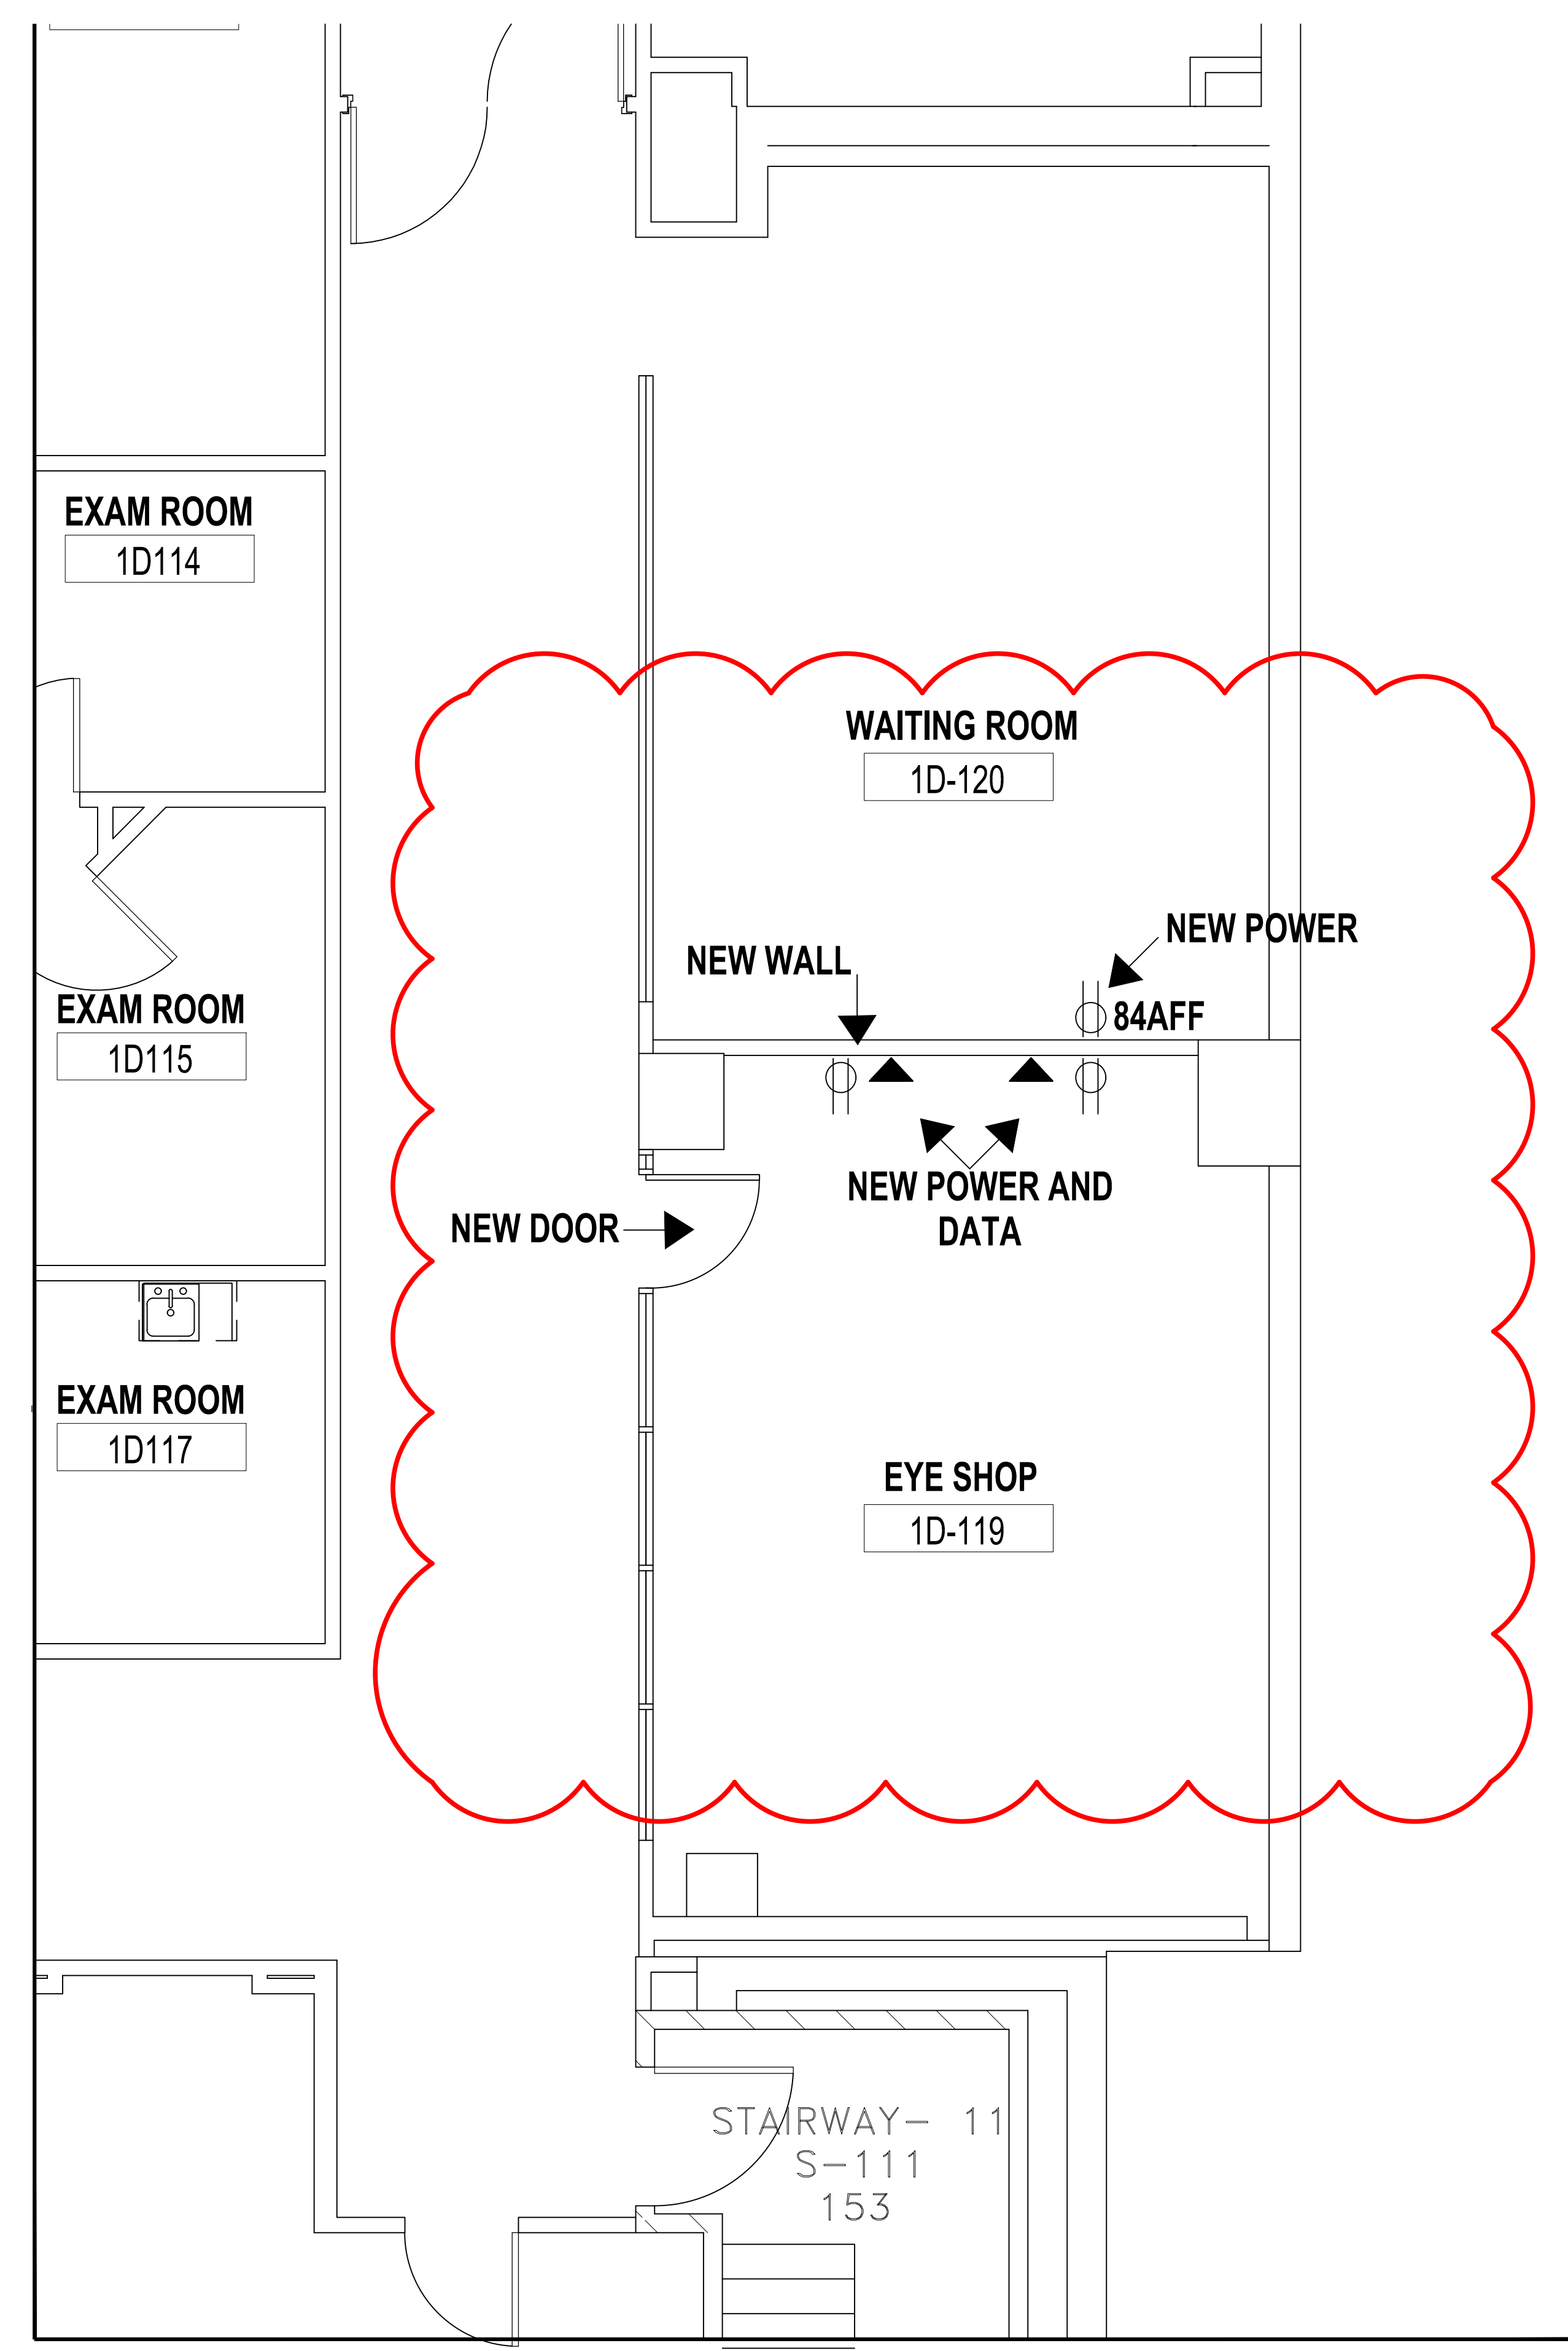

NEW LAYOUT

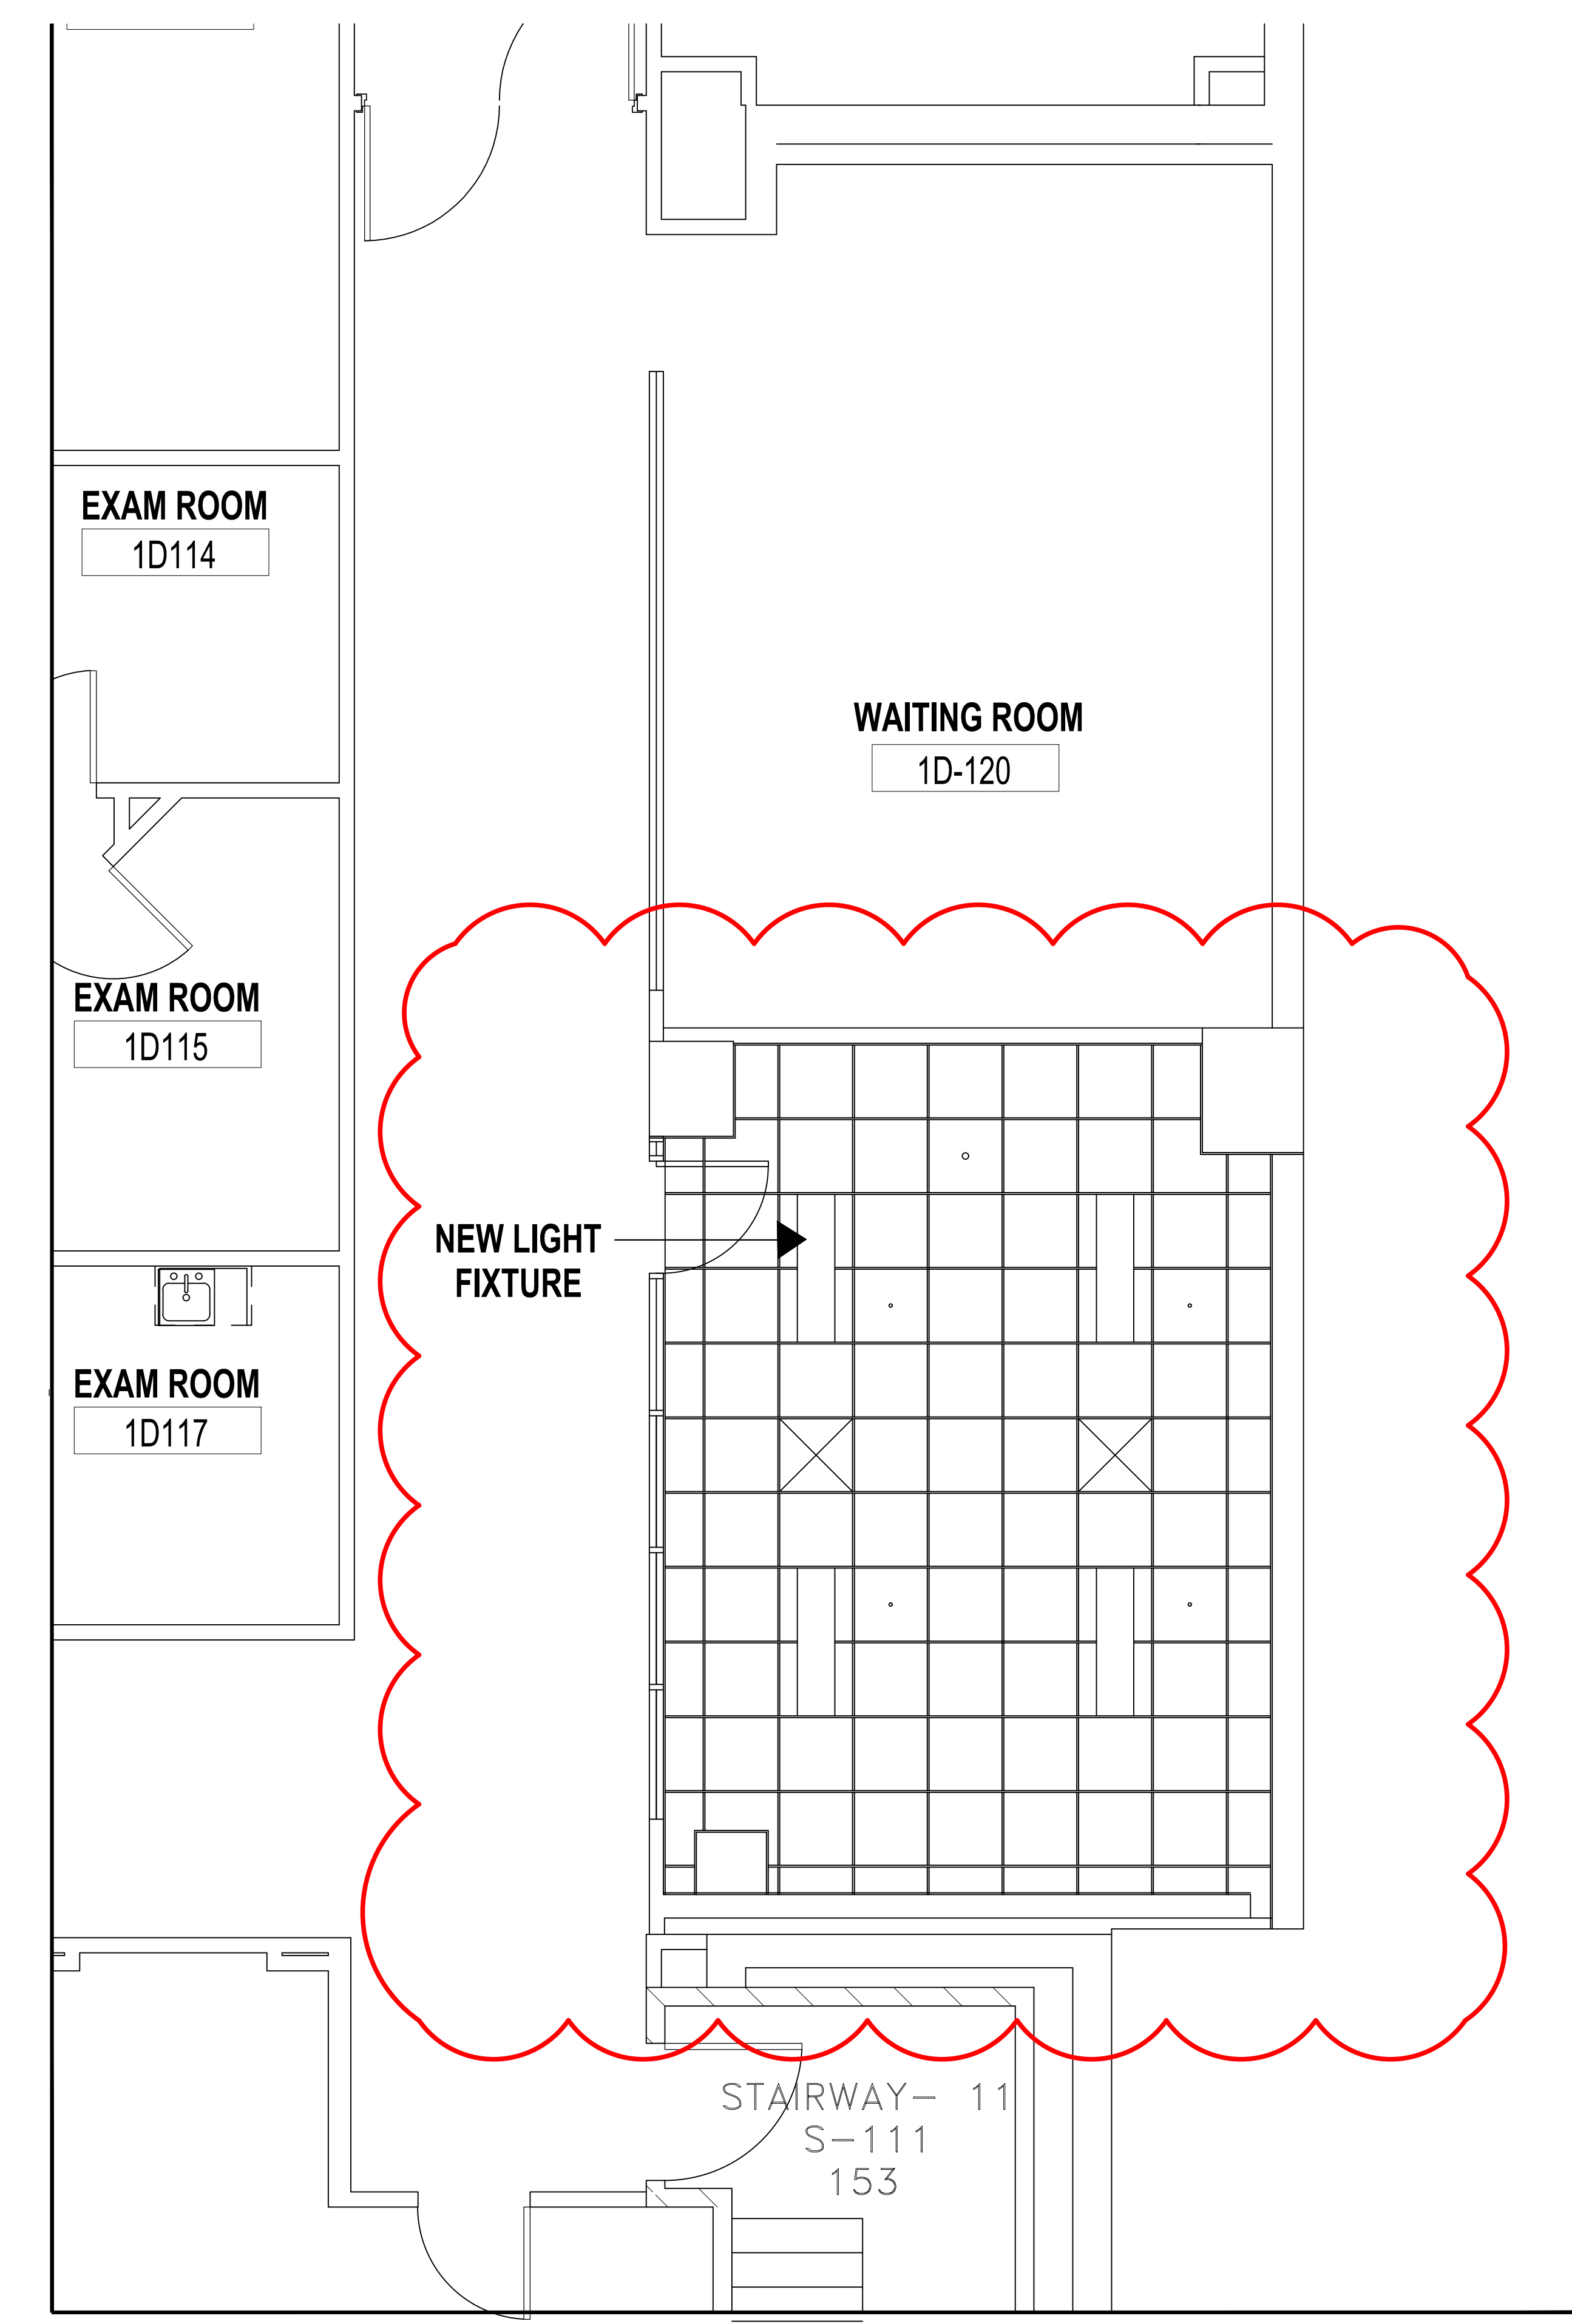

**REFLECTED
CEILING**