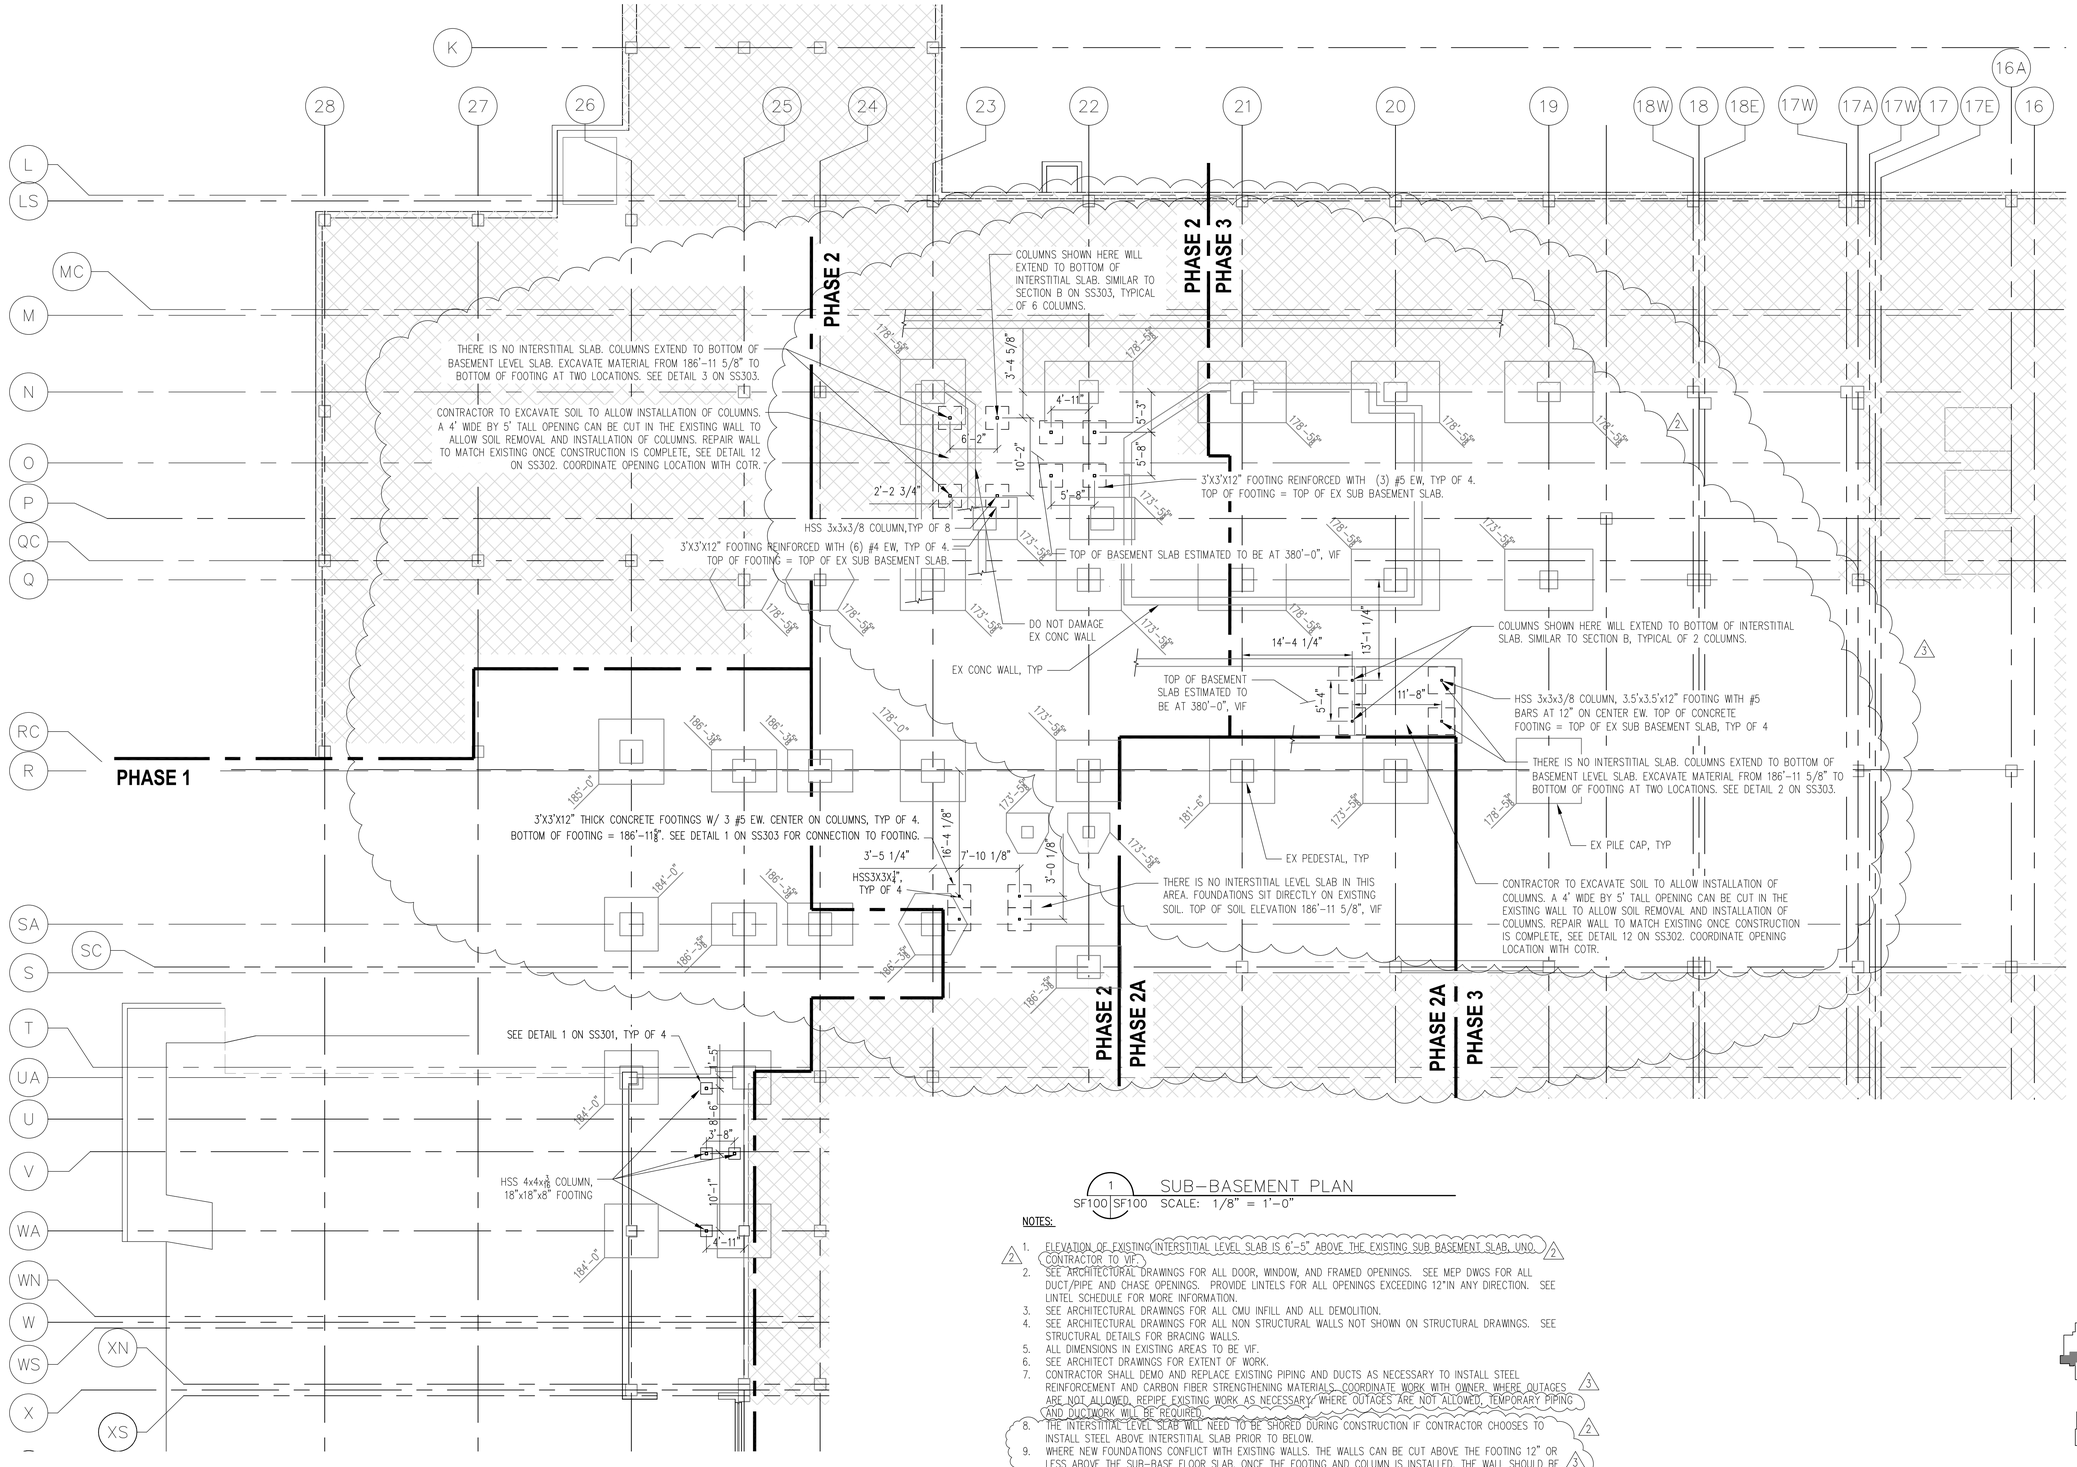

1 SF100 | SF100 SUB-BASEMENT PLAN
SCALE: 1/8" = 1'-0"

NOTES:

1. ELEVATION OF EXISTING INTERSTITIAL LEVEL SLAB IS 6'-5" ABOVE THE EXISTING SUB BASEMENT SLAB, UNO. CONTRACTOR TO VIF.
2. SEE ARCHITECTURAL DRAWINGS FOR ALL DOOR, WINDOW, AND FRAMED OPENINGS. SEE MEP DWGS FOR ALL DUCT/PIPE AND CHASE OPENINGS. PROVIDE LINTELS FOR ALL OPENINGS EXCEEDING 12"IN ANY DIRECTION. SEE LINTEL SCHEDULE FOR MORE INFORMATION.
3. SEE ARCHITECTURAL DRAWINGS FOR ALL CMU INFILL AND ALL DEMOLITION.
4. SEE ARCHITECTURAL DRAWINGS FOR ALL NON STRUCTURAL WALLS NOT SHOWN ON STRUCTURAL DRAWINGS. SEE STRUCTURAL DETAILS FOR BRACING WALLS.
5. ALL DIMENSIONS IN EXISTING AREAS TO BE VIF.
6. SEE ARCHITECT DRAWINGS FOR EXTENT OF WORK.
7. CONTRACTOR SHALL DEMO AND REPLACE EXISTING PIPING AND DUCTS AS NECESSARY TO INSTALL STEEL REINFORCEMENT AND CARBON FIBER STRENGTHENING MATERIALS. COORDINATE WORK WITH OWNER. WHERE OUTAGES ARE NOT ALLOWED, REPIPE EXISTING WORK AS NECESSARY. WHERE OUTAGES ARE NOT ALLOWED, TEMPORARY PIPING AND DUCTWORK WILL BE REQUIRED.
8. THE INTERSTITIAL LEVEL SLAB WILL NEED TO BE SHORED DURING CONSTRUCTION IF CONTRACTOR CHOOSES TO INSTALL STEEL ABOVE INTERSTITIAL SLAB PRIOR TO BELOW.
9. WHERE NEW FOUNDATIONS CONFLICT WITH EXISTING WALLS, THE WALLS CAN BE CUT ABOVE THE FOOTING 12" OR LESS ABOVE THE SUB-BASE FLOOR SLAB. ONCE THE FOOTING AND COLUMN IS INSTALLED, THE WALL SHOULD BE REPAIRED TO MATCH EXISTING. SEE DETAIL 12 ON SS302. DO NOT DAMAGE WALLS WITHOUT APPROVAL FROM COTR.
10. WHERE NEW FOUNDATIONS ARE PLACED, THE CONTRACTOR SHALL VERIFY COMPACTION PRIOR TO PLACING CONCRETE.

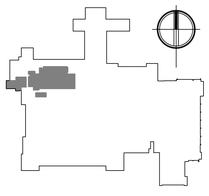

Bid Submission

Revisions	Date
Revision No. 3 - Trailer Removal	06/26/17
Addendum 2	08/17/17
Addendum 3	08/25/17

CONSULTANTS:

ROBERT L. SEYMORE & ASSOCIATES, INC.
TRANSPORTATION
ROBERT L. SEYMORE & ASSOCIATES
182 Thomas Johnson Drive
SUITE 200
FREDERICK, MARYLAND 21702

STRUCTURAL, CIVIL, COST ESTIMATING
ALPHA CORPORATION
1800 WASHINGTON BOULEVARD
SUITE 425
BALTIMORE, MD 21230

HENRY ADAMS
Consulting Engineers
MECHANICAL ELECTRICAL & PLUMBING ENGINEERS
MEP ENGINEERS
HENRY ADAMS
600 BALTIMORE AVENUE
BALTIMORE, MD 21204

KOFFEL ASSOCIATES
Fire Protection ENGINEERS
FIRE PROTECTION
KOFFEL ASSOCIATES, INC.
8815 CENTRE PARK DRIVE
SUITE 200 COLUMBIA,
MD 21045-2107

Korbel ASSOCIATES
MEDICAL EQUIPMENT PLANNING
KORBEL ASSOCIATES INC.
8700 WEST 36TH STREET, SUITE 219
MINNEAPOLIS, MN 55426

INDUSTRIAL HYGIENISTS
AEROSOL MONITORING & ANALYSIS, INC.
1331 ASHTON ROAD, P.O. BOX 646 HANOVER,
MARYLAND 21076

ARCHITECTS / ENGINEERS:

ERNEST BLAND ASSOCIATES, P.C.
TECHNICAL FACILITIES DESIGN
802 SLIGO AVENUE, SILVER SPRING, MARYLAND 20910
TELEPHONE (301) 589-4811 FAX (301) 589-3810

Drawing Title: SUB-BASEMENT PLAN
Approved: Project Director
Project Title: SPS RENOVATION
Location: WASHINGTON DC VA MEDICAL CENTER
Date: 06/26/17 | Checked: TWW | Drawn: SEP
Project Number: 688-14-003
Building Number: BUILDING NO. 1
Drawing Number: SF100
Dwg. 2 of 6

Office of Construction and Facilities Management
Department of Veterans Affairs

VA FORM 08-6231

W:\sps\56-020 S VA DC Sterile SPS\5200 STRUCT\DWGS\SF100 Sub-Basement Plan.dwg 8-25-17 12:25:57 PM sara.power