




Aug 24, 2017 - 9:25am
Drawing File: E:\2015\000\000\2015\14\000\01 CAD\06 Elec\E2-E4 - Building 11.dwg Layout: Basement

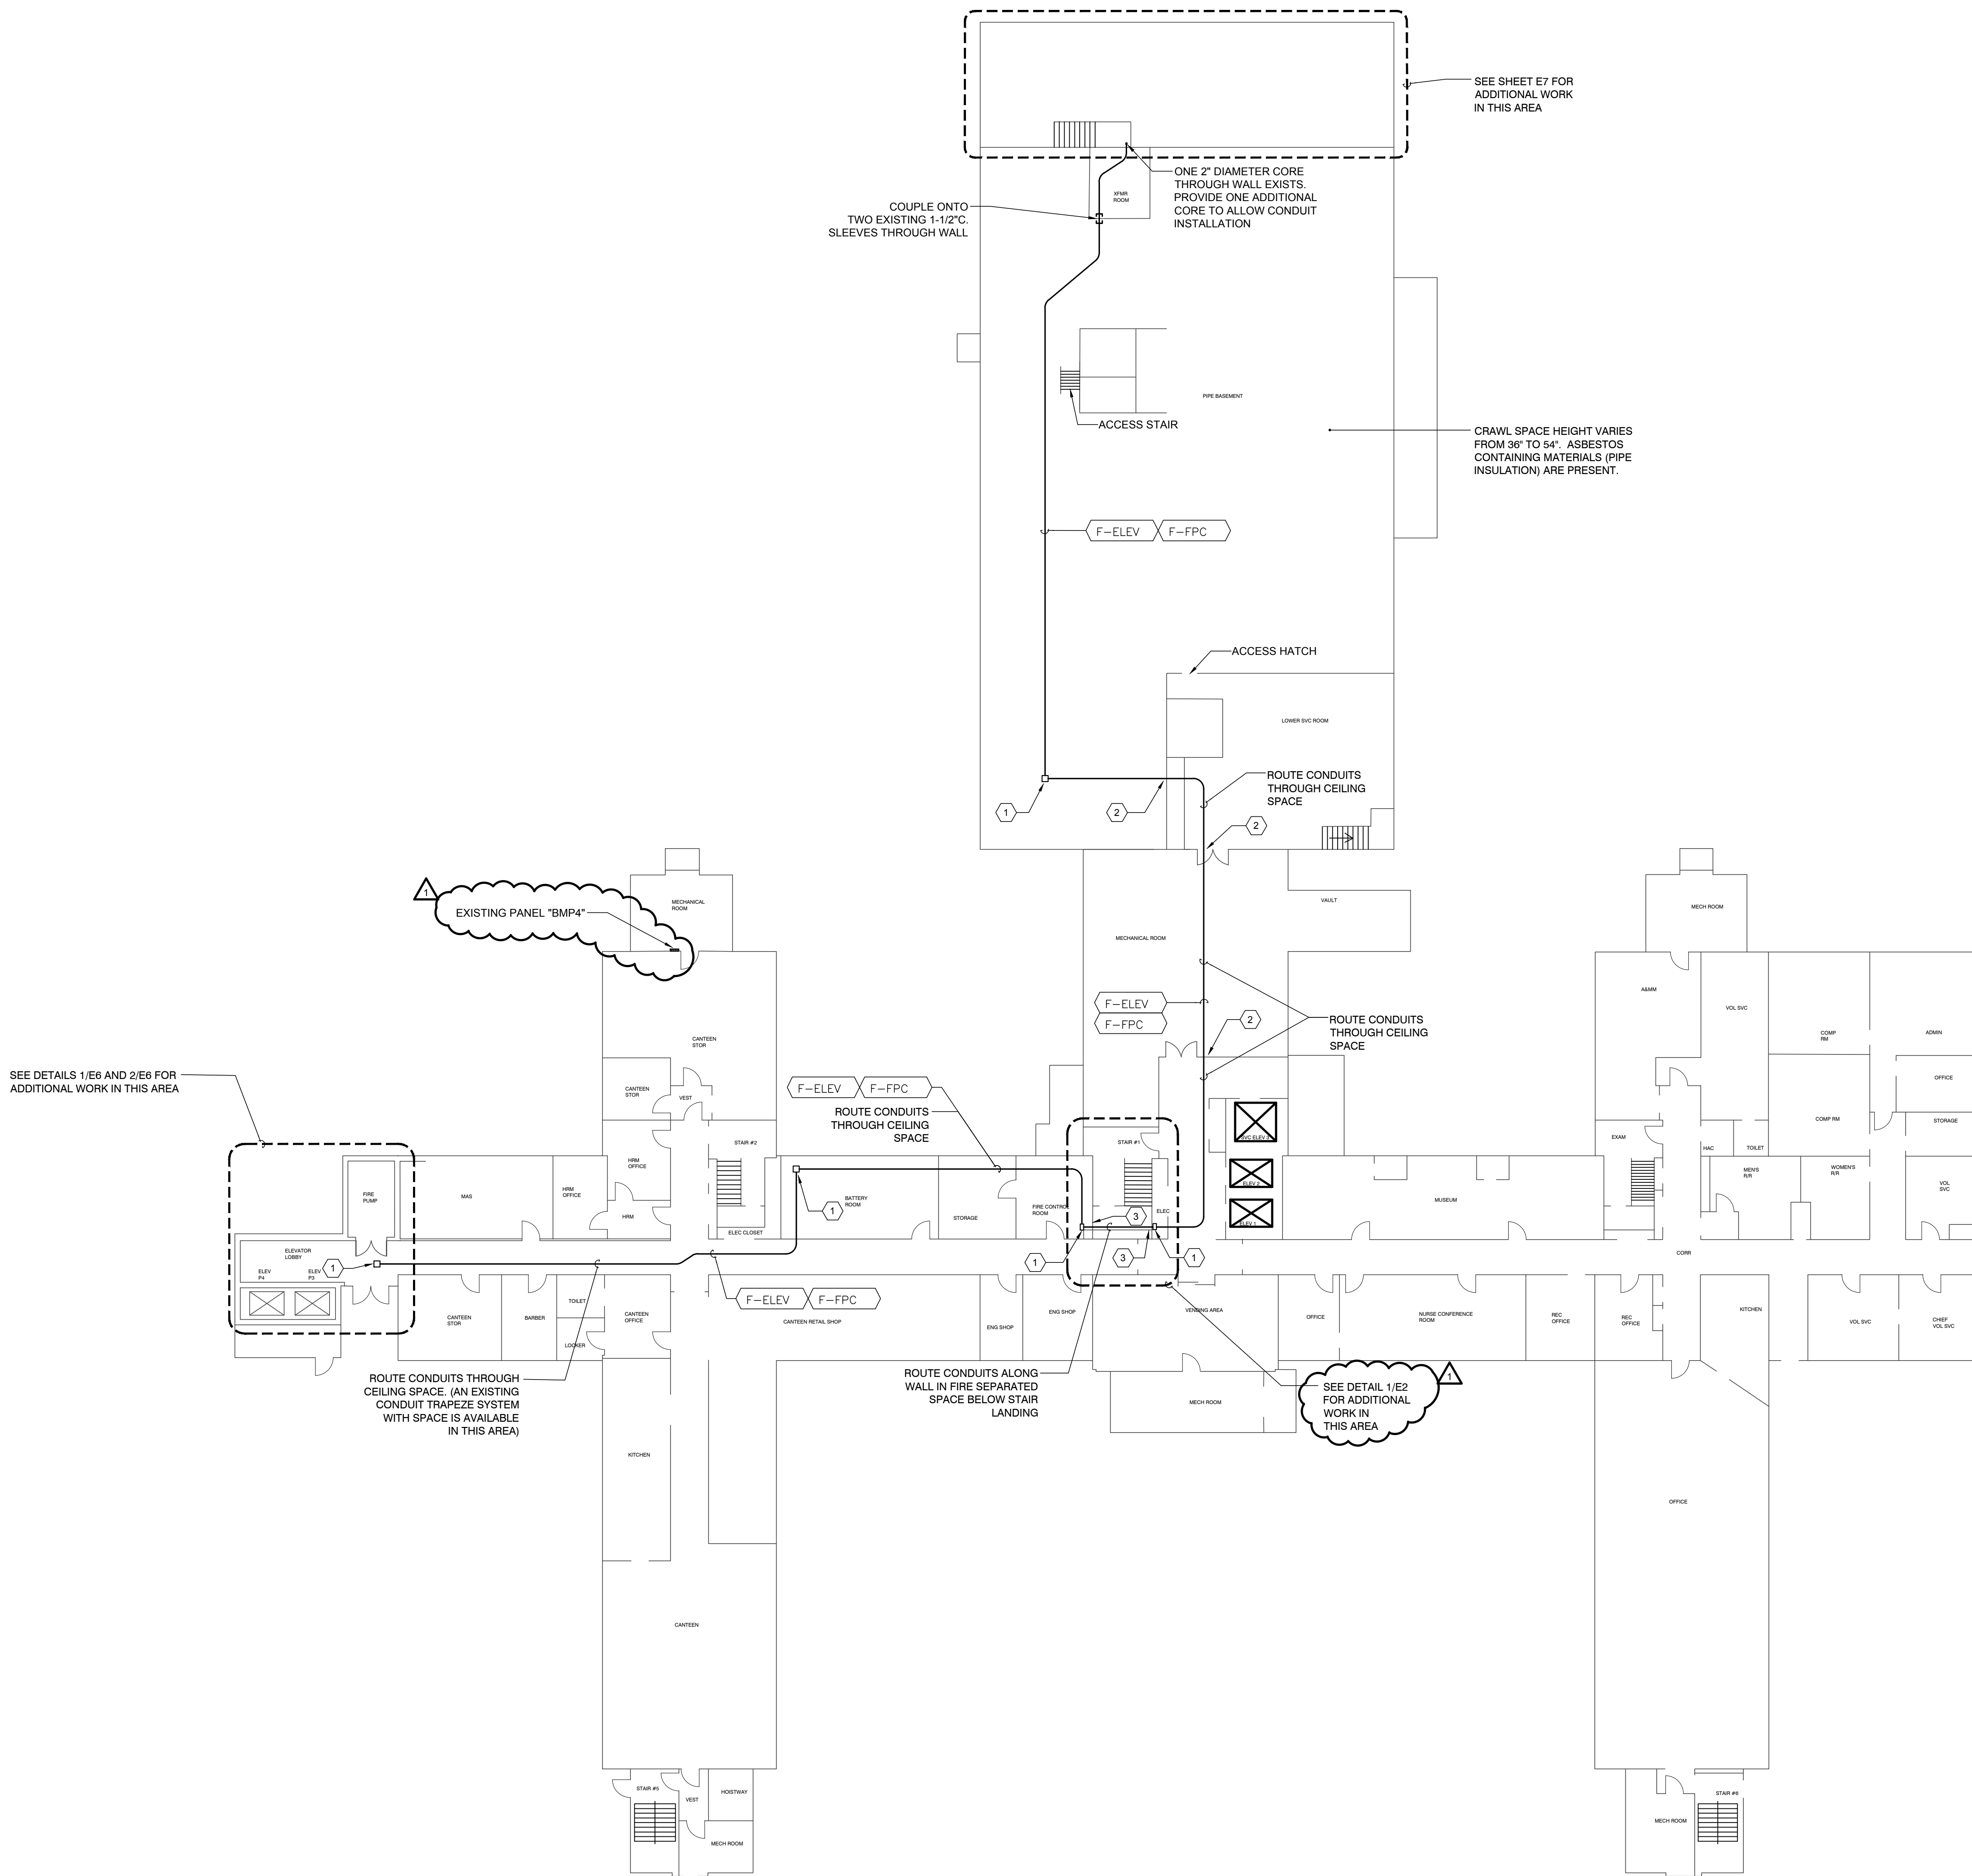

NOTES BY SYMBOL: "⊕"

1. PROPOSED JUNCTION BOX LOCATION IN CEILING SPACE. PROVIDE ONE BARRIERED BOX OR TWO BOXES TO SEPARATE THE ELEVATOR FEEDER FROM THE FIRE PUMP ATS CONTROL WIRING.
2. CORE WALL ABOVE CEILING LINE.
3. CORE WALL AT APPROXIMATELY 36\"/>

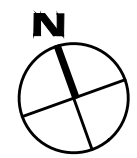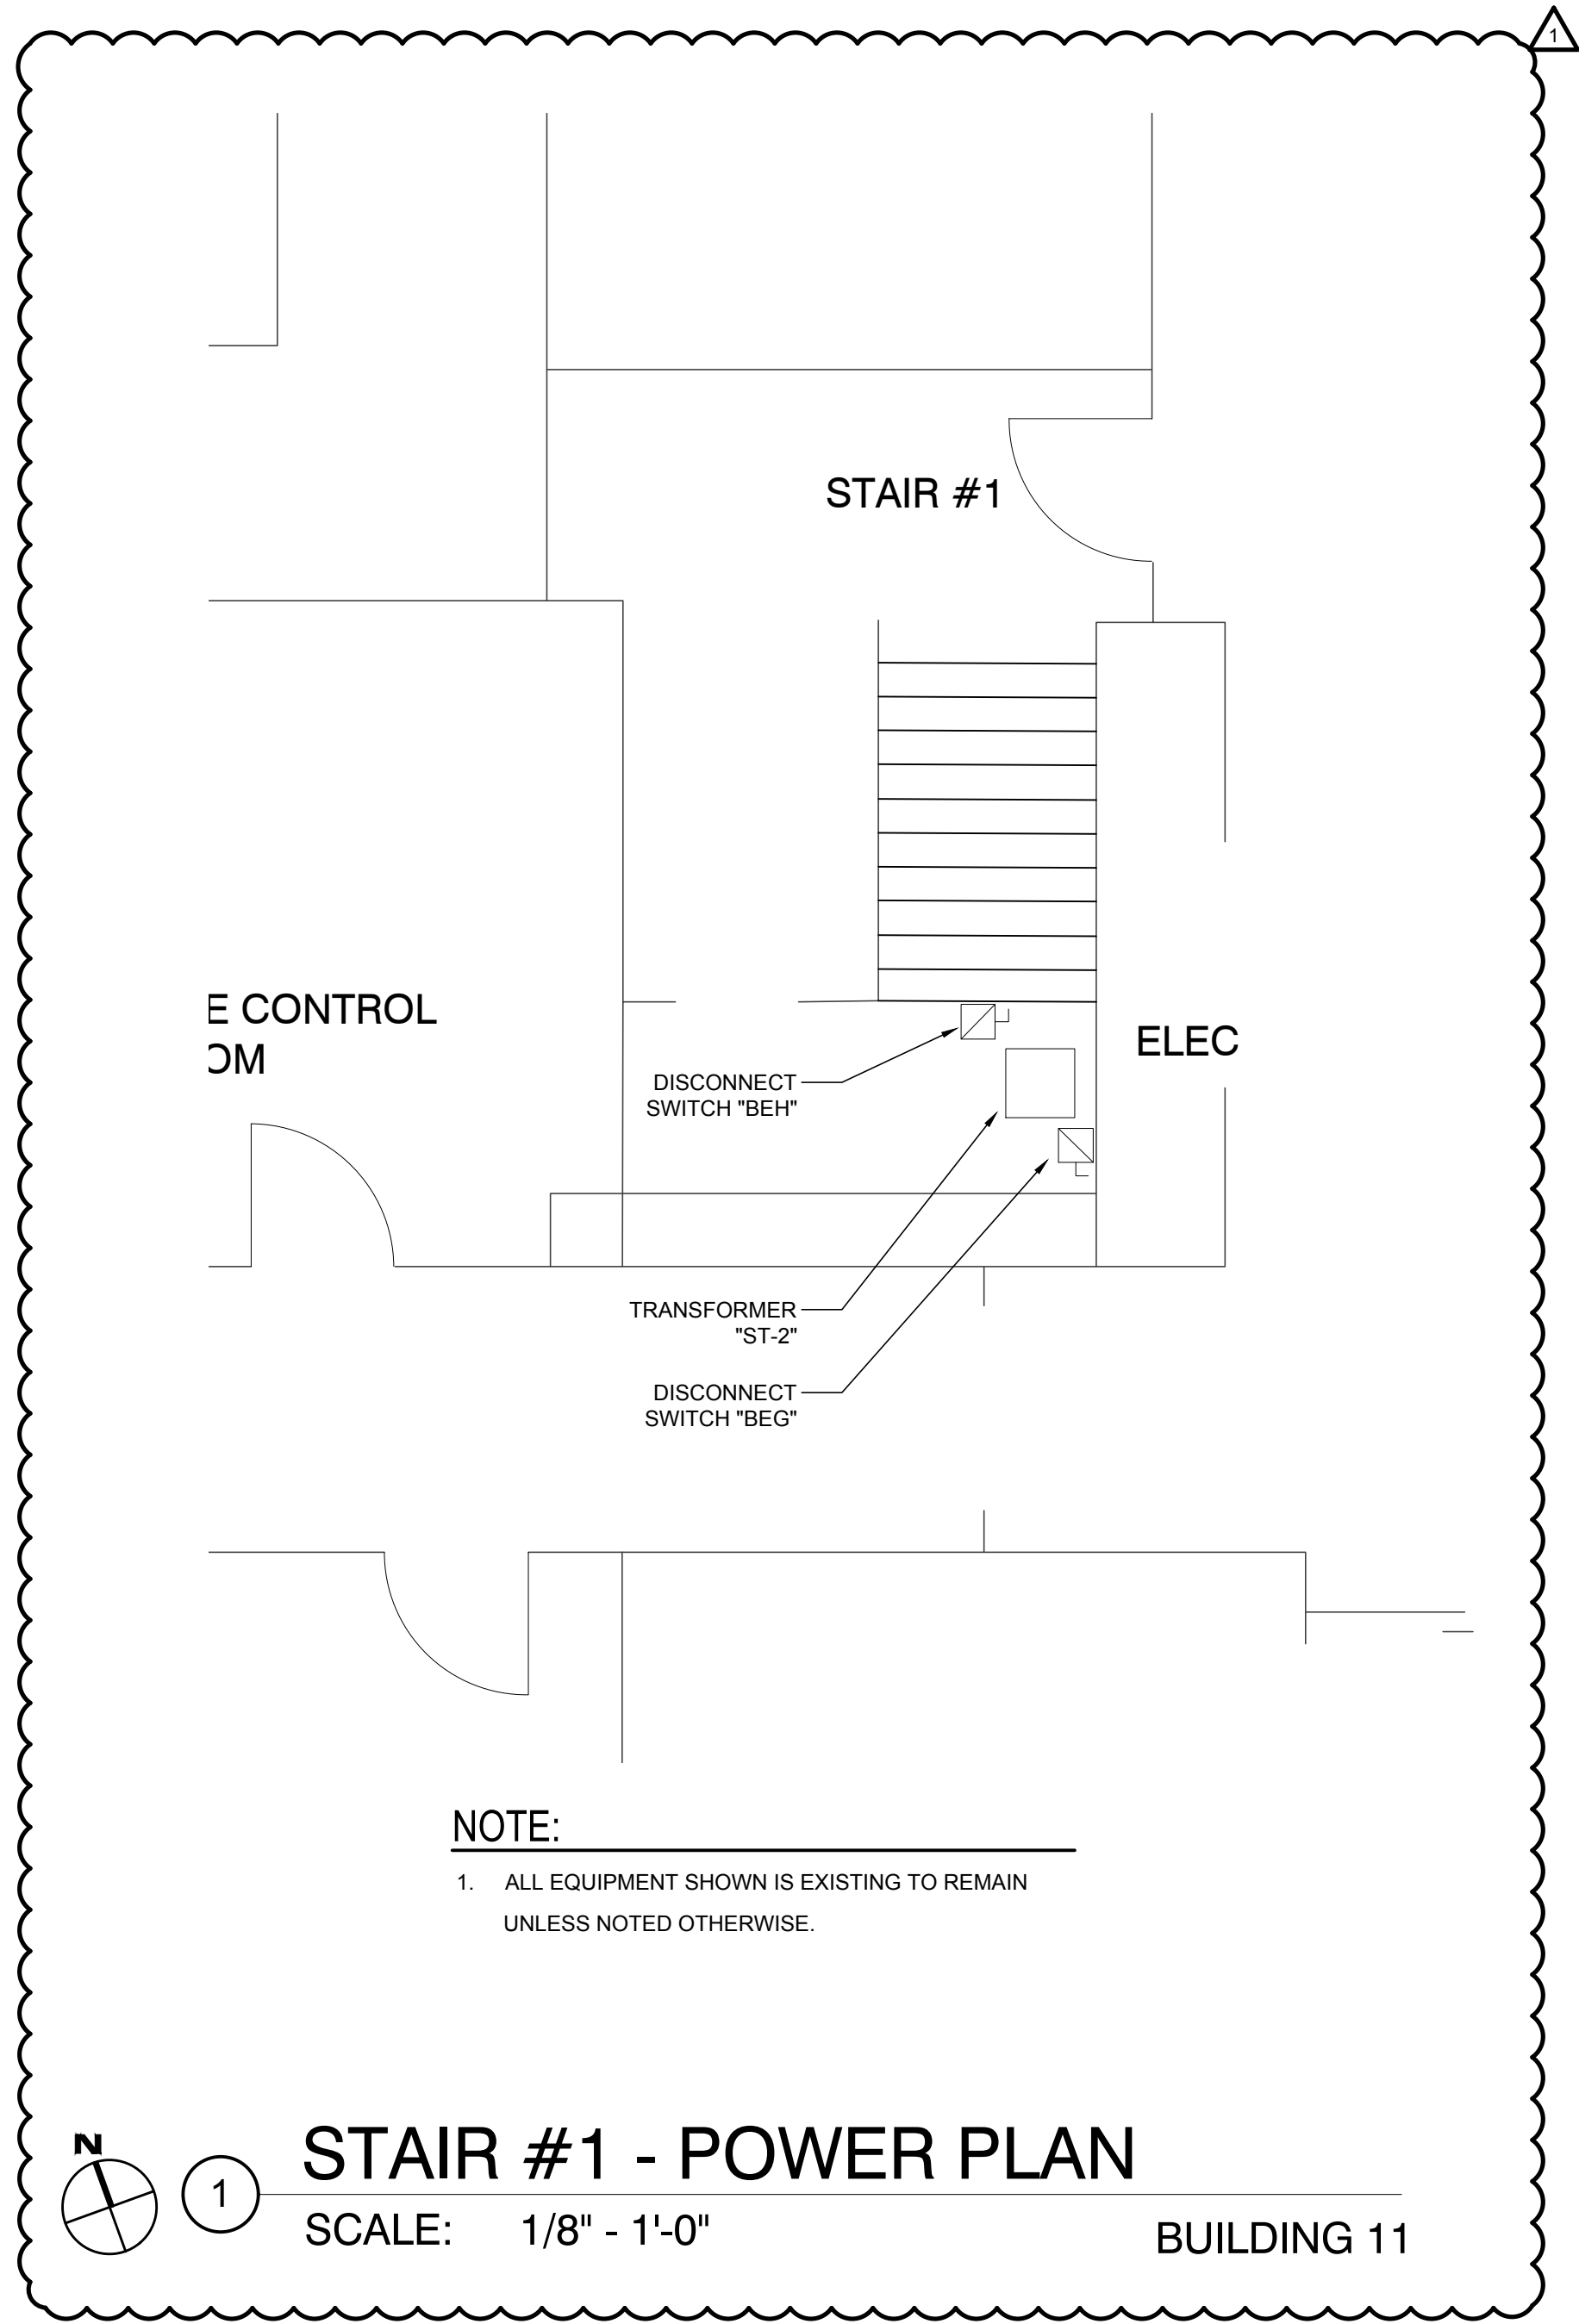

POWER PLAN - BUILDING 11 - BASEMENT
SCALE: 1/16" - 1'-0"

ADDENDUM #3	8-25-17
Revisions:	Date:

CONSULTANTS:



ARCHITECT/ ENGINEERS



BAIRD, HAMPTON & BROWN, INC.
ENGINEERING & SURVEYING
6300 Ridgley Place, Ste 700 Fort Worth, TX 76116 Tel: 817-338-1277 Fax: 817-338-9245
TBPE Firm 000044 E-Mail: mail@bhbinco.com Web Site: www.bhbinco.com TBPLS FIRM 10011300

Drawing Title:
POWER PLAN - BUILDING 11 - BASEMENT

Approved Project Director:
OFFICE OF CONSTRUCTION AND FACILITIES MANAGEMENT
WESTERN REGION

Project Title:
**UPGRADE EMERGENCY
POWER**
TASK ORDER NO. VA257-15-R-0634

Location:
3600 MEMORIAL BLVD., KERRVILLE, TX 78028

Date:
MAY 26, 2017

CONSTRUCTION SET

Project Number
671A4-15-123
Building Numbers
11, 90, 96

Drawing Number
E2
Dwg. _____ of _____

Office of
Construction
and Facilities
Management

