


ROOM SCHEDULE	
ROOM NO.	ROOM
B-301	LABORATORY
B-302	LABORATORY
B-303	ASSIST. PATHOLOGIST
B-304	ASSIST. PATHOLOGIST
B-305	CHIEF OF PATHOLOGY
B-306	CHIEF OF PATHOLOGY
B-307	SECRETARY
B-308	ASSIST. PATHOLOGIST
B-309	ASSIST. PATHOLOGIST
B-310	LINEIN CHUTE
B-311	ELEVATOR LOBBY
B-312	JANITOR
B-313	CENTRAL STERILE
B-314	EQUIPMENT STORAGE
B-315	OFFICE STERILE STORAGE
B-316	STERILIZERS
B-317	STERILIZER
B-318	STERILIZER
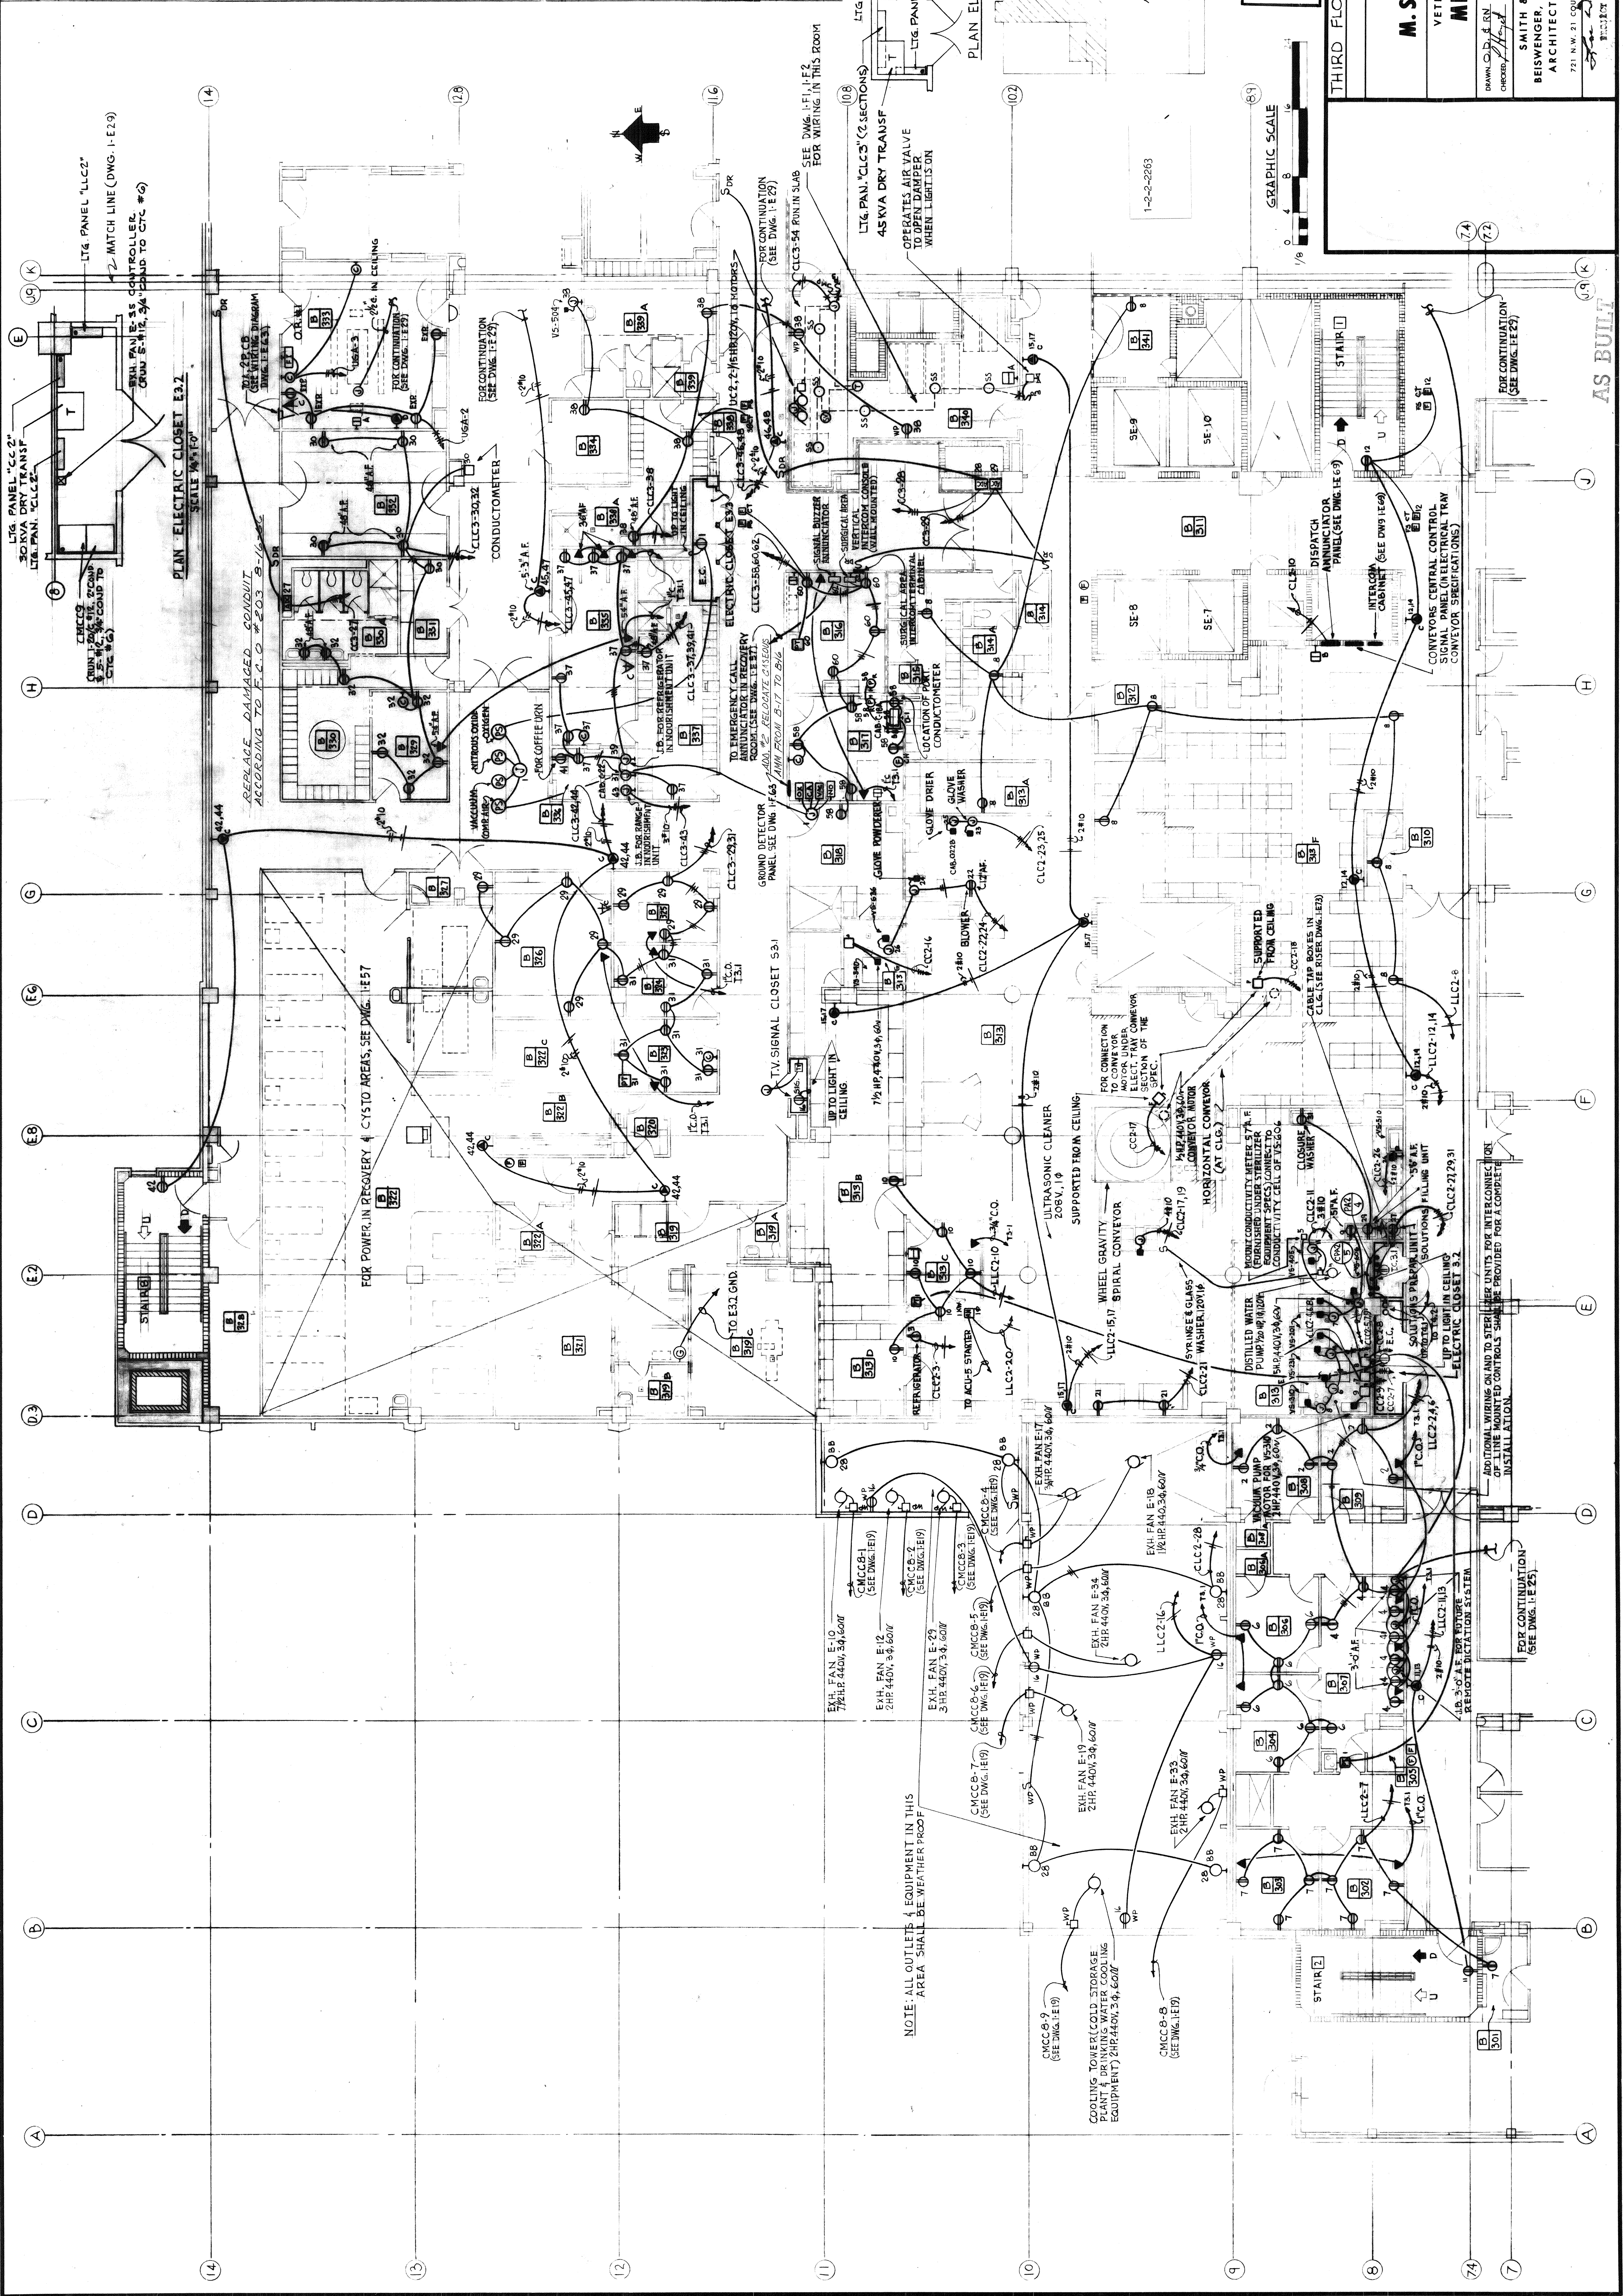

ALL ADDENDUM, CLARIFICATION AND CHANGE ORDER DATA HAVE BEEN INCORPORATED INTO THIS DRAWING. THIS DRAWING IS COMPLETE AND UP-TO-DATE AS OF 8-25-67.

KEY PLAN

1-2-2-263

GRAPHIC SCALE

1/8" = 1'-0"












THIRD FLOOR PLAN "B" FWR.

BUILDING NO. 1

1062 BED

M.S. & N. HOSPITAL

VETERANS ADMINISTRATION

MIAMI, FLORIDA

REVISIONS

DRAWN: G.D. & B.N. CHECKED: H.H. DATE: May 5, 1964

SMITH & KORACH

BEISWENGER, HOCH & ARNOLD

ARCHITECTS-ENGINEERS

721 N.W. 21 STREET, MIAMI, FLORIDA

DRAWING NUMBER

I-E 27

SHEET 452 OF 502

PROJ. NO. 94-212

AS BUILT