


ROOM NO.	ROOM NAME
C-302 A	LIGHT ROOM
C-302 B	DARK ROOM
C-303 A	MERCHANDISE ROOM
C-303 B	RECEPTION
C-304 A	BLACK & WHITE PROCESS
C-304 B	COLOR PROCESS
C-304 C	ENLARGING
C-304 D	PRINTING
C-304 E	PRINTING
C-305 A	AUTOPEL LOCKERS & TOILET
C-305 B	AUTOPEL LOCKERS & TOILET
C-305 C	AUTOPEL LOCKERS & TOILET
C-305 D	AUTOPEL LOCKERS & TOILET
C-305 E	AUTOPEL LOCKERS & TOILET
C-306 A	JANITOR
C-306 B	MALE LOCKERS & TOILET
C-306 C	FEMALE LOCKERS & TOILET
C-306 D	SOILED HOLDING
C-307 A	PLASTERING ROOM No. 6
C-307 B	PLASTERING ROOM No. 7
C-308 A	SOILED HOLDING
C-308 B	SOILED HOLDING
C-309 A	OPERATING ROOM No. 1
C-309 B	OPERATING ROOM No. 2
C-310	OPERATING ROOM No. 3
C-311	OPERATING ROOM No. 4
C-312	OPERATING ROOM No. 5
C-313	OPERATING ROOM No. 6
C-314	SCRUB
C-315	SCRUB
C-316	SCRUB
C-317	SCRUB
C-318	SCRUB
C-319	SCRUB
C-320	OPERATING ROOM No. 2
C-321	OPERATING ROOM No. 3
C-322	OPERATING ROOM No. 4
C-323	OPERATING ROOM No. 5



ALL ADDENDUM CLARIFICATION AND
 CHANGES MADE TO THIS DRAWING
 SINCE THE DATE OF ISSUE ARE
 UP TO DATE AS OF 8-15-67

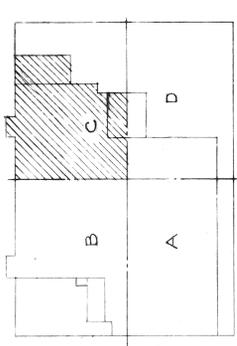

BUILDING NO. 1
1062 BED
M. S. & N. HOSPITAL
 VETERANS ADMINISTRATION
 MIAMI, FLORIDA

SMITH & KOBACH
 ARCHITECTS-ENGINEERS
 721 N.W. 21 COURT - MIAMI, FLORIDA

DATE: May 5, 1964

PROJ. NO. 10-5172
 DRAWN: J.L.L.
 CHECKED: C.C.

REVISIONS

STATE OF FLORIDA
 PROFESSIONAL SEAL
 No. 500
 STATE OF FLORIDA
 REGISTERED PROFESSIONAL ENGINEER

FILE FOR RECORD



AS BUILT

RETURN TRACINGS TO PLAN FILES