## ROOM SCHEDULE

| ROOM Nº | ROOM NAME | ROOM Nº | ROOM NAME |
|---|---|---|---|
| D-301 | SPECIAL PROCEDURE | D-313C | CONTROL |
| D-301A | CONTROL | D-314 | DRESS & TOILET |
| D-301B | DRESS & TOILET | D-314A | TOILET |
| D-301C | TOILET | D-314B | RAD. & FLUOR |
| D-302 | | D-314C | RADIOLOGY |
| D-302A | FEMALE LOCKERS & TOILET | D-314D | RAD. & FLUOR |
| D-303 | CONFERENCE | D-315 | DRESS & TOILET |
| D-304 | MALE LOCKERS & TOILET | D-315A | TOILET |
| D-305 | EQUIPMENT STORAGE | D-315B | RADIOGRAPHIC |
| D-306 | RESIDENT | D-315C | RAD. & FLUOR |
| D-307 | CHIEF RADIOLOGY | D-316 | CONTROL |
| D-308 | SECRETARY | D-316A | CONTROL |
| D-309 | ASSISTANT CHIEF RADIOLOGY | D-317 | DRESS & TOILET |
| D-310 | JANITOR | D-317A | TOILET |
| D-311 | CHIEF TECH. | D-317B | RADIOGRAPHIC |
| D-312 | RECEPTION CLERK | D-317C | SPECIAL DIAGNOSTIC |
| D-313 | DRESS & TOILET | D-317D | STORAGE |
| D-313A | TOILET | D-317E | CONTROL |
| D-313B | RAD & FLUOR | | |

MECHANICAL AREA Nº 2
SEE DWG. I-H 51

SUBSTITUTE FLUSH MOUNTED 4 WAY A.C. DIFFUSERS IN LIEU OF SURFACE MOUNTED

RELOCATE THESE DIFFUSERS AS REQUIRED BY FCO # 205 3-1-66

- EXH. FAN E-$G_{12}$
- EXH. FAN E-$G_{13}$
- EXH. FAN E-$G_{14}$
- EXH. FAN E-$G_{15}$
- EXH. FAN E-$G_{16}$
- EXH. FAN E-$G_{17}$
- EXH. FAN E-$G_{18}$
- EXH. FAN E-$G_{19}$

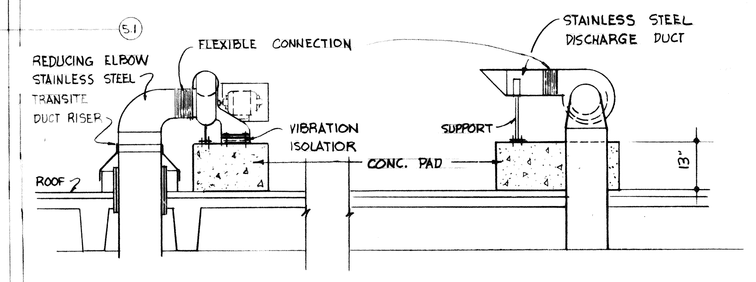


INSTALLATION DETAIL OF EXHAUST FANS E-$G_{12}$ THRU E-$G_{19}$ & E-14, - E-14$_2$
SCALE : 1/2" = 1'-0"

MAKE CHANGES TO DUCT, MIXING BOXES, DIFFUSERS, ETC. CO, CO #2 1-14-66

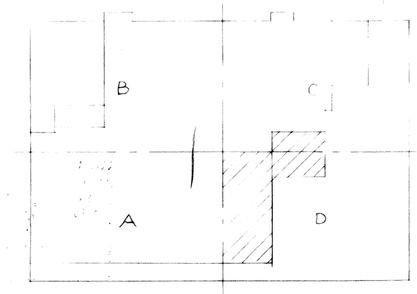


KEY PLAN

0 4 8 16 24
1/8"

AS BUILT

ALL ADDENDUM, CLARIFICATION AND CHANGE ORDER DATA HAVE BEEN ADDED TO THIS DRAWING. THIS DRAWING IS COMPLETE AND UP-TO-DATE AS OF 8-25-67

3RD FLOOR PLAN "D"
BUILDING NO. 1

# 1062 BED M.S. & N. HOSPITAL

VETERANS ADMINISTRATION
MIAMI, FLORIDA

DRAWN W.A.P. | PROJ. MGR. R.L. Smith
CHECKED B. Mills | DATE May 5, 1964

REVISIONS
4-30-65

SMITH & KORACH
REISWENGER, HOCH & ARNOLD
ARCHITECTS-ENGINEERS
721 N.W. 21 COURT, MIAMI, FLORIDA
PROJECT DIRECTOR

DRAWING NUMBER
I-H18R
SHEET 363 OF 502
PROJ. NO. 09-5212

RETURN TRACINGS TO PLAN FILES

FILE FOLDER NO. ...