


- NOTE:**
1. OBSERVATION WINDOW TYPE "Q" OCCURS OPERATING ROOMS SHALL BE COMPLETELY SHIELDED, SHIELDING AND SHIELDING SHALL BE SIMILAR TO THAT REQUIRED FOR SHIELDED ROOM OF ELECTRO ENCEPHALOGRAPHIC SUITE.
 2. WIPER OF FRAME SHALL BE FINISHED WITH "V" JOINT AROUND EDGE OF FRAME.
 3. REINFORCE FRAME WHERE REQUIRED FOR HARDWARE.
 4. PROVIDE HOLE IN FRAME TO RECEIVE BULLET CATCH. WELD REINFORCING PLATE BACK OF EACH HOLE.
 5. MAGNETIC TYPE CATCHES WILL NOT BE PERMITTED.
 6. METAL LATH SHALL OVERLAP AND BE SECURED TO CONC. BACK AS SPECIFIED.
 7. BORDERS TO METAL FRAME SHALL BE ELECTRICALLY Banded TO FRAME OF OPENING WITH FLEXIBLE PROPHOR BRONZE TAPE AT HINGE JAMB.

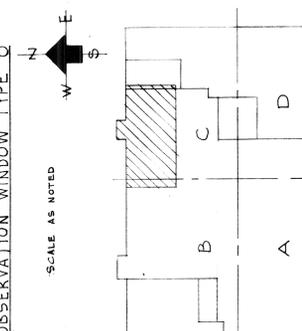

KEY PLAN

BUILDING NO. 1

SURGICAL SUITE NO. 2

1062 BED

M. S. & N. HOSPITAL

VETERANS ADMINISTRATION

MIAMI, FLORIDA

REVISIONS

DATE: May 5, 1962

BY: [Signature]

CHECKED: [Signature]

DESIGNED: [Signature]

DRAWING NUMBER: **IDE7**

SHEET: 115 OF 202

PROJ. NO. 21-00000








DATE: May 5, 1962

DESIGNED BY: [Signature]

CHECKED BY: [Signature]

DATE: May 5, 1962

PROJECT DIRECTOR: [Signature]

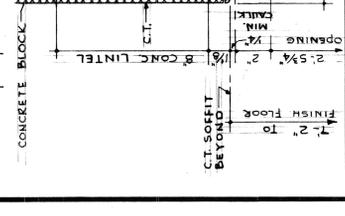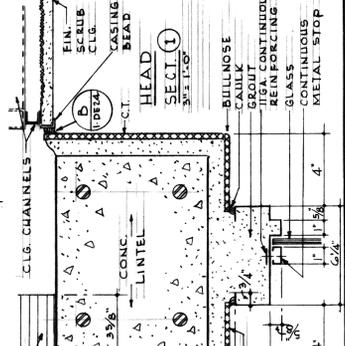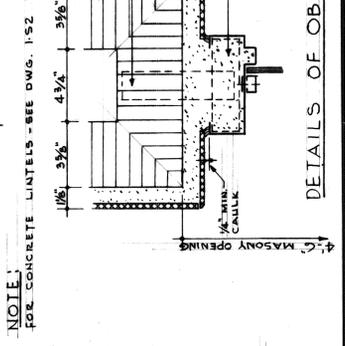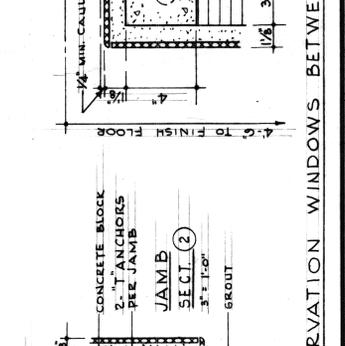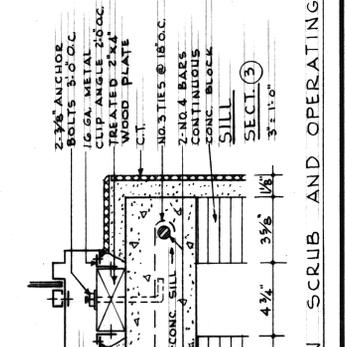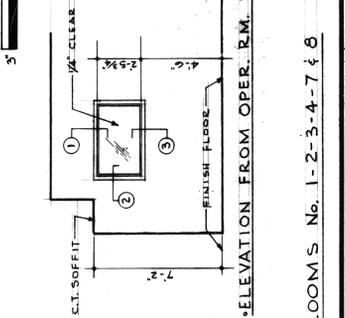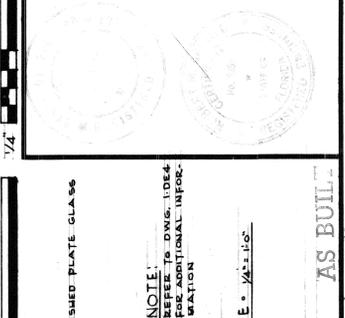

RETURN TRACINGS TO PLAN FILE

AS BUILT

DETAILS OF OBSERVATION WINDOWS BETWEEN SCRUB AND OPERATING ROOMS No. 1-2-3-4-7-8

FILE FOLDER NO. 5