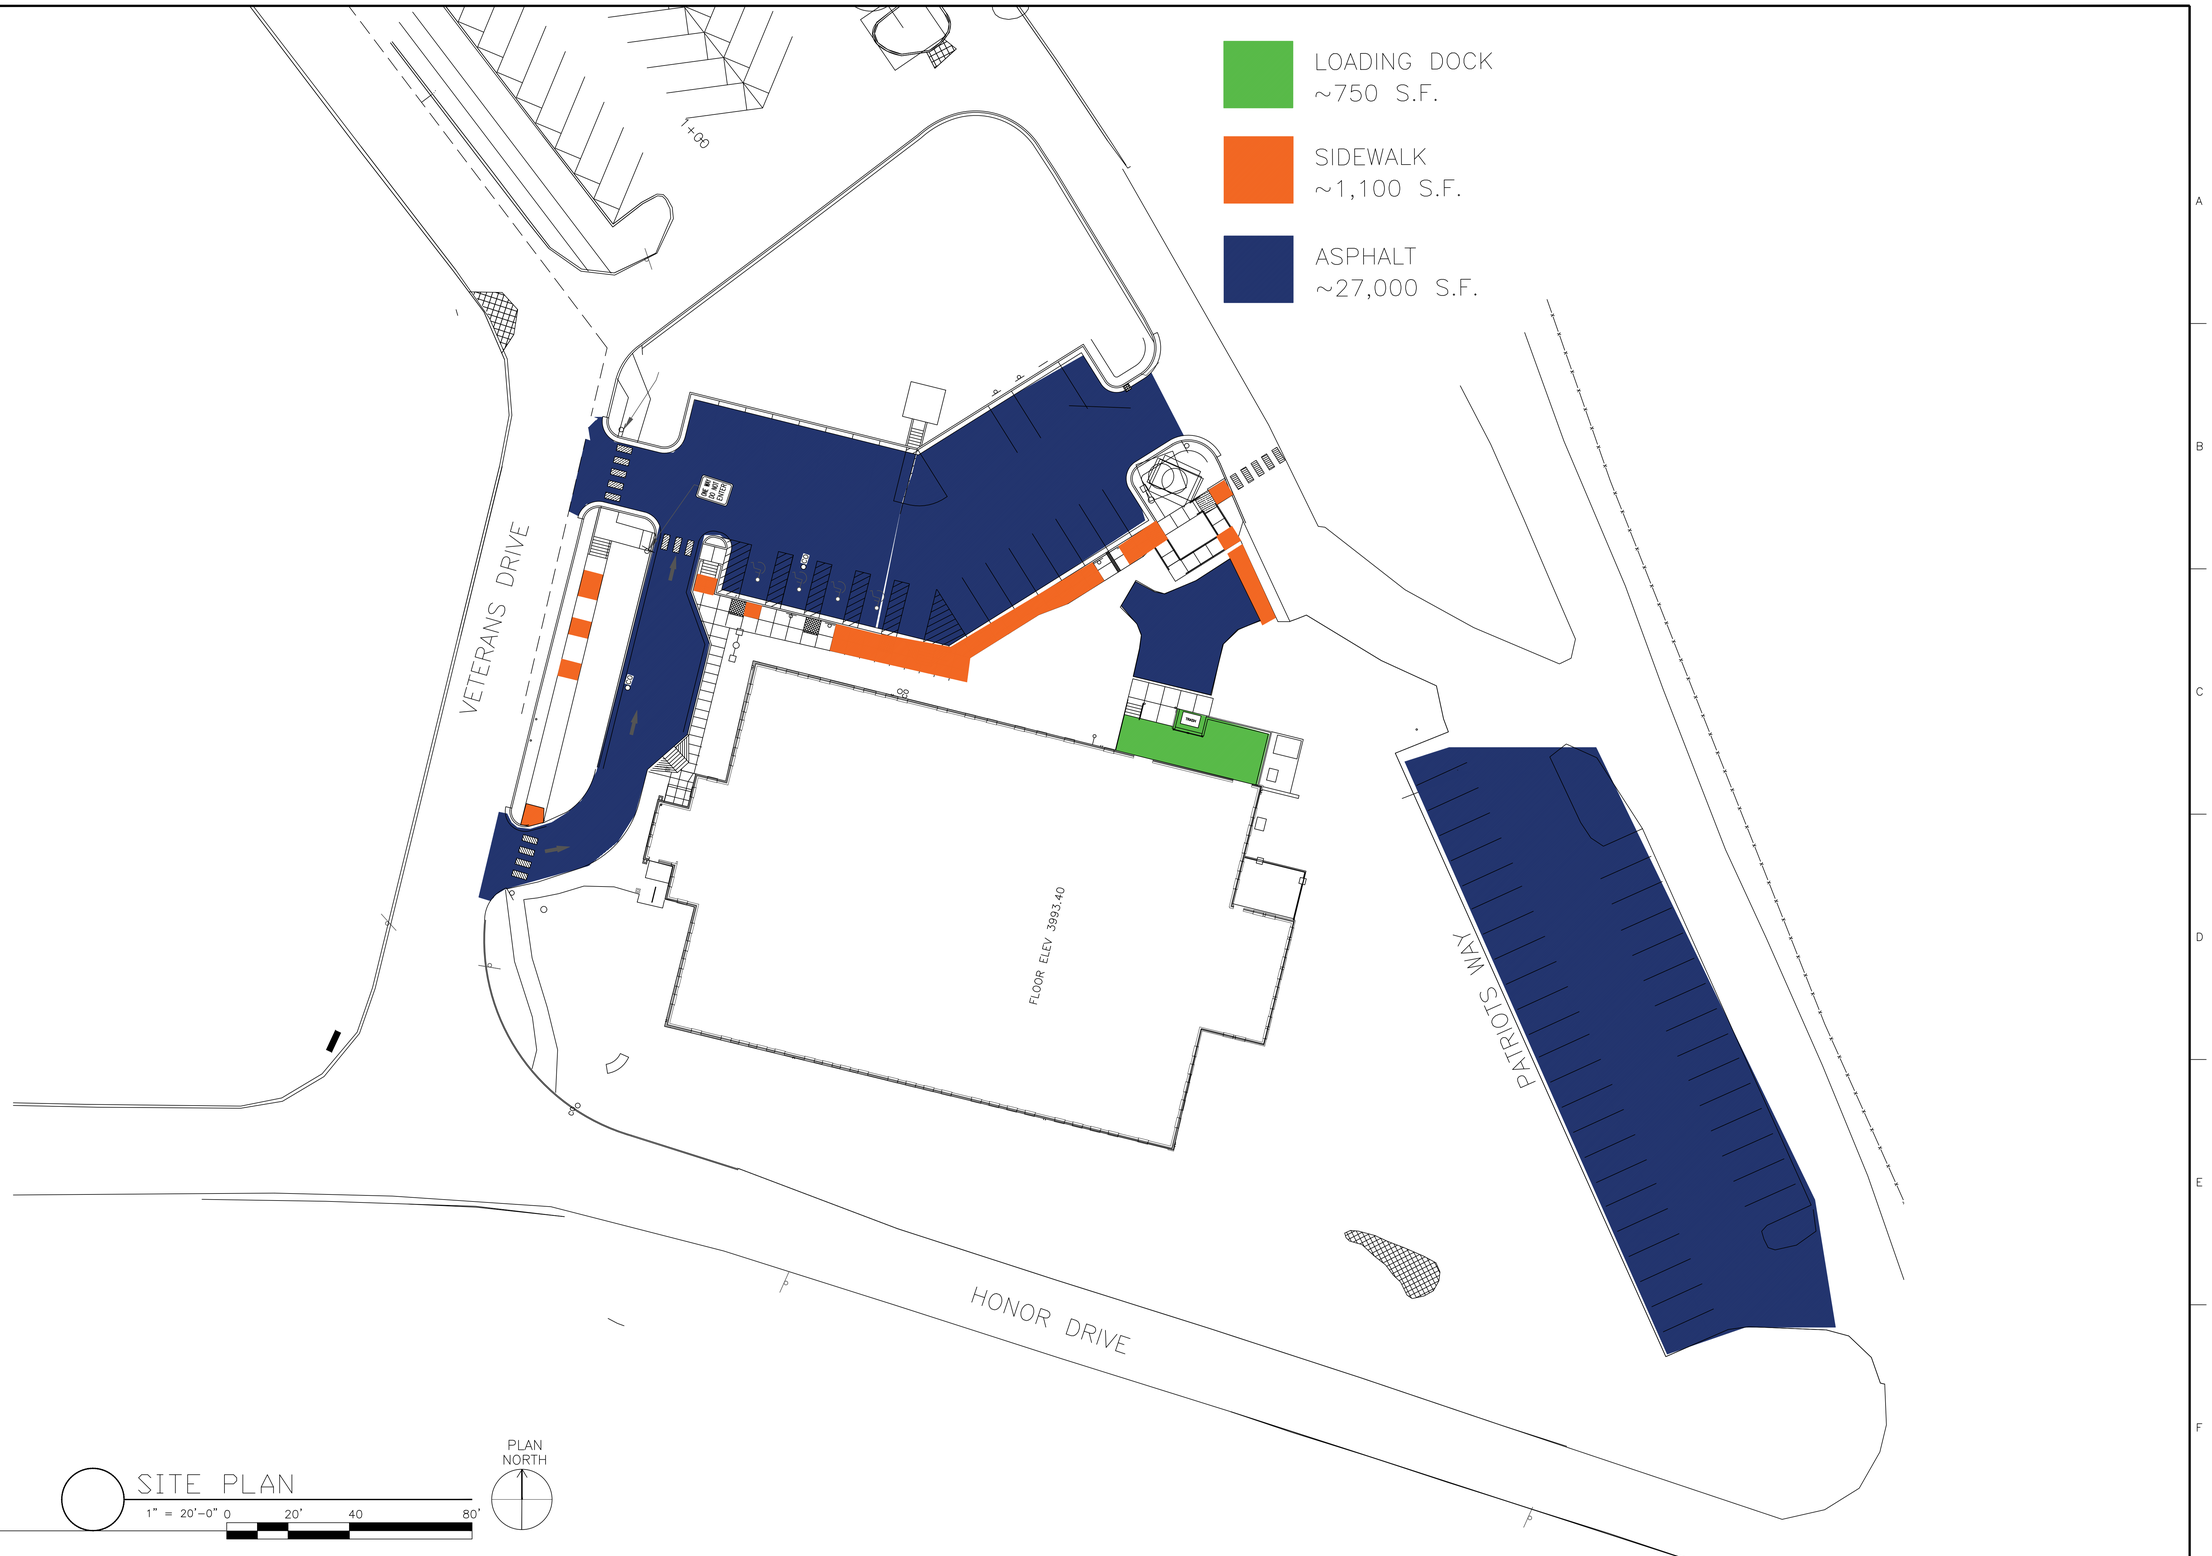

three inches = one foot
one and one half inches = one foot
one inch = one foot
three quarters inch = one foot
one half inch = one foot
three eighths inch = one foot
one quarter inch = one foot
one eighth inch = one foot

Revisions:	Date

CONSULTANTS:

ARCHITECT/ENGINEERS:

VCI Program, Project and Construction Management

Drawing Title	BUILDING 167-VBA SITE PLAN
Approved: Project Director	VAMC FORT HARRISON
Project Title	FORT HARRISON RECORD FILE DRAWINGS PHASE II
Location	FORT HARRISON, MONTANA
Date	06/23/2017
Checked	
Drawn	E.G.
Project Number	436-13-103
Building Number	167
Drawing Number	167CS101
	Dwg. 24 of 108

Office of Construction and Facilities Management

Department of Veterans Affairs

VA FORM 08-6231