


BUILDING 1 FLOOR 1

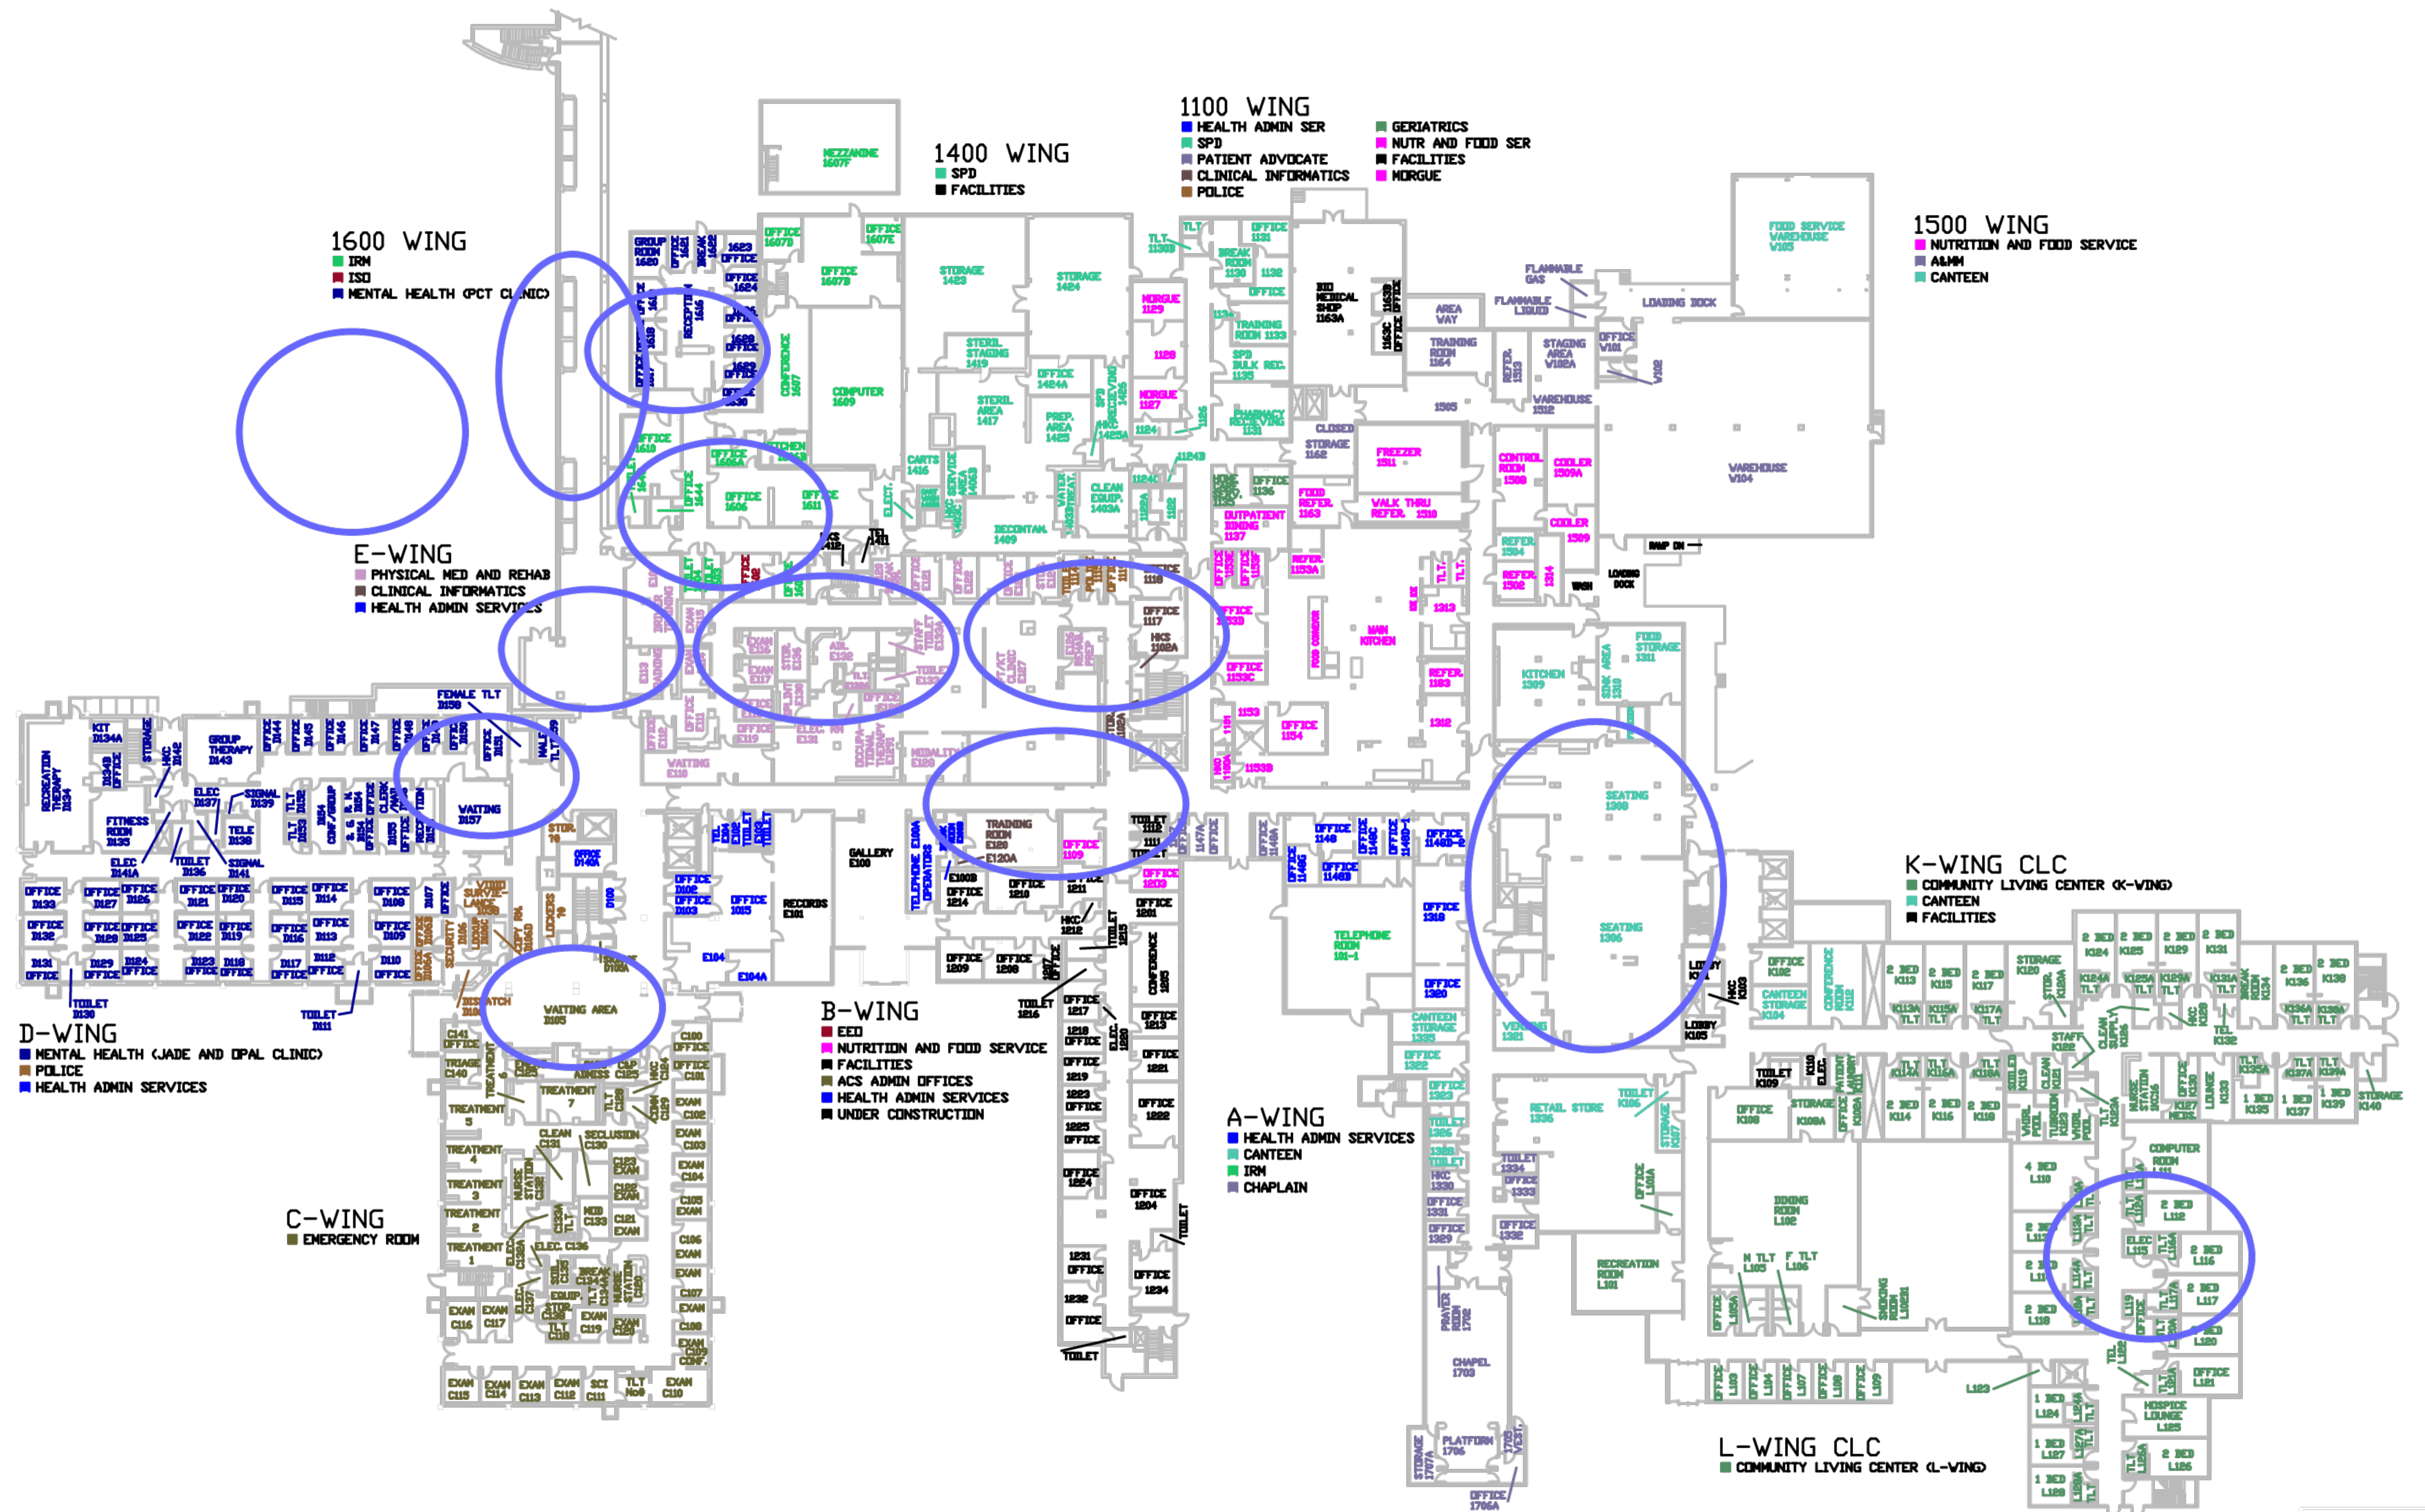

BUILDING INDEX

Drawing Title: CARL T. HAYDEN VA MEDICAL CENTER		Project Title: BUILDING 1 FY11	Date: 5/11/2011
Approved: Medical Center Director	Drawn: MN	Building Number: BLDG 1 FLOOR 1	Project No.:
Approved: Chief, Engineering Service	Checked: WRH	Location: PHOENIX VAMC	DRAWING No. Dep.1 of 16

