



CONSULTY/
CONF
5A112

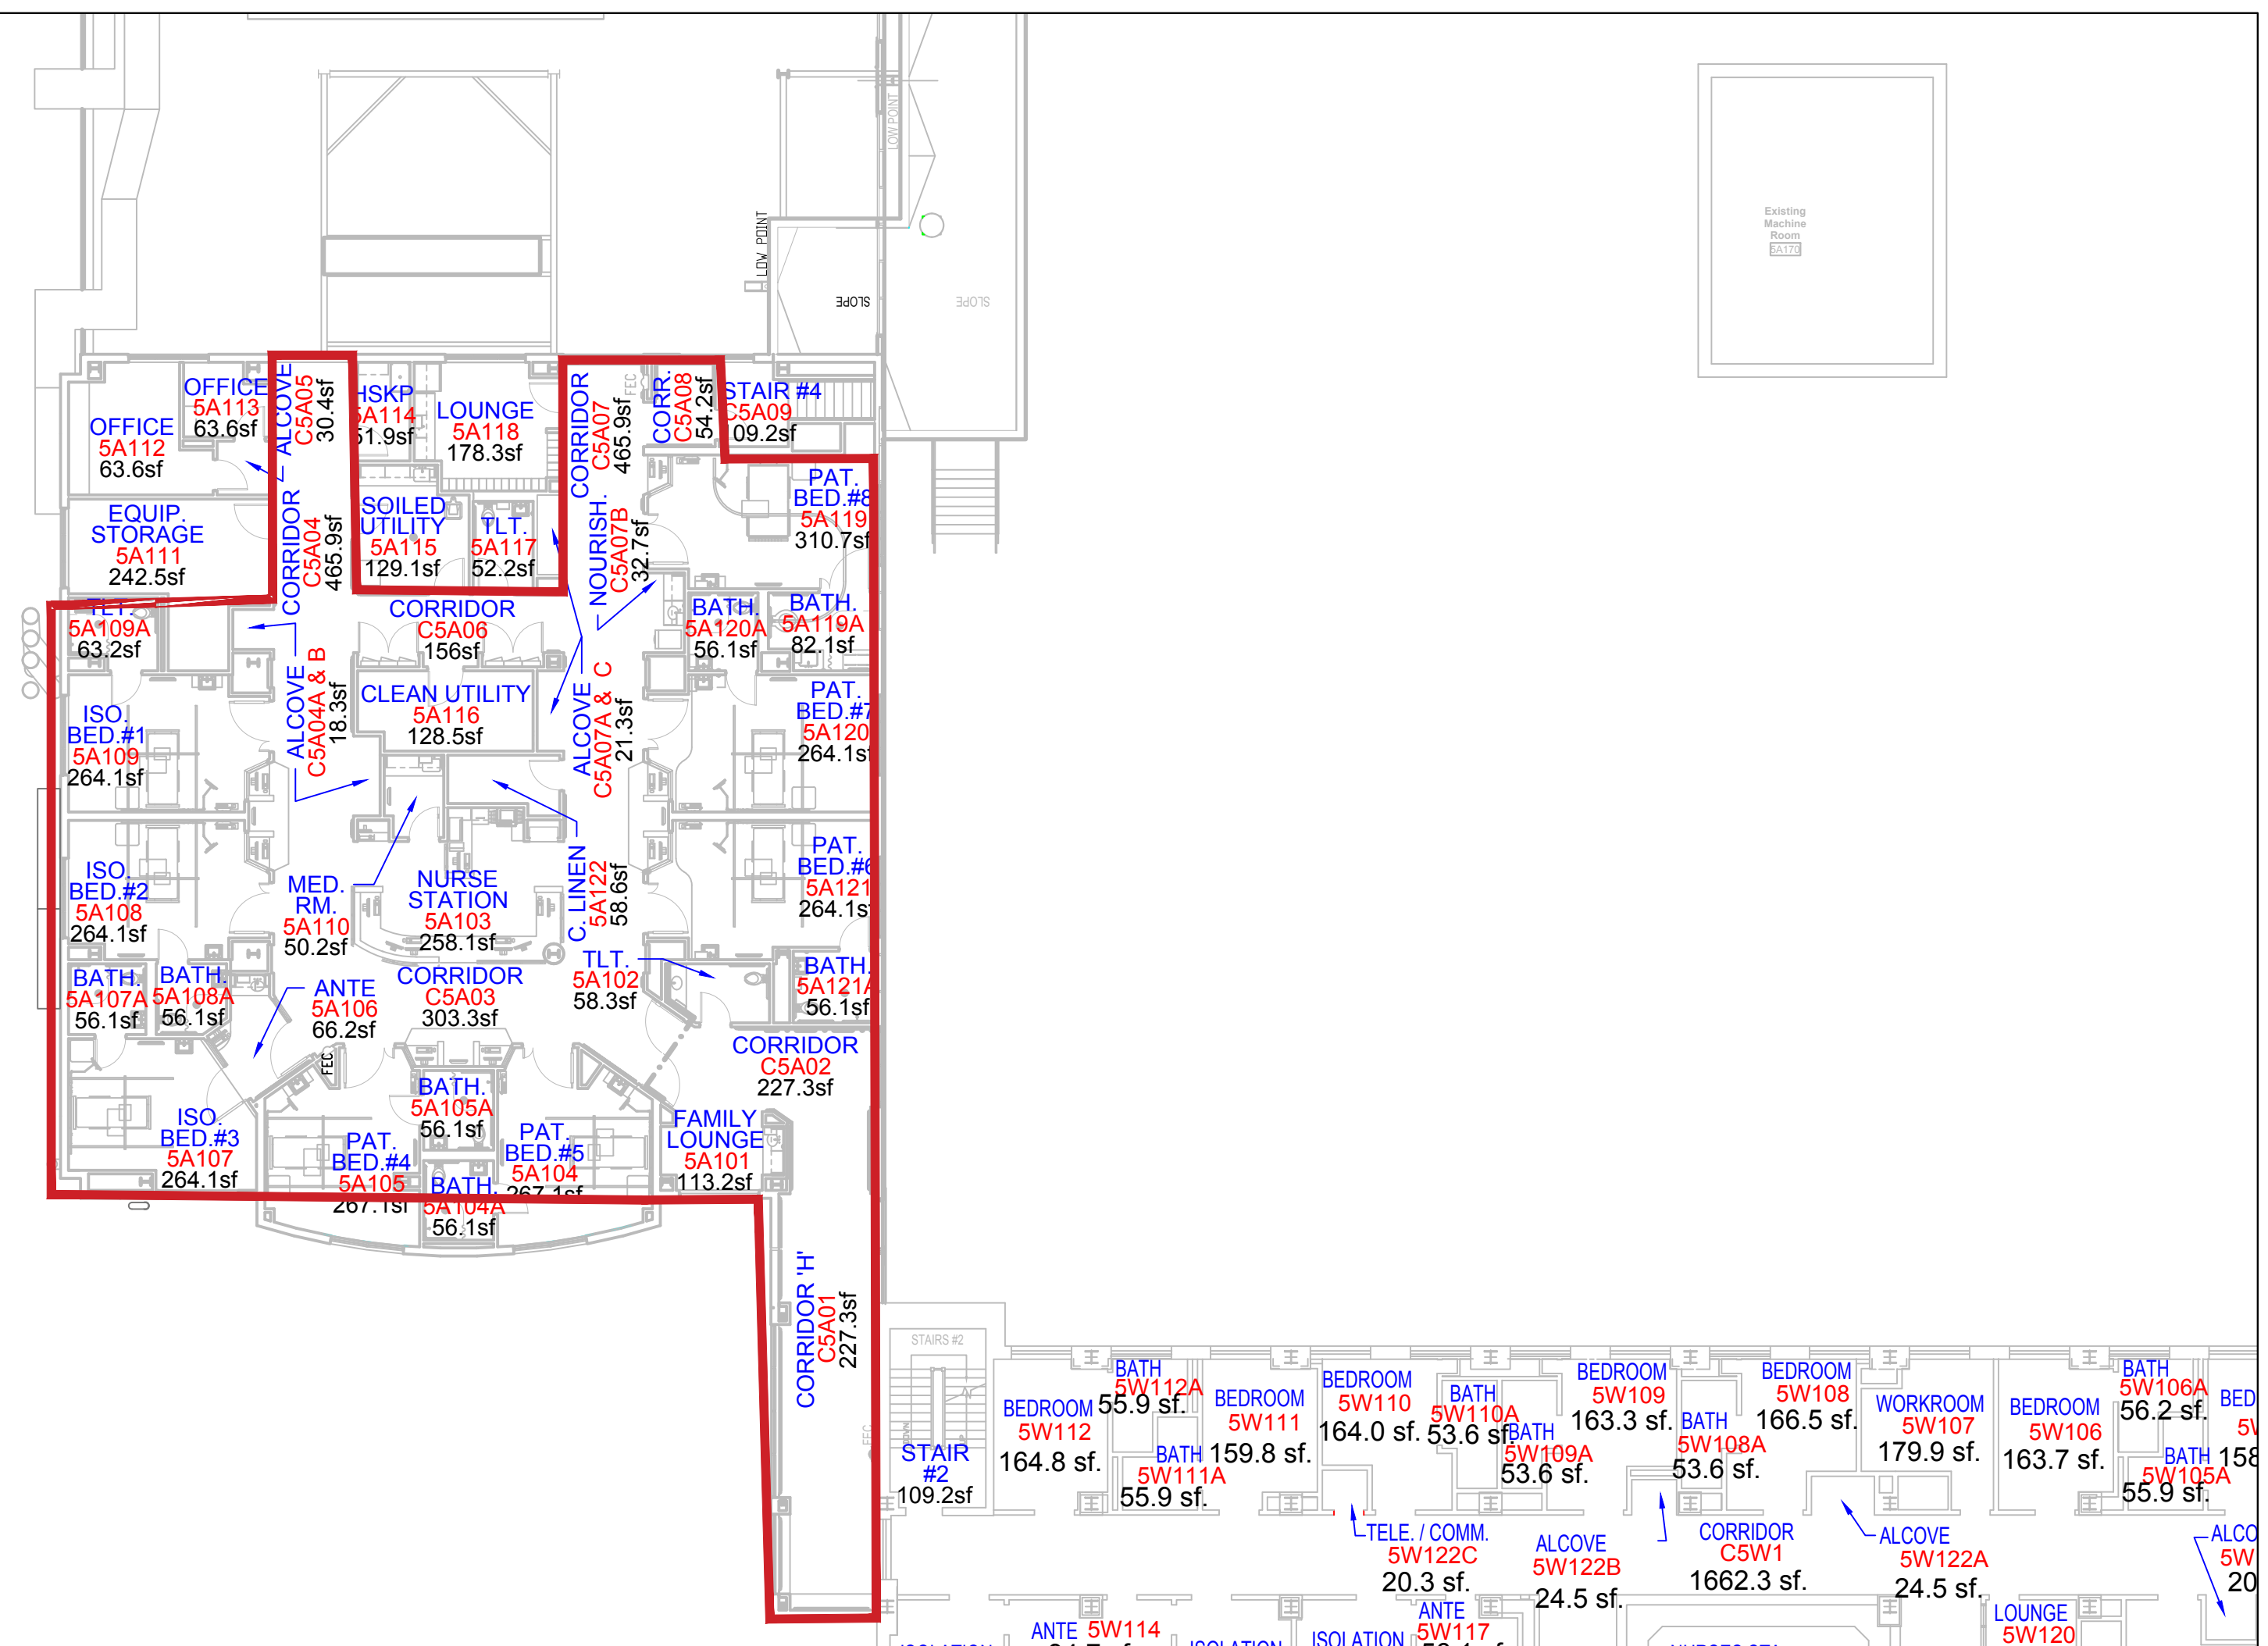

UD BUILDING 1

REFERENCE ONLY
(NOT TO BE USED FOR
CONSTRUCTION)

Approved: Director, VA Pittsburgh Healthcare System	Drawing Title FIFTH FLOOR WEST	Project Title RECORD ARCHITECTURALS			Date 8/10/2015	<div>Office of Facilities Management</div> <div> VA PITTSBURGH HEALTHCARE SYSTEM UNIVERSITY DRIVE DIVISION PITTSBURGH, PA 15240</div>
Approved: Chief Operating Officer					Project No.	
Approved: Vice President, Facilities Management	Approved: Site Manager	Building No. B1	Scale NTS	Drawn DM	DRAWING NO. 1 of 1	
Approved: Manager, Projects Section	Approved:	Location VA PITTSBURGH HEALTHCARE SYSTEM UNIVERSITY DRIVE DIVISION PITTSBURGH, PA 15240				