


three inches = one foot
one and one half inches = one foot
one inch = one foot
three quarters inch = one foot
one half inch = one foot
three eighths inch = one foot
one quarter inch = one foot
one eighth inch = one foot

1 2 3 4 5 6 7 8 9

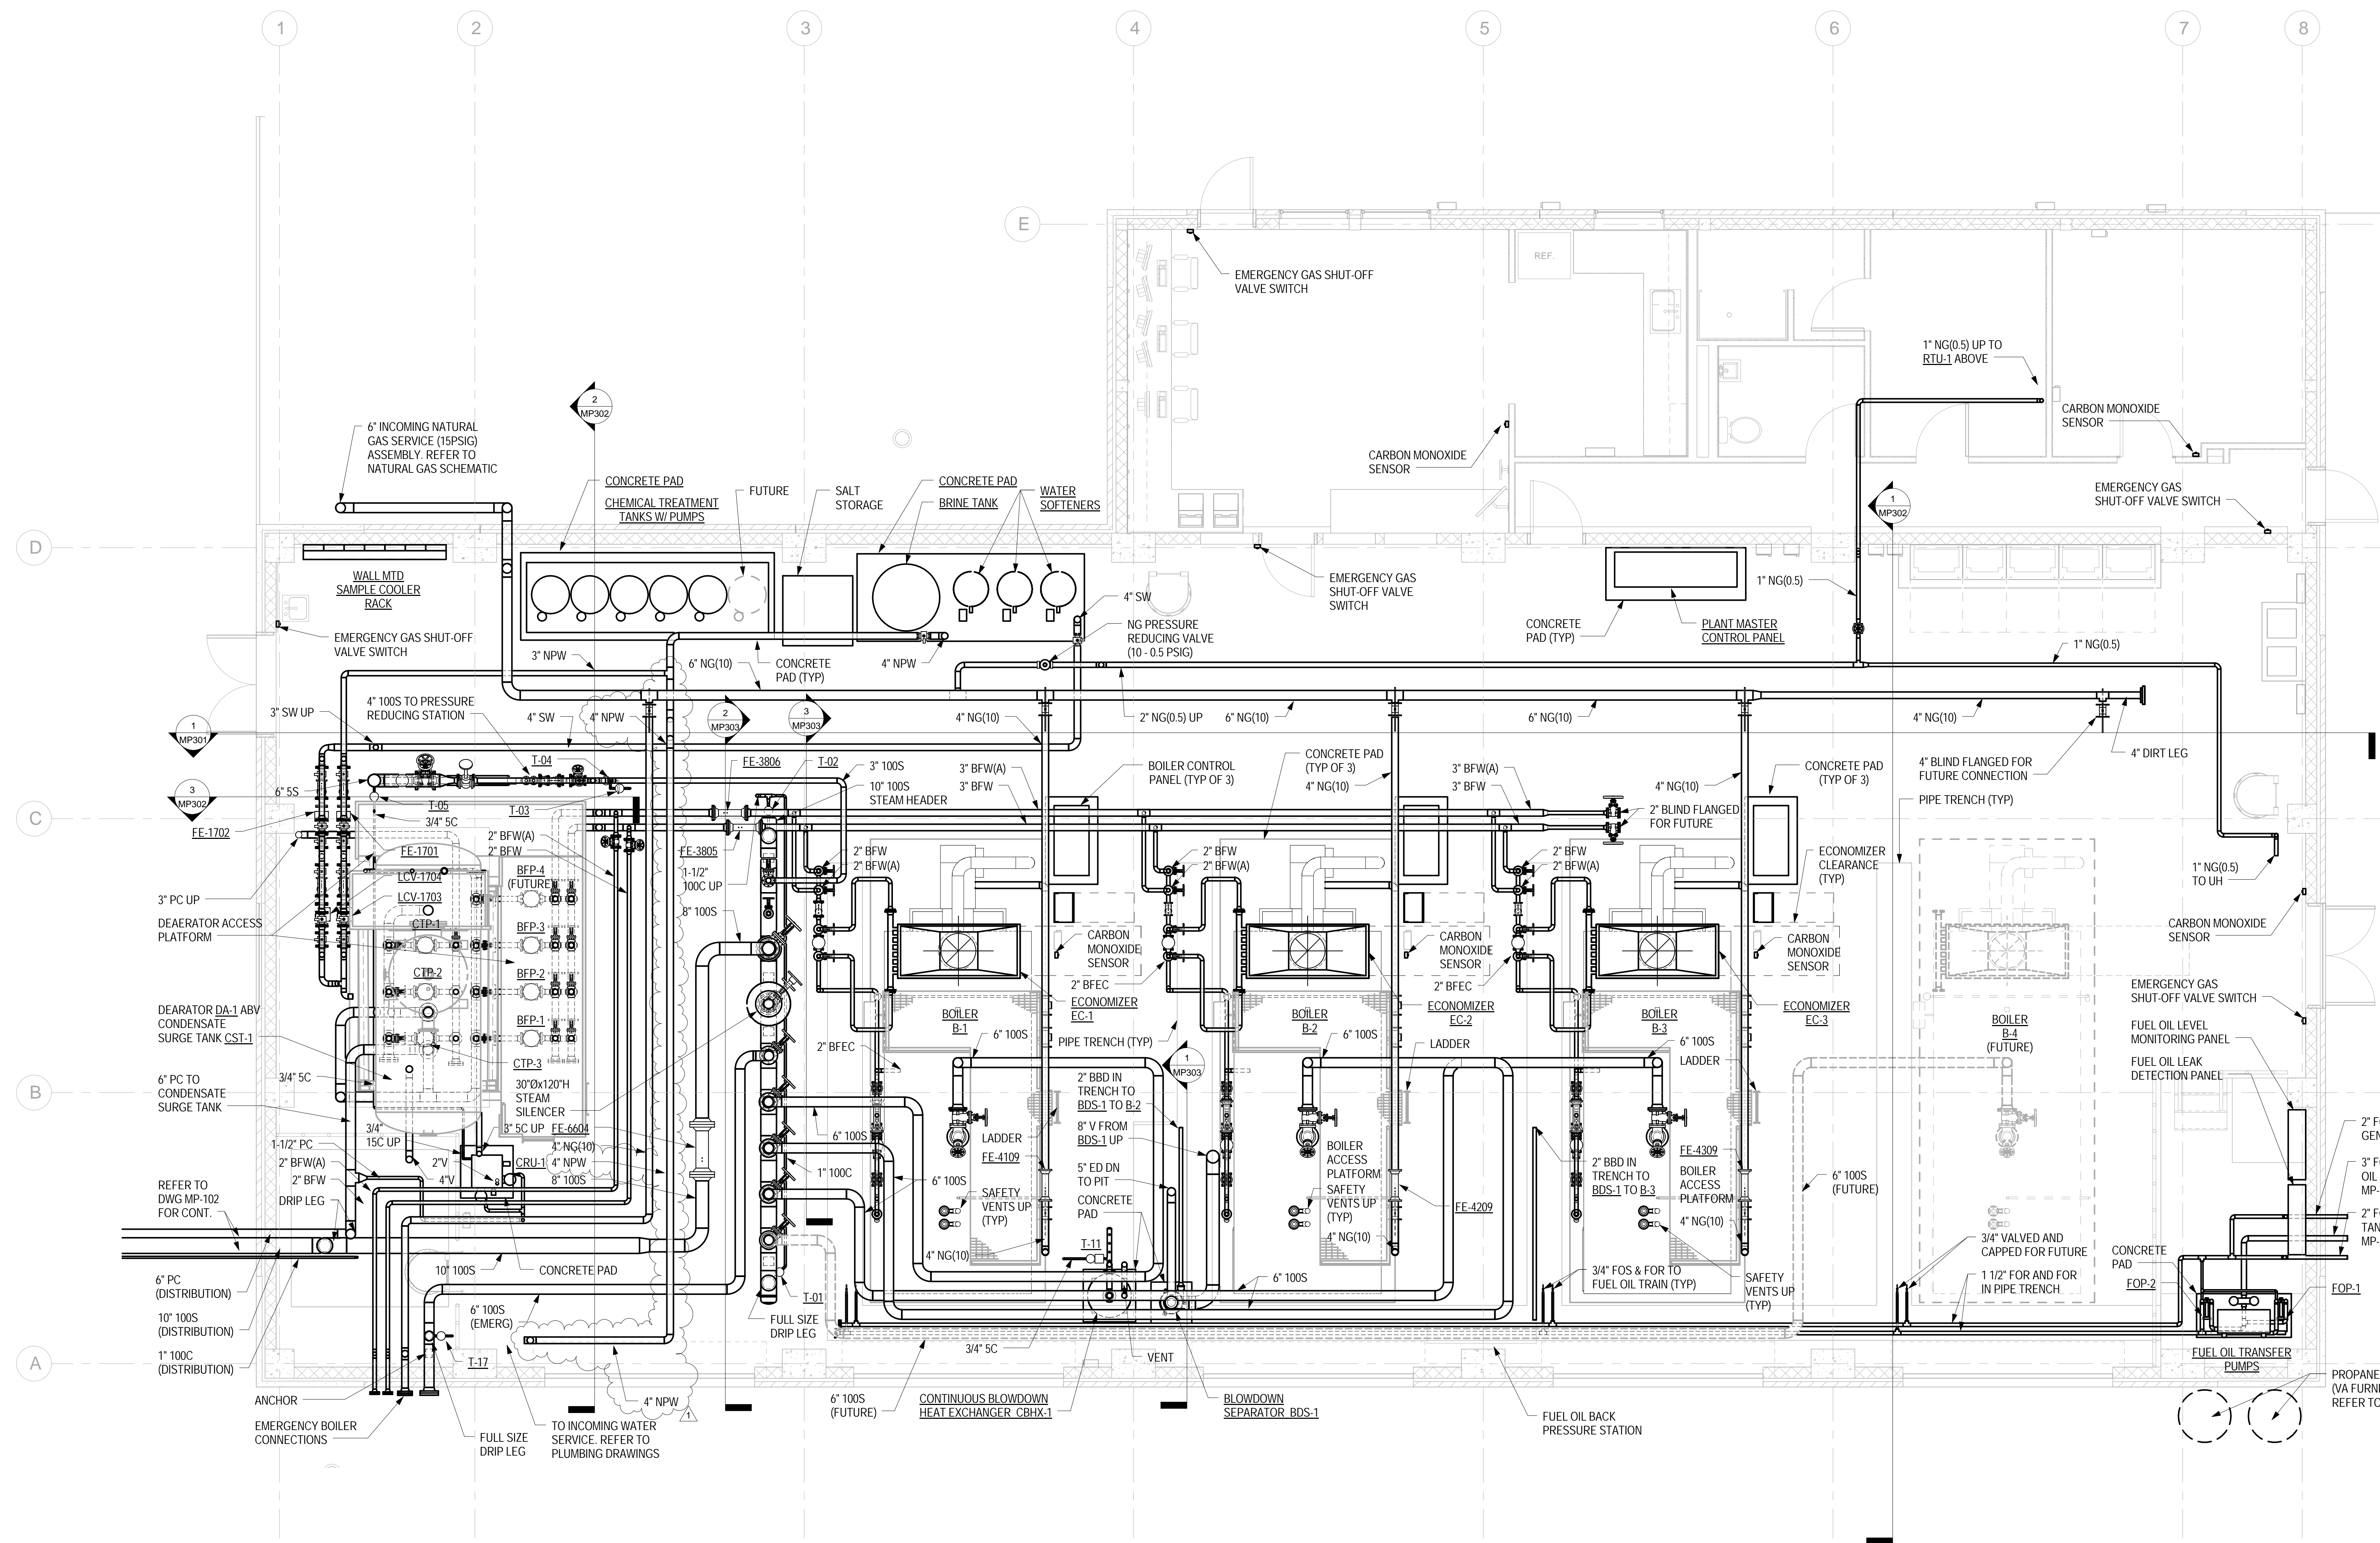

BOILER PLANT - GROUND FLOOR - MECHANICAL
1/4" = 1'-0"

FINAL DESIGN
APPROVED FOR CONSTRUCTION

		<div>CONSULTANTS:</div> <div><div><div><div></div></div><div>Affiliated Engineers</div></div><div>Affiliated Engineers SE, Inc. Triega Town Center 12921 SW 1st Road Ste 205 Gainesville, Florida 32609 Tel 352.376.5500 Fax 352.375.3479 CA-6140</div></div>	
--	--	---	--	--	