


three inches = one foot  
 one and one half inches = one foot  
 one inch = one foot  
 three quarters inch = one foot  
 one half inch = one foot  
 three eighths inch = one foot  
 one quarter inch = one foot  
 one eighth inch = one foot

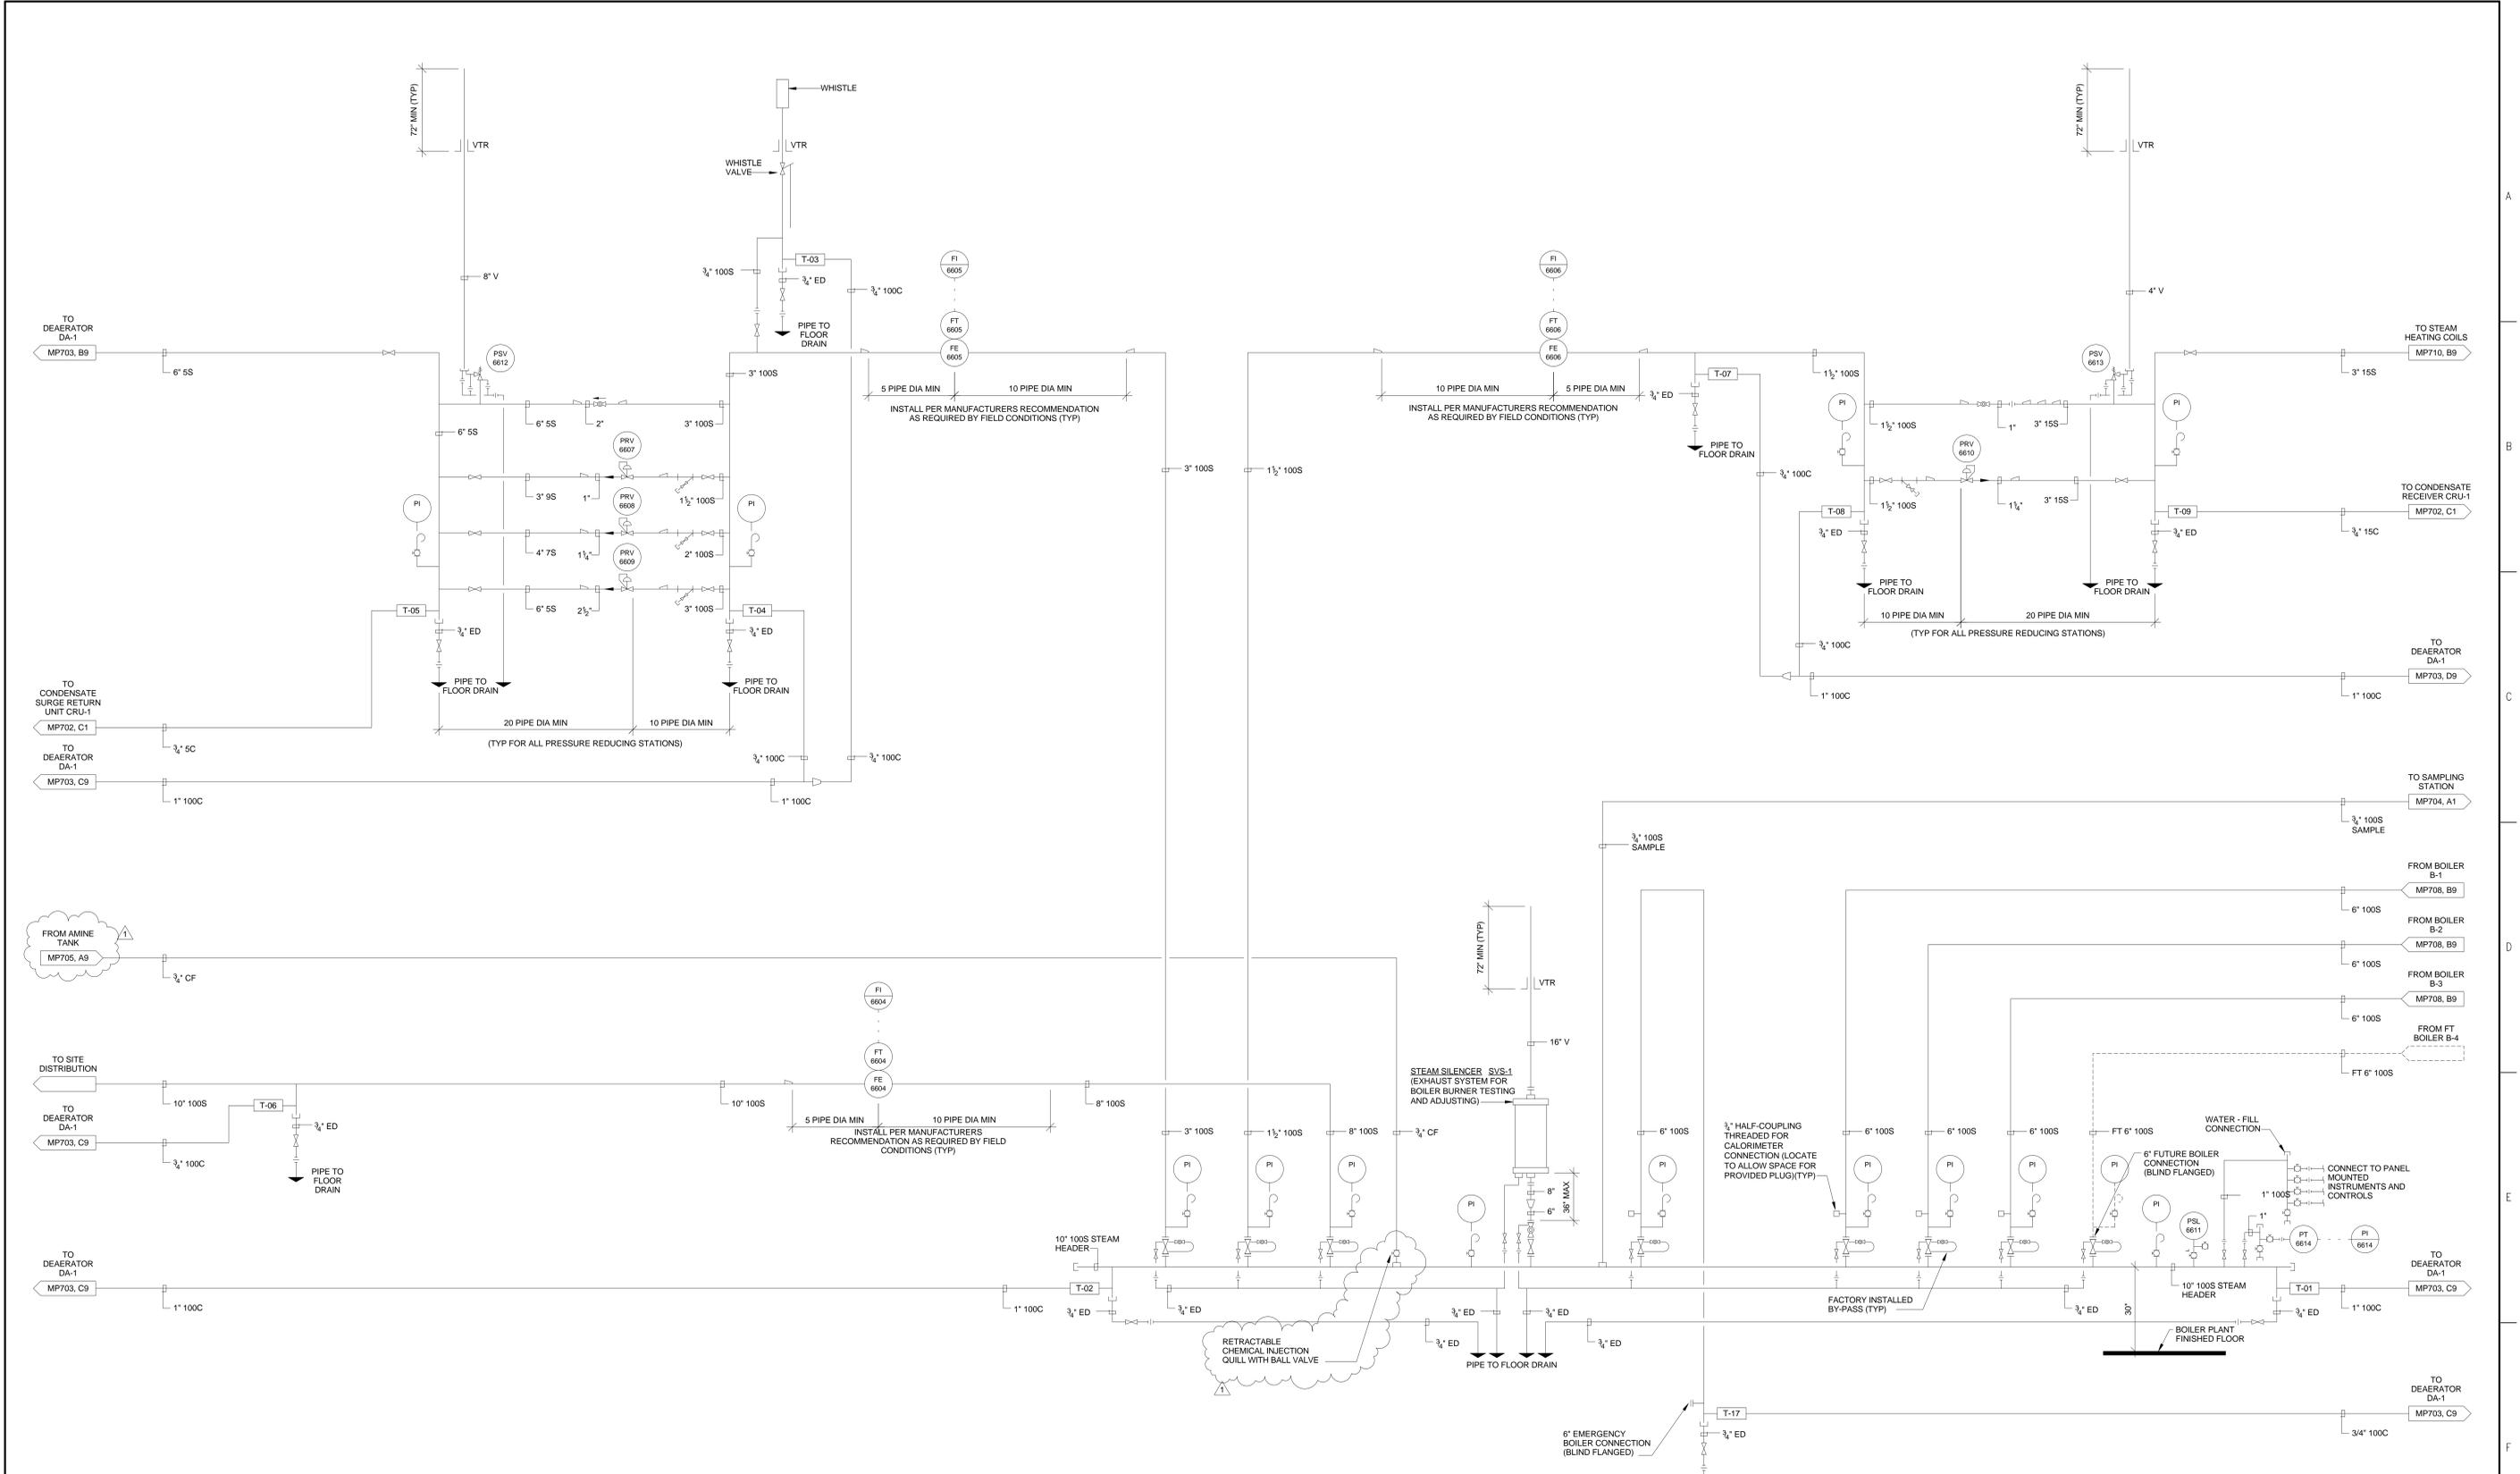

STEAM SYSTEM SCHEMATIC

FINAL DESIGN  
 APPROVED FOR CONSTRUCTION

<b>CONSULTANTS:</b>  Affiliated Engineers SE, Inc. Tioga Town Center 12921 SW 1st Road Ste 205 Gainesville, Florida 32669 Tel 352.376.5500 Fax 352.375.3479 CA-5140		ENGINEER-OF-RECORD JACK STEWART NEALE F.L.P.E. NO. 42678		<b>ARCHITECT/ENGINEERS:</b>  3603 NW 98th Street, Suite B Gainesville, FL 32606 Phone: (352) 474-6124 Fax: (352) 553-4437 COA: FL #26693 AKEA Project No. 083-14		Drawing Title <b>STEAM SYSTEM SCHEMATIC</b>		Project Title <b>REPLACE BOILERS - FCA D, ENERGY AT THE MALCOM RANDALL VAMC</b>		Project Number <b>573-14-600</b> Building Number		Office of Construction and Facilities Management			
1 - Addendum #2 Revisions:		Date 08/30/17		Approved: Project Director		Location <b>GAINESVILLE, FLORIDA</b>		Drawing Number <b>MP701</b>		Date <b>JULY 8, 2016</b>		Checked JSN		Drawn RWD	