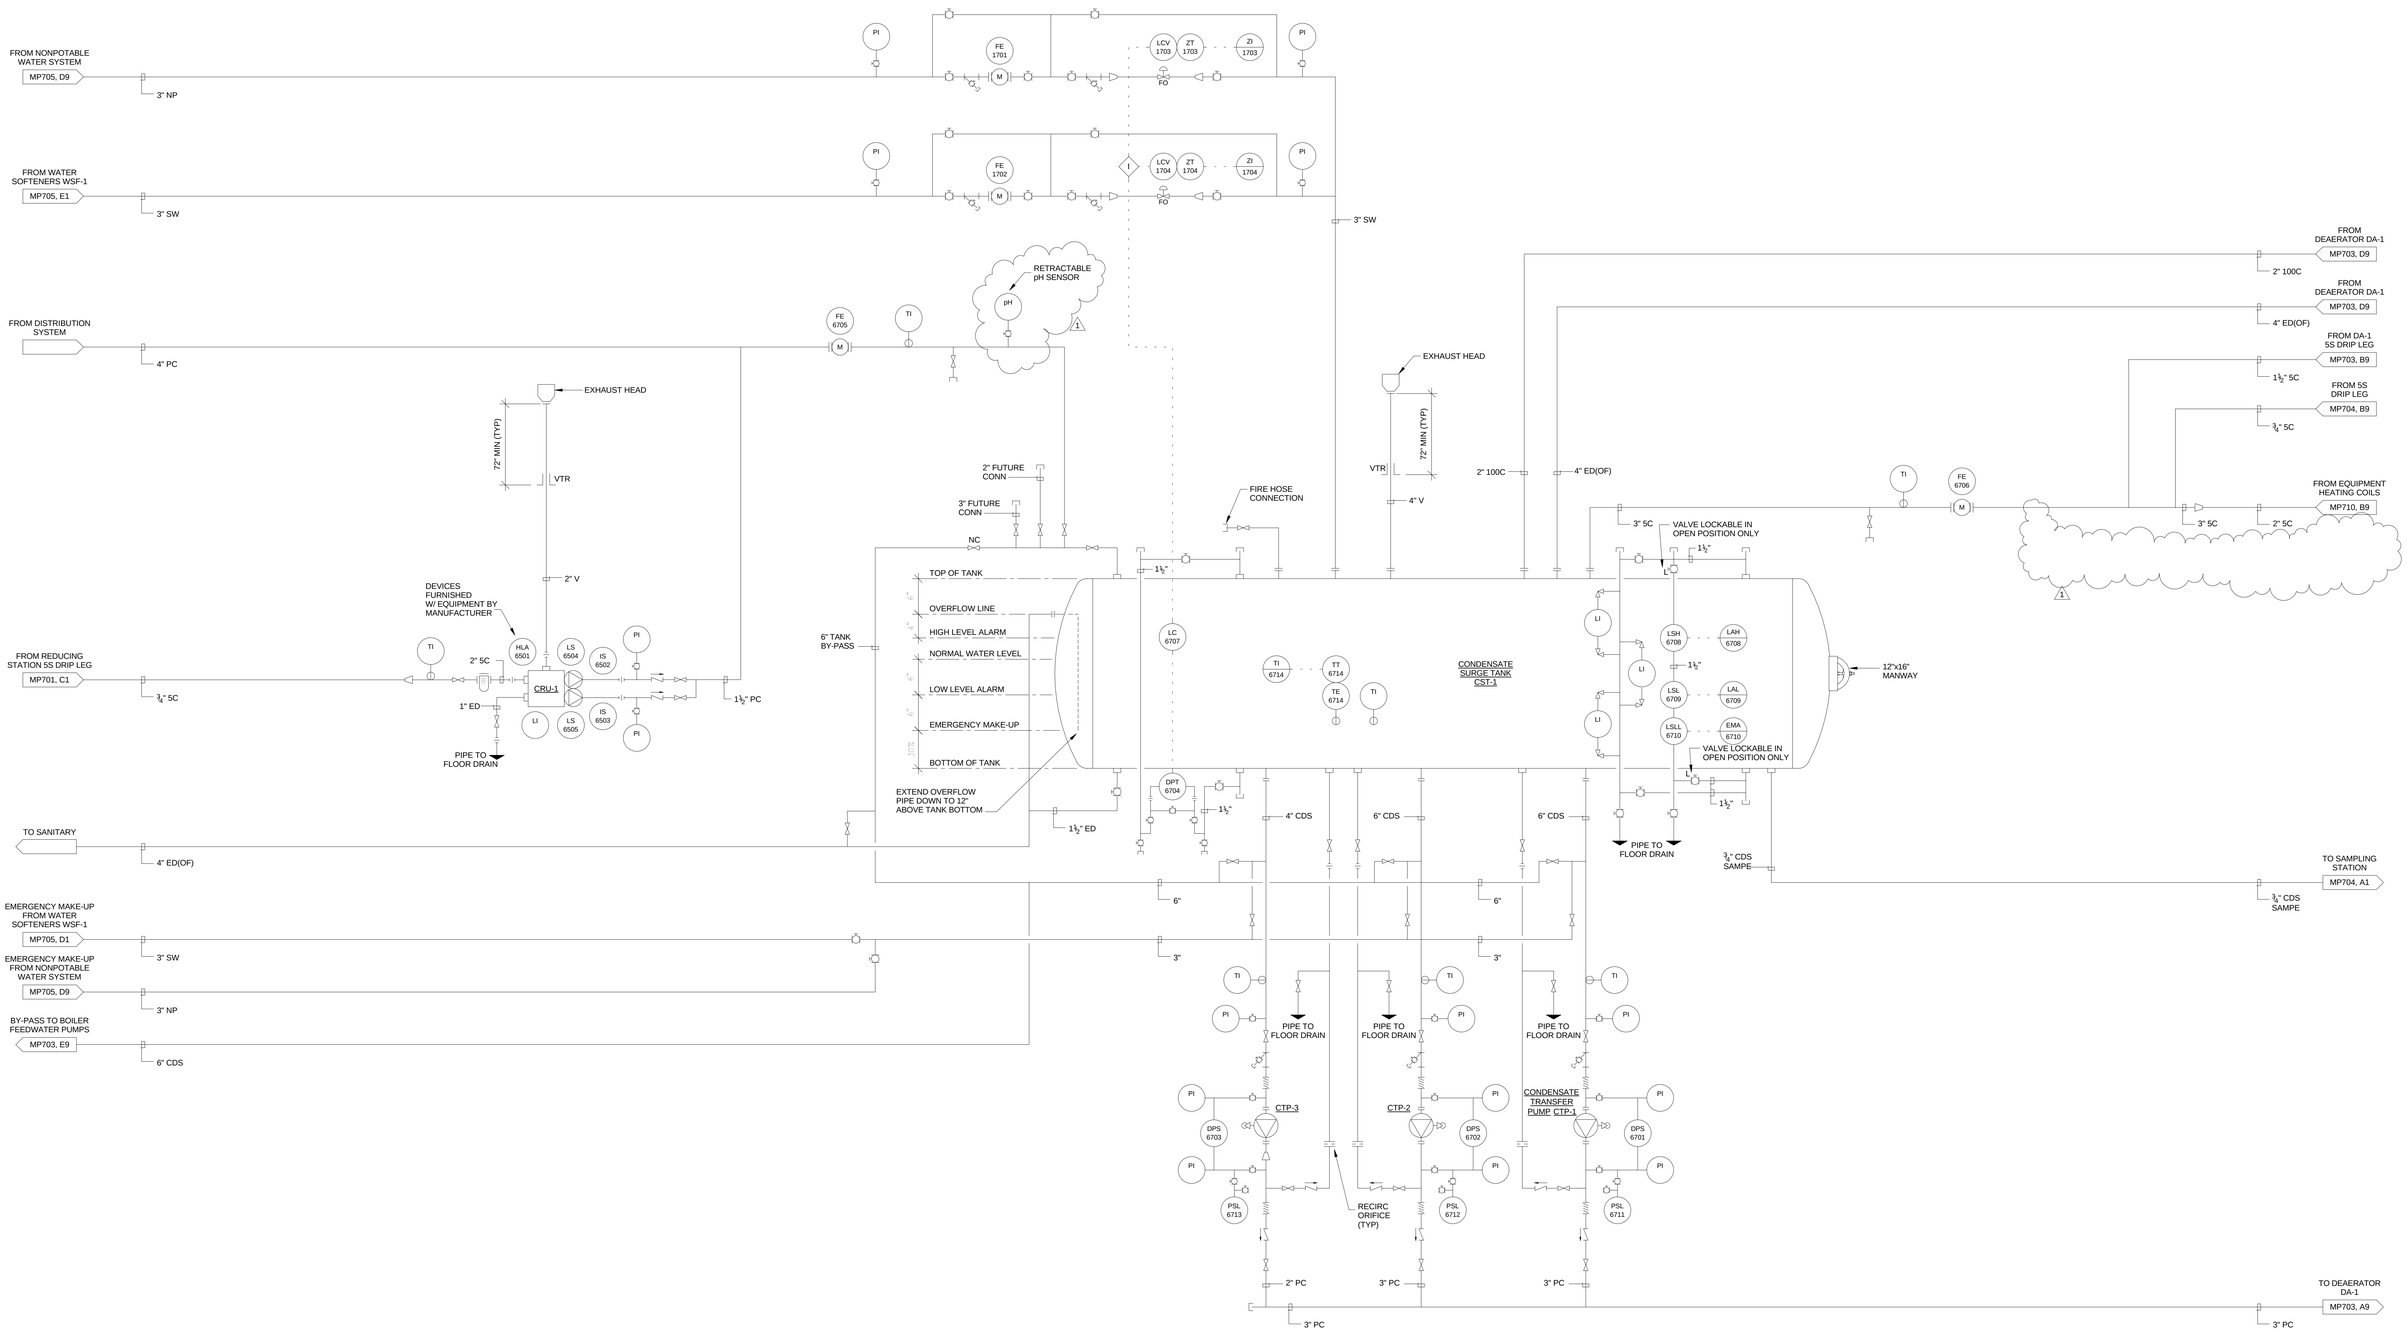

CONDENSATE SYSTEM SCHEMATIC

FINAL DESIGN
APPROVED FOR CONSTRUCTION

1 - Addendum #2	08/30/17
Revisions:	**Date**

CONSULTANTS:

Affiliated Engineers
Affiliated Engineers SE, Inc.
Tioga Town Center
12921 SW 1st Road Ste 205
Gainesville, Florida 32669
Tel 352.376.5500 Fax 352.375.3479
CA-5140

ENGINEER-OF-RECORD JACK STEWART NEALE FL. P.E. NO. 42678

ARCHITECT/ENGINEERS:

AKEA INC.
3603 NW 98th Street, Suite B
Gainesville, FL 32606
Phone: (352) 474-6124
Fax: (352) 553-4437
COA: FL #26693
AKEA Project No. 083-14

Drawing Title: CONDENSATE SYSTEM SCHEMATIC
Approved: Project Director
Project Title: REPLACE BOILERS - FCA D, ENERGY AT THE MALCOM RANDALL VAMC
Location: GAINESVILLE, FLORIDA
Date: JULY 8, 2016 | Checked: JSN | Drawn: RWD
Project Number: 573-14-600
Building Number:
Drawing Number: MP702

Office of Construction and Facilities Management

VA FORM 08-6231