

three inches = one foot

one and one half inches = one foot

one inch = one foot


three quarters inch = one foot

one half inch = one foot

three eighths inch = one foot

one quarter inch = one foot

one eighth inch = one foot

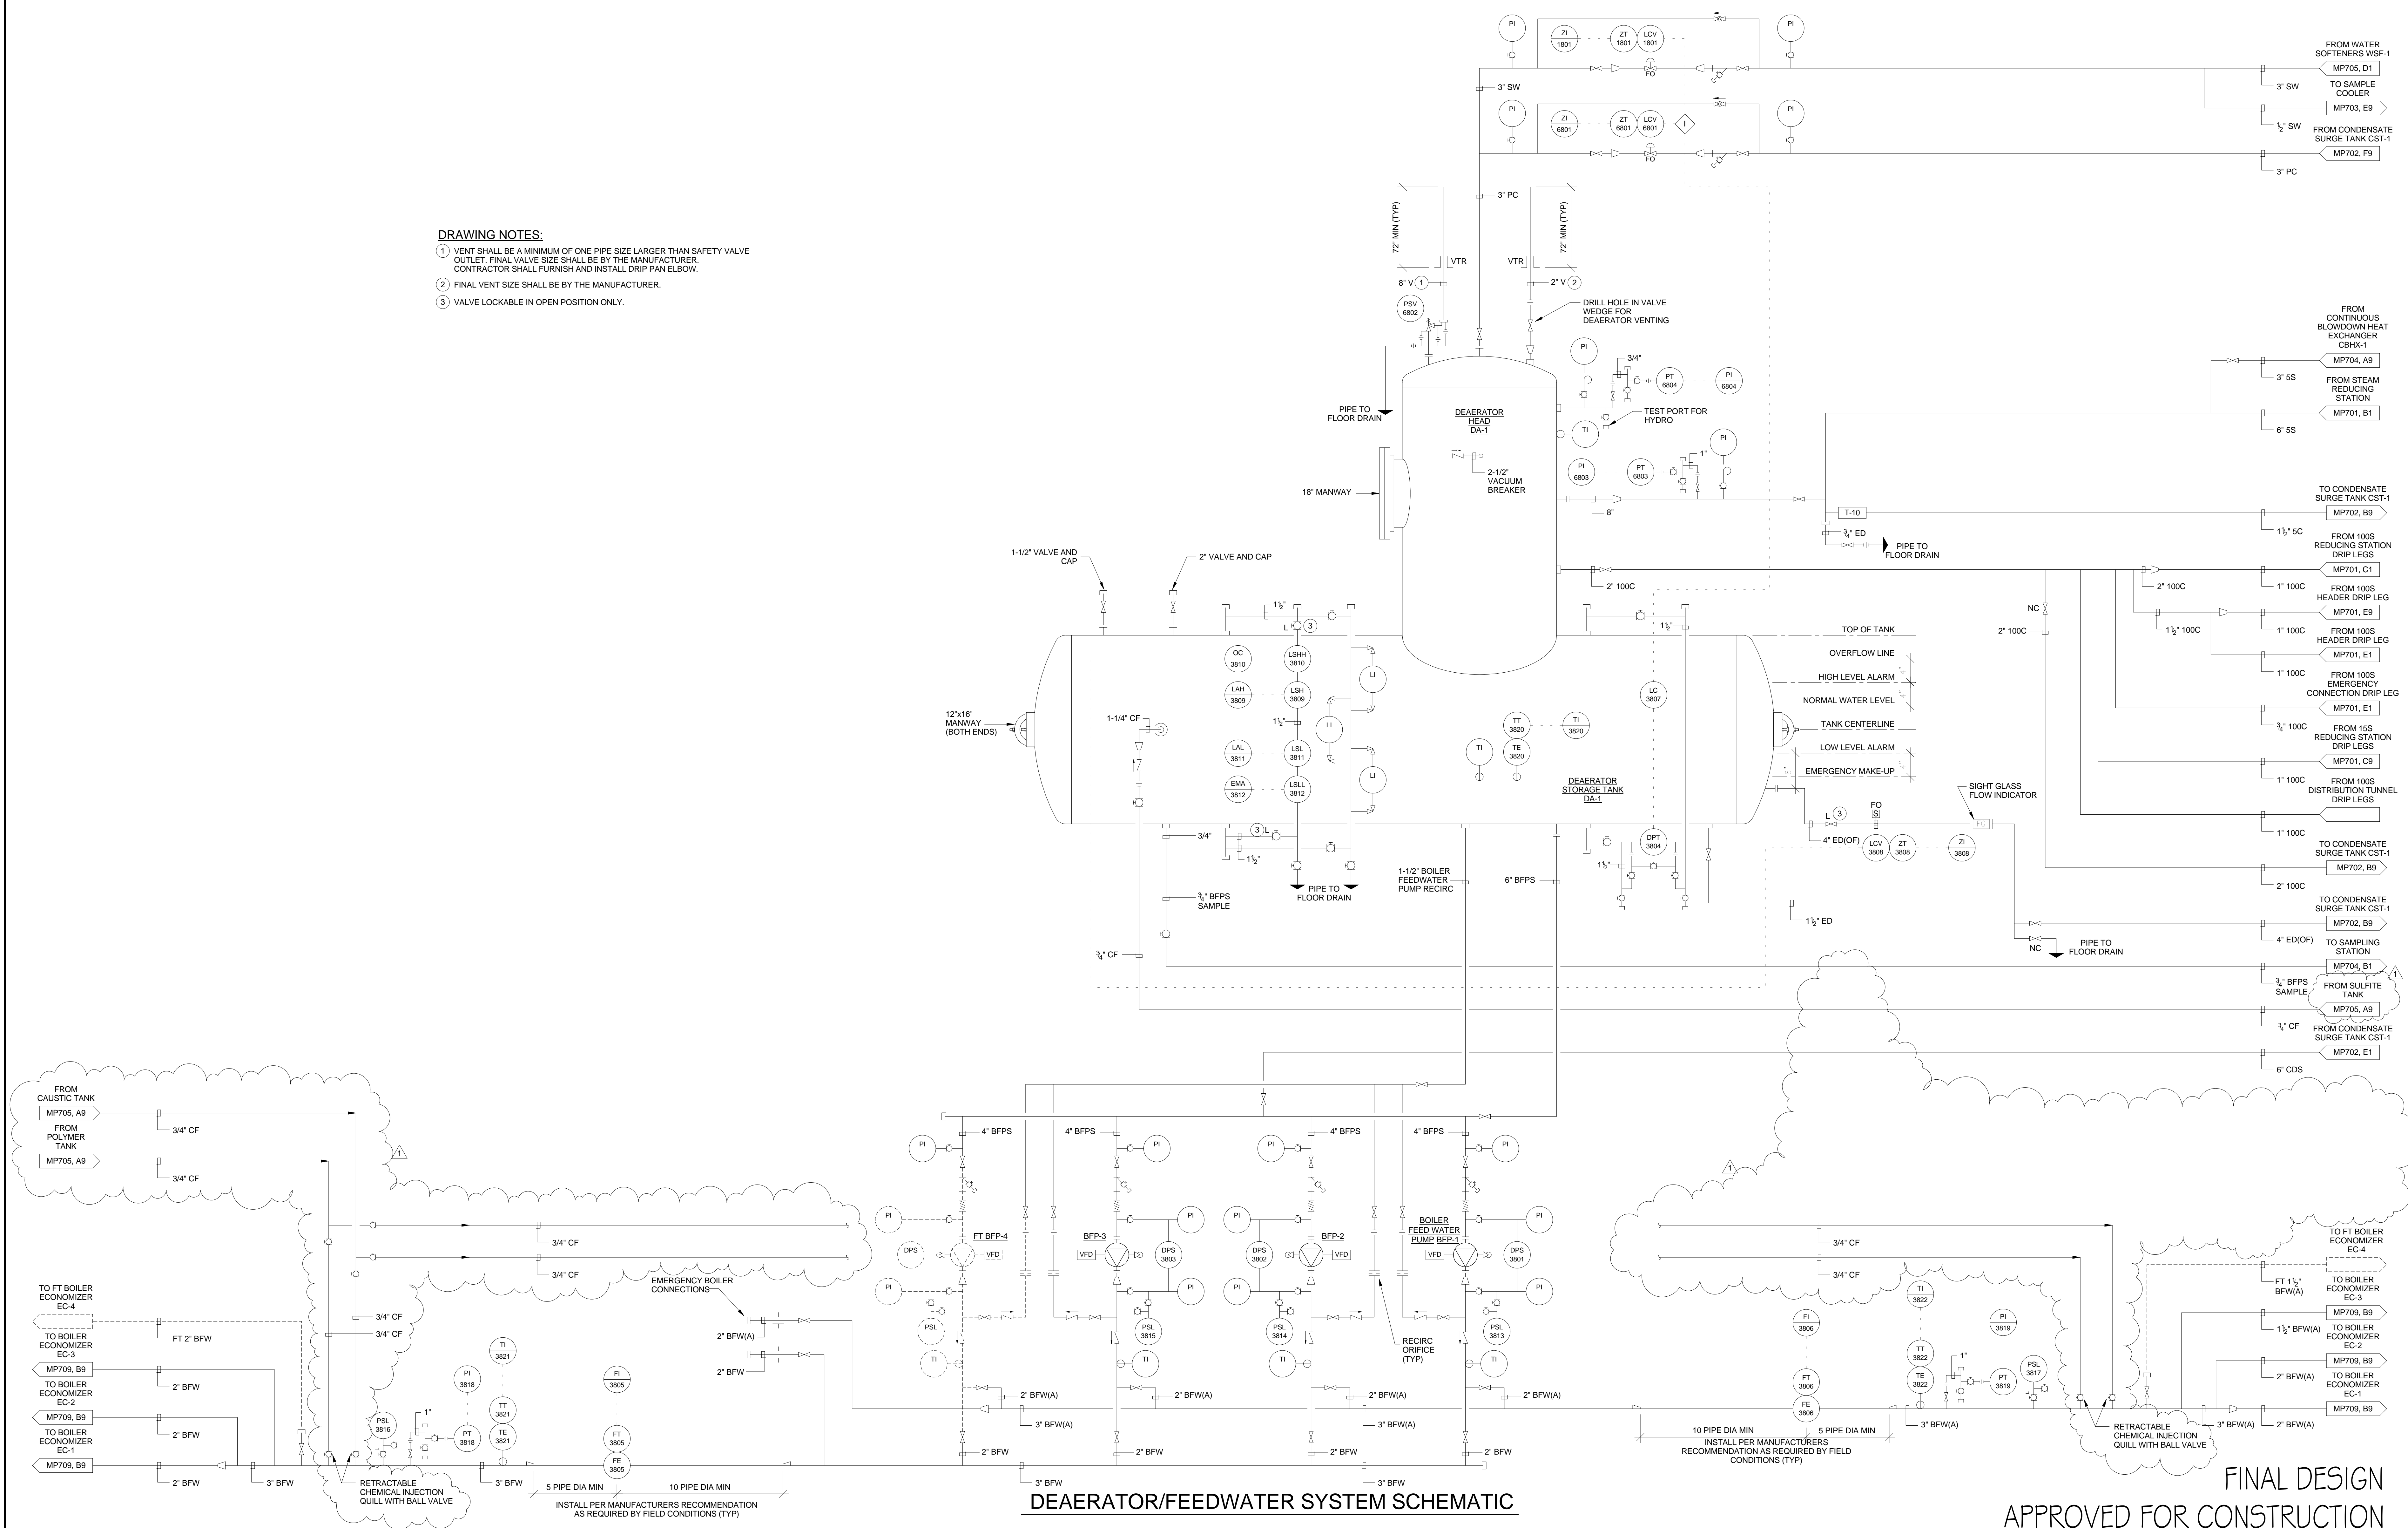

DEAERATOR/FEEDWATER SYSTEM SCHEMATIC

FINAL DESIGN
APPROVED FOR CONSTRUCTION

<div>CONSULTANTS:</div> <div><div><div><div></div></div><div>Affiliated Engineers</div></div><div><div>Affiliated Engineers SE, Inc.</div><div>Trioga Town Center</div><div>12921 SW 1st Road Ste 205</div><div>Gainesville, Florida 32669</div><div>Tel 352.376.5500 Fax 352.375.3479</div><div>CA-6140</div></div></div>		<div>ENGINEER-OF-RECORD</div> <div>JACK STEWART NEALE</div> <div>FL P.E. NO. 42678</div>		<div>ARCHITECT/ENGINEERS:</div> <div><div><div>AKEA</div><div>INC.</div></div><div>3603 NW 98th Street, Suite B</div><div>Gainesville, FL 32606</div><div>Phone: (352) 474-6124</div><div>Fax: (352) 553-4437</div><div>COA: FL #26693</div><div>AKEA Project No. 083-14</div></div>		<div>Drawing Title</div> <div>DEAERATOR/FEEDWATER SYSTEM SCHEMATIC</div> <div>Approved: Project Director</div>		<div>Project Title</div> <div>REPLACE BOILERS - FCA D, ENERGY AT THE MALCOM RANDALL VAMC</div> <div>Location</div> <div>GAINESVILLE, FLORIDA</div> <div>Date</div> <div>JULY 8, 2016</div> <div>Checked</div> <div>JSN</div> <div>Drawn</div> <div>RWD</div>		<div>Project Number</div> <div>573-14-600</div> <div>Building Number</div> <div></div> <div>Drawing Number</div> <div>MP703</div>		<div>Office of Construction and Facilities Management</div>	
--	--	--	--	--	--	--	--	--	--	---	--	---	--