


three inches = one foot
one and one half inches = one foot
one inch = one foot
three quarters inch = one foot
one half inch = one foot
three eighths inch = one foot
one quarter inch = one foot
one eighth inch = one foot

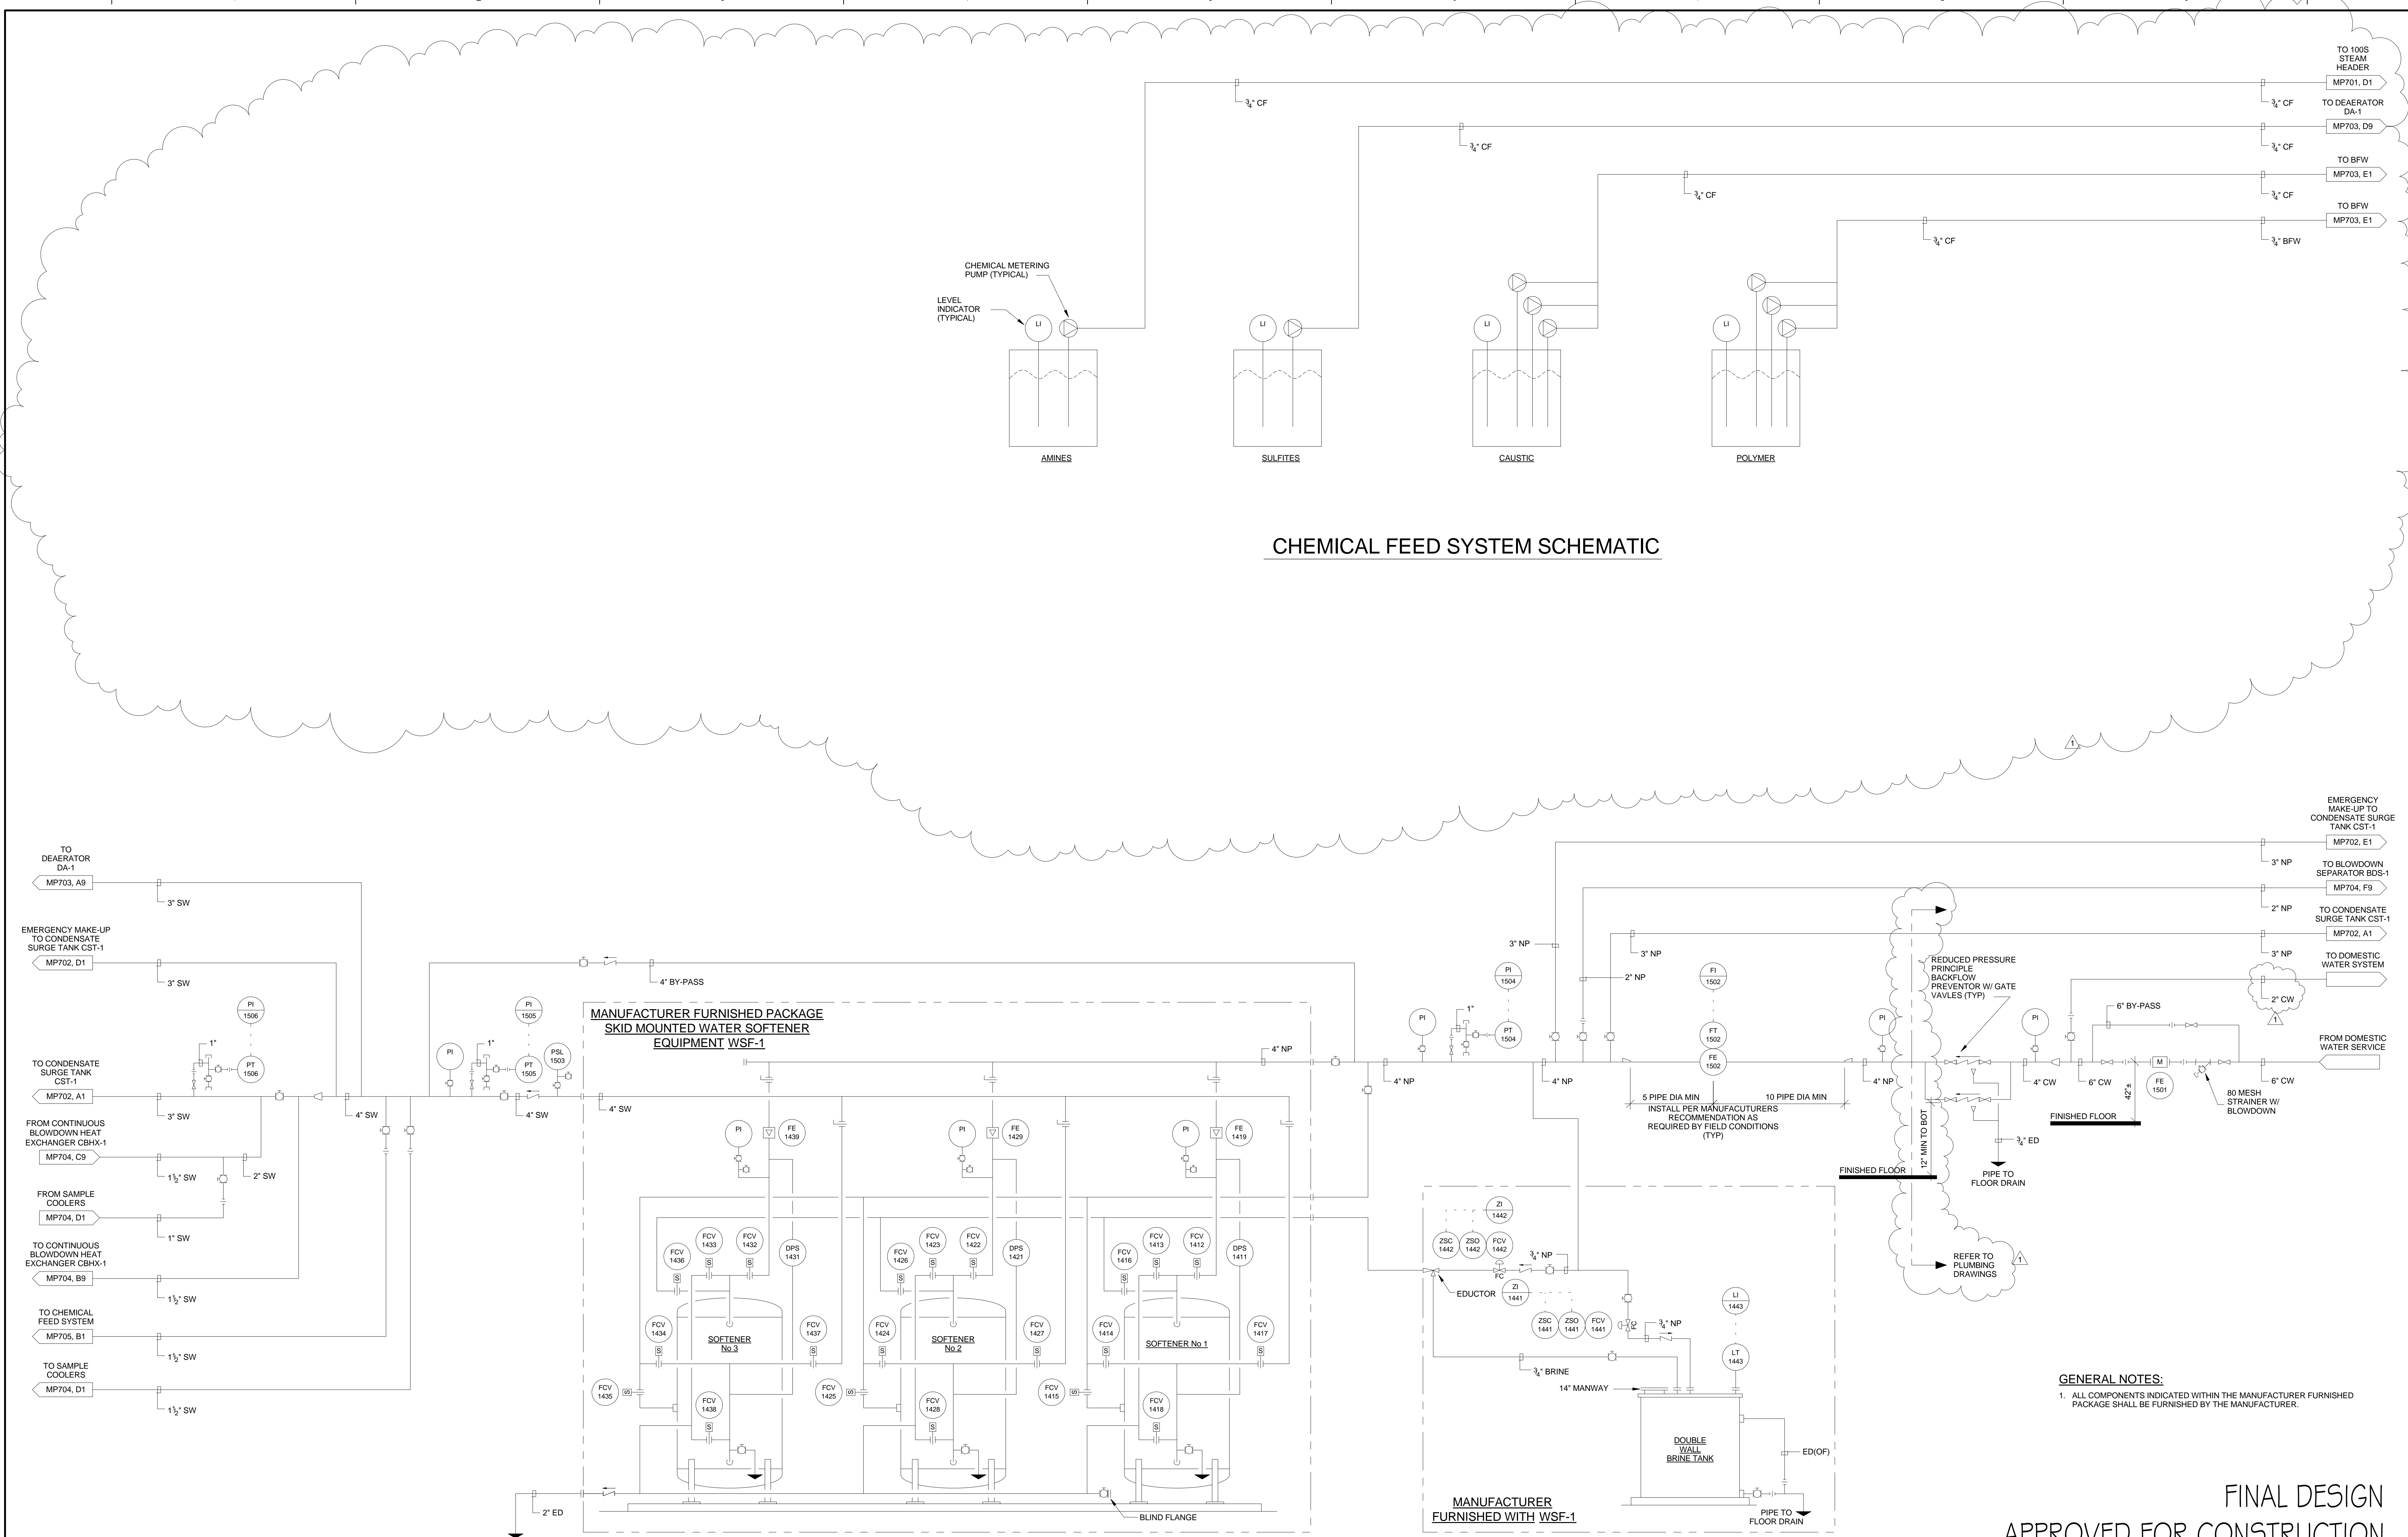

GENERAL NOTES:
1. ALL COMPONENTS INDICATED WITHIN THE MANUFACTURER FURNISHED PACKAGE SHALL BE FURNISHED BY THE MANUFACTURER.

FINAL DESIGN
APPROVED FOR CONSTRUCTION

--	--	