


SHEET NOTES

- = INTERIOR DOORS NEED ACTUATORS, SENSOR, PADELS
- = INTERIOR DOORS NEED ACTUATORS, SENSOR, PADEL AND PUSH BUTTONS
- = EXTERIOR DOORS NEED ACTUATORS, SENSOR, PODIUM
- = INTERIOR DOORS NEED ACTUATORS, SENSOR, PADELS AND PUCH BUTTON AT RECEPTION
- = PADEL/PUSH BUTTON LOCATIONS

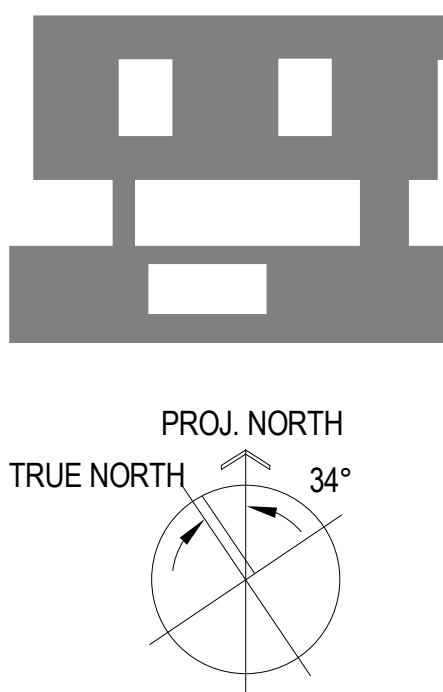

FULLY SPRINKLERED  
CONSTRUCTION DOCUMENTS

54 FLOOR PLAN LEVEL 2  
SCALE: 1/16" = 1'-0"

CONSULTANTS:

Seals and Signatures



ARCHITECT/ENGINEERS:

**SMITHGROUP**  
architecture engineering interiors planning  
301 BATTERY STREET, 7TH FLOOR  
SAN FRANCISCO, CA 94111  
T 415.227.0100 F 415.908.0862  
www.smithgroup.com

Associate Architect:  
**The Design Partnership LLP**  
Architects + Planners  
1412 VAN NESS AVE., 2ND FLOOR  
SAN FRANCISCO, CA 94109  
T 415.777.3737 F 415.777.3476  
www.dpsf.com

Drawing Title  
**OVERALL FLOOR PLAN LEVEL 2**

Approved: Project Director  
*Melan Arskic*

Project Title  
CENTERS FOR AMBULATORY CARE,  
POLYTRAUMA AND BLIND REHABILITATION  
Polytrauma and Blind Rehabilitation Center

Location  
3801 Miranda Ave., Palo Alto CA  
Date  
Jan 17, 2014  
Checked  
JG  
Drawn  
NW

Project Number  
640-424  
Building Number  
500  
Drawing Number  
**AE2.1.2**  
Dwg. of

Office of  
Construction  
and Facilities  
Management