



SHEET NOTES

- = INTERIOR DOORS NEED ACTUATORS, SENSOR, PADELS
- = INTERIOR DOORS NEED ACTUATORS, SENSOR, PADEL AND PUSH BUTTONS
- = EXTERIOR DOORS NEED ACTUATORS, SENSOR, PODIUM
- = INTERIOR DOORS NEED ACTUATORS, SENSOR, PADELS AND PUCH BUTTON AT RECEPTION
- = PADEL/PUSH BUTTON LOCATIONS

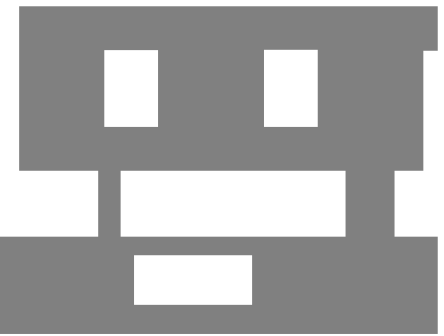

FULLY SPRINKLERED
CONSTRUCTION DOCUMENTS

54 FLOOR PLAN LEVEL 3
SCALE: 1/16" = 1'-0"

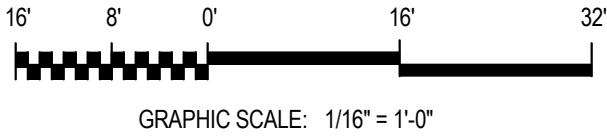

CONSULTANTS:		Seals and Signatures		ARCHITECT/ENGINEERS:		Drawing Title		Project Title		Project Number		Office of Construction and Facilities Management	
				SMITHGROUP architecture engineering interiors planning 301 BATTERY STREET, 7TH FLOOR SAN FRANCISCO, CA 94111 T 415.227.0100 F 415.908.0862 www.smithgroup.com		OVERALL FLOOR PLAN LEVEL 3		CENTERS FOR AMBULATORY CARE, POLYTRAUMA AND BLIND REHABILITATION Polytrauma and Blind Rehabilitation Center		640-424			
										Building Number 500			
				Associate Architect: The Design Partnership LLP Architects + Planners 1412 VAN NESS AVE., 2ND FLOOR SAN FRANCISCO, CA 94109 T 415.777.3737 F 415.777.3476 www.dpsf.com		Approved: Project Director 		Location 3801 Miranda Ave., Palo Alto CA		Drawing Number AE2.1.3			
								Date Jan 17, 2014		Checked JG	Drawn NW		
Revisions:		Date										Department of Veterans Affairs	