


DEMO (E) STEEL STUD
WALL AND (E) DOOR

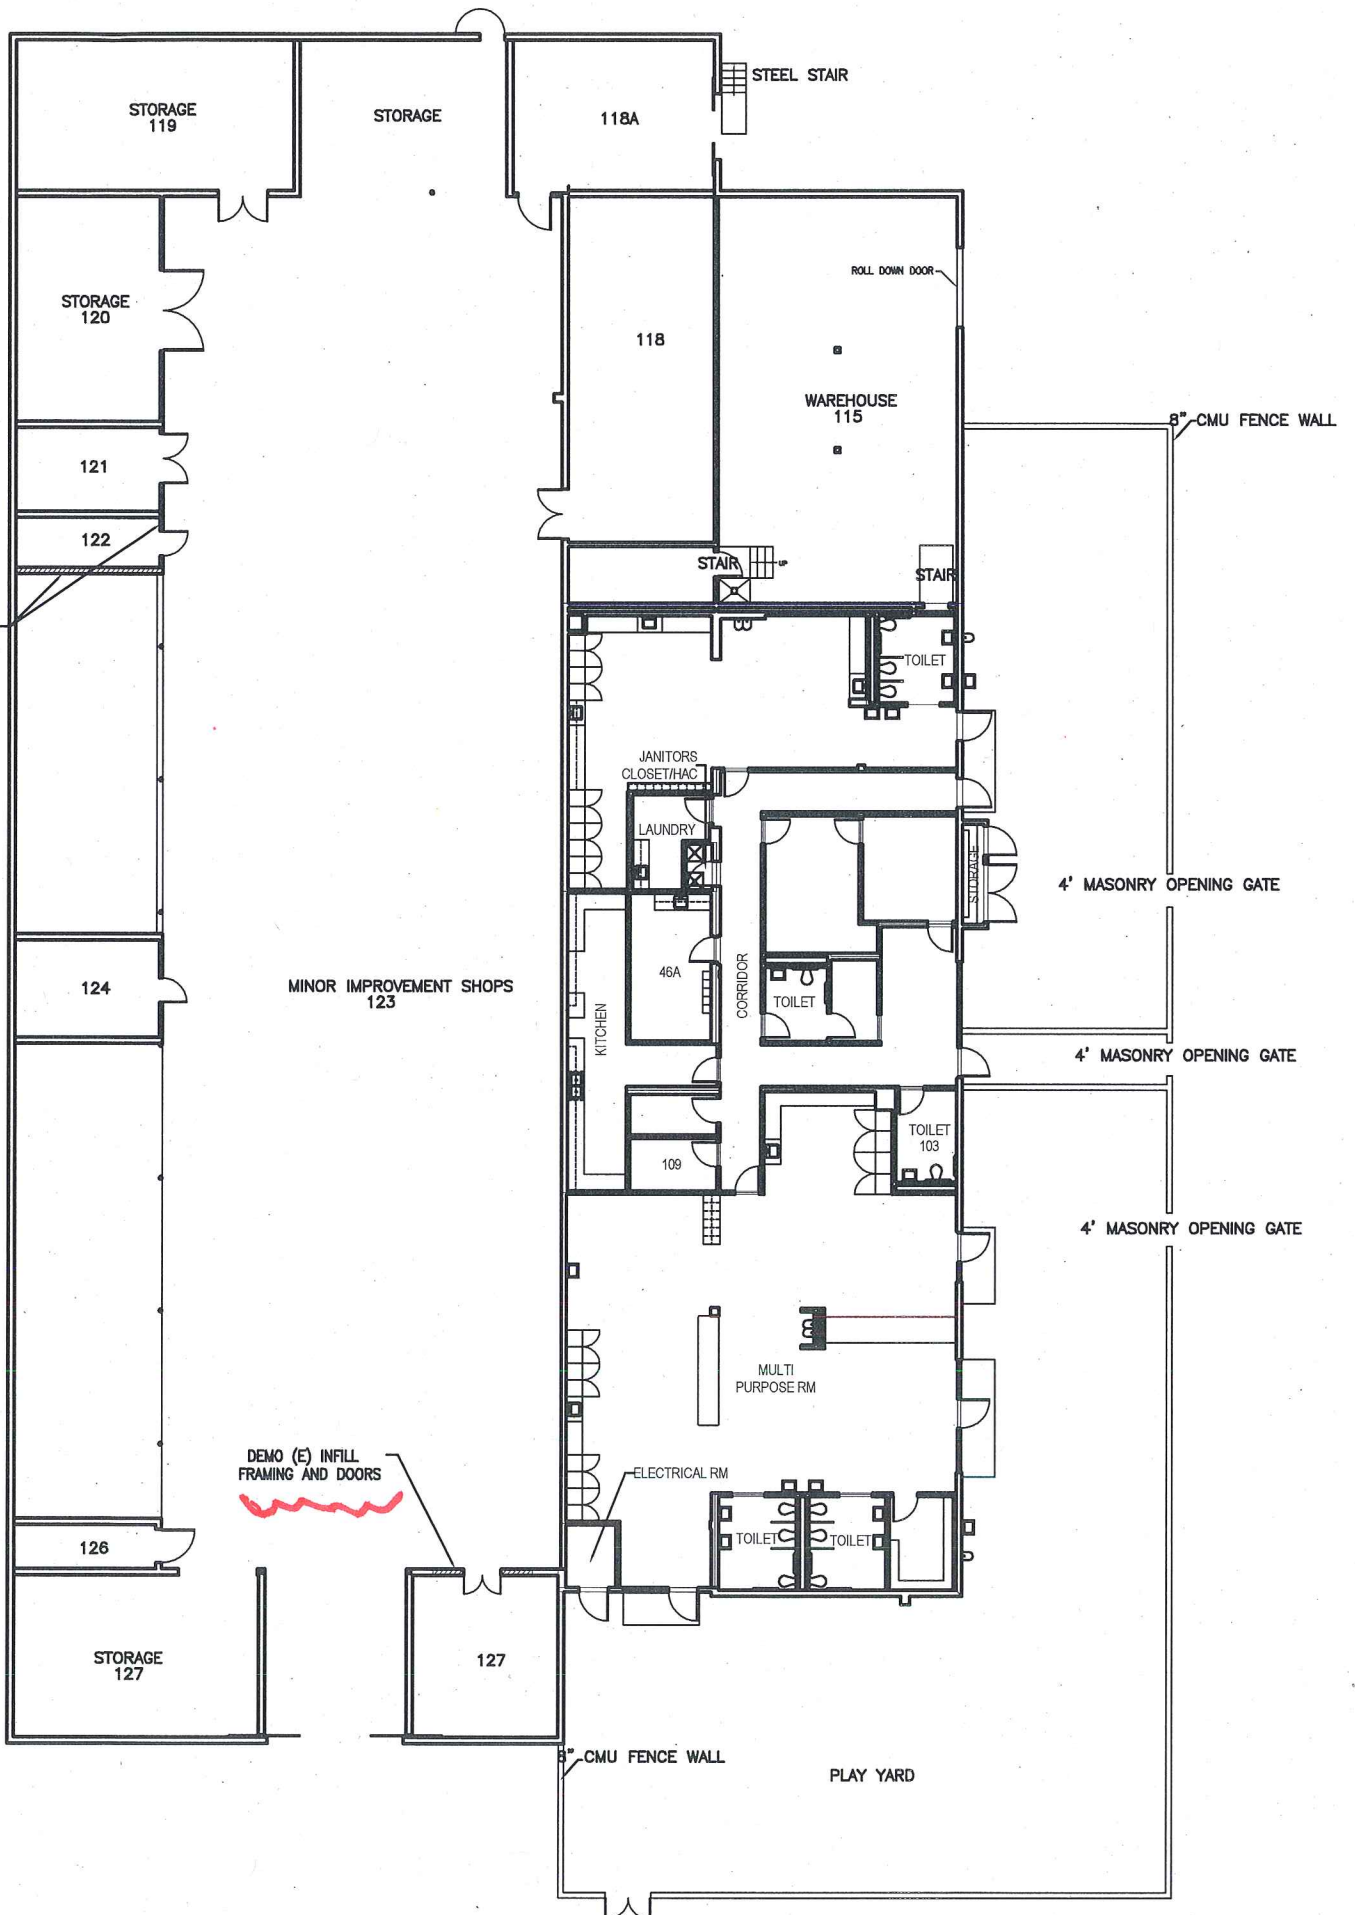


DEMO PLAN

SK-1

NOTES

1. CONTRACTOR TO FIELD VERIFY AND MEASURE ALL DIMENSIONS PRIOR TO CONSTRUCTION.
2. REPLACE ROOFING AND PLYWOOD IN THE HIGHLIGHTED AREA
3. NEW CANOPY SHALL HAVE 15'-0" MIN CEILING HEIGHT WITH 20'-0" BAYS
4. ALL CONSTRUCTION SHALL CONFORM TO THE LATEST IBC AND VA STANDARDS
5. DO NOT DAMAGE EXISTING CONDUIT WITHIN THE INTERIOR FASCIA
6. ALL NEW FRAMING SHALL BE 16 GA STEEL STUDS.
7. PROVIDE NEW STUCCO FINISH AT ALL NEW FRAMED WALLS AND ~~3/4"~~ 3/4" ACX SHEATHING INTERIOR.

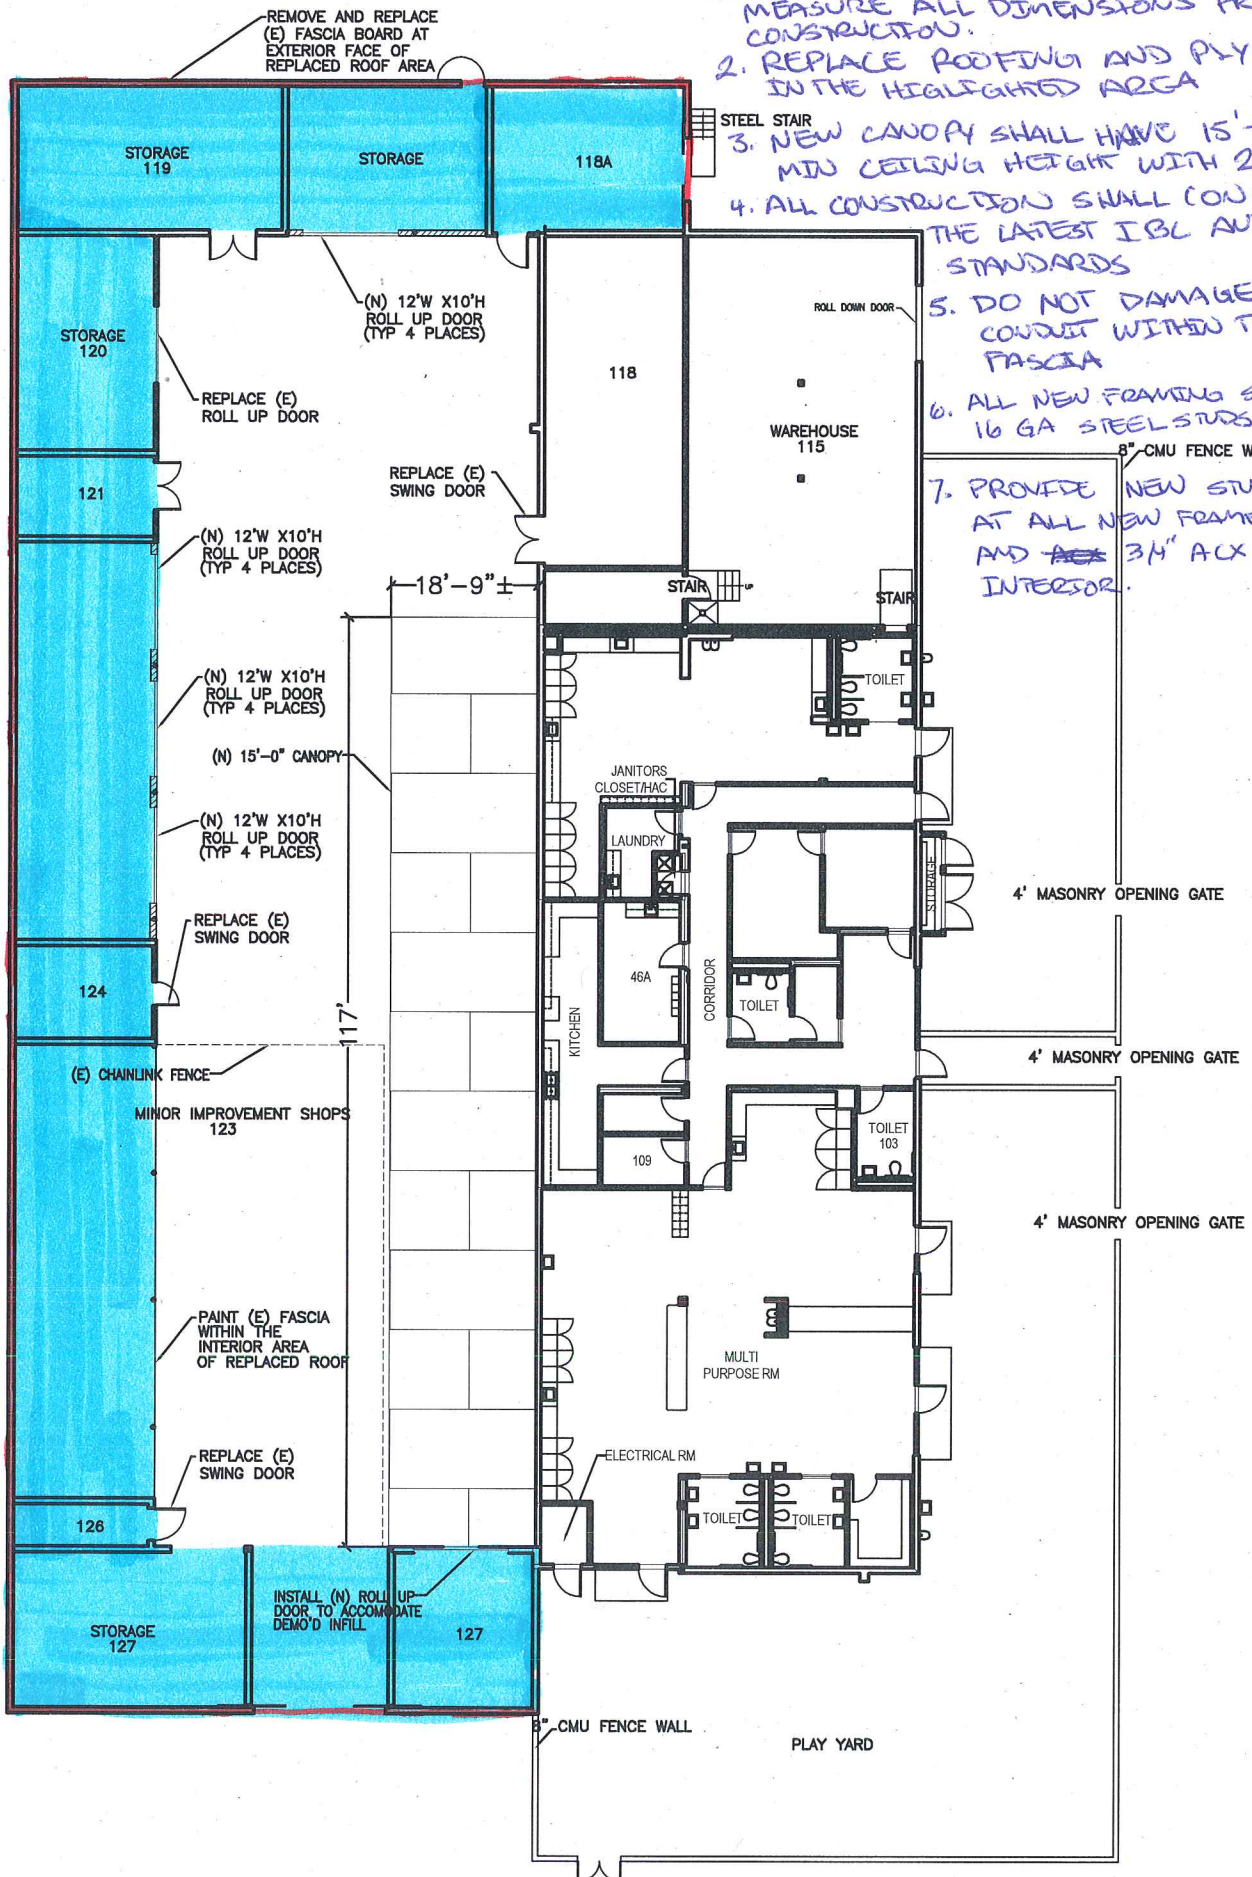

NEW DOORS AND ROOF PLAN SK-2