


AS BUILT DRAWING

JUN 2 1969

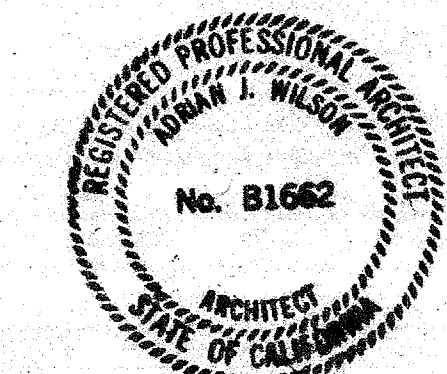

APPROVED
PROJECT DIRECTOR

HTG-VENT. & AIR CONDITIONING.		
FIRST FLOOR PLAN-QUADRANT "A"		
BLDG. 126		
700 BED G.M. & S. BUILDING		
AND ALTERATIONS		
TO BUILDINGS NOS. 1, 2, 7 & 8		
VETERANS ADMINISTRATION		
LONG BEACH, CALIFORNIA		
DRAWN A.R.D.	PROJ. MGR. S.M.D.	REVISIONS
CHECKED W.C.L.	DATE AUG. 7, 1964	
ADRIAN WILSON & ASSOCIATES		DRAWING NUMBER
ARCHITECTS & ENGINEERS		126-H5
LOS ANGELES, CALIFORNIA		SHEET 13 OF 51
BRANDOW AND JOHNSTON		PROJ. NO. 04-5510 A/E
STRUCTURAL ENGINEER		
RALPH E. PHILLIPS, INC.		
MECHANICAL & ELECTRICAL ENGINEERS		

RETURN DRAWING TO ARCHITECTS

FILE NO.