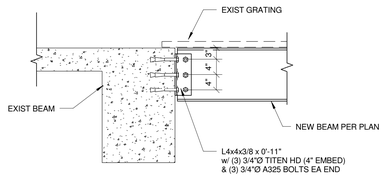

1 NEW W14 TO EXIST CONC BM DETAIL
SCALE: 3/4" = 1'-0"

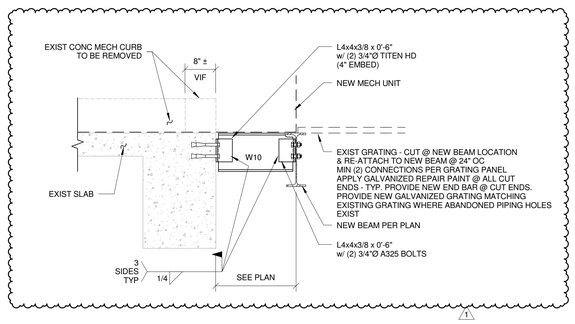

2 NEW W14 PARALLEL TO EXIST BM
SCALE: 3/4" = 1'-0"

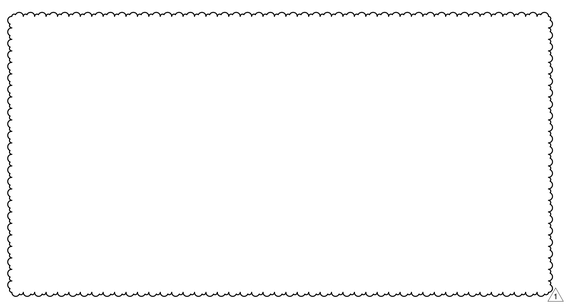

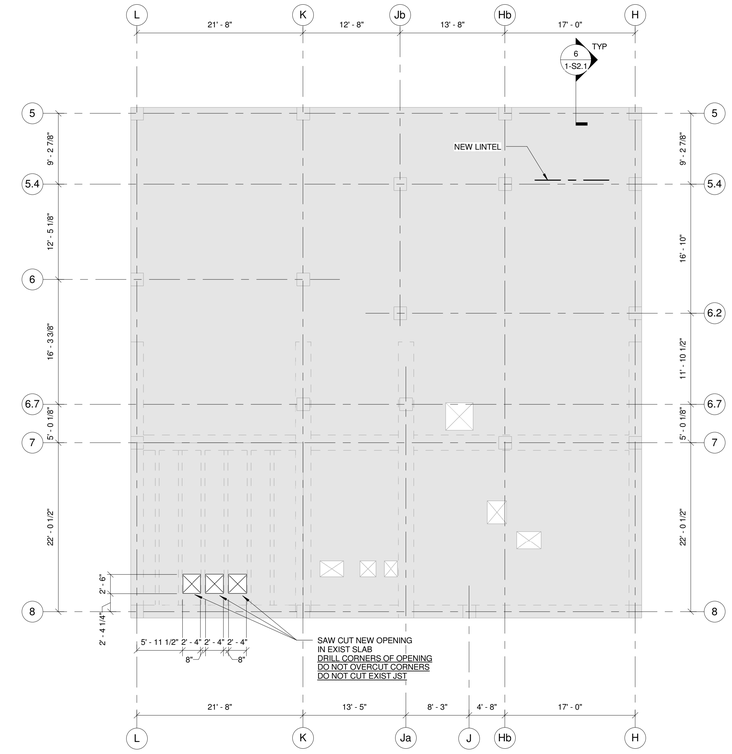

PARTIAL FRAMING PLAN @ EXISTING PENTHOUSE ROOF
SCALE: 1/8" = 1'-0"
NORTH

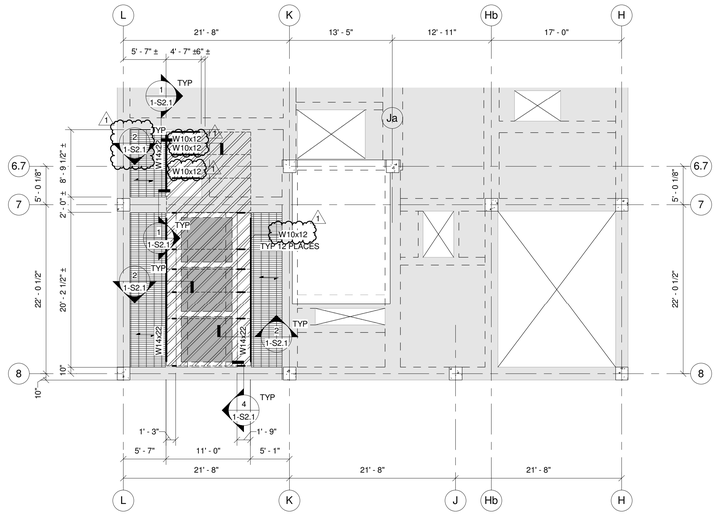

PARTIAL FRAMING PLAN @ EXISTING PENTHOUSE LOWER LEVEL
SCALE: 1/8" = 1'-0"
NORTH

1. SEE SHEET 1-S0.1 FOR STRUCTURAL GENERAL NOTES, INCLUDING MATERIAL.
2. REFER TO THE ARCHITECTURAL DRAWINGS AND/OR COORDINATE WITH THE ARCHITECT REGARDING MISSING DIMENTIONS
3. ⟶ INDICATES SPAN DIRECTION OF GRATING
4. T/BEAM ELEVATION TO MATCH EXIST CONCRETE BEAMS.

NOTE:
EXIST CONC BEAMS TO BE SCANNED TO LOCATE EXIST REINF PRIOR TO DRILLING. DO NOT CUT EXIST REINF WHEN DRILLING. ADJUST LOCATION OF CONNECTION TO AVOID INTERFERENCE W/ EXIST REINF. IF ADJUSTMENT IS NOT POSSIBLE THEN NOTIFY CONTRACING OFFICER FOR ALTERNATIVE CONNECTION.

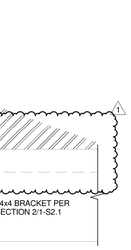

4 L SUPPORT ALONG CONC BEAM
SCALE: 3/4" = 1'-0"

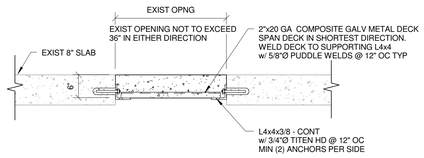

5 TYPICAL SLAB INFILL DETAIL @ EXISTING SLAB OPENINGS
NOT TO SCALE

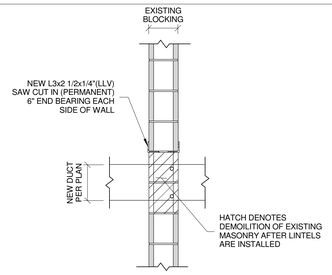

6 NEW DUCT OPENING IN EXISTING CMU WALL
NOT TO SCALE

BID DOCUMENTS

Revisions:	Date
AMENDMENT 01	09-07-17

CONSULTANTS:

MICHAEL VALERE VANDE VELDE
PE-2004017260
07-12-17
STATE OF MISSOURI
MICHAEL VALERE VANDE VELDE
NUMBER PE-2004017260
PROFESSIONAL ENGINEER

ARCHITECT/ENGINEERS:

FoxArchitects
One Memorial Drive
Suite 1800
Saint Louis, MO 63102
Tel 314.621.4343
Fax 314.621.0261
Veteran Owned Small Business VOSB cVe
SSC Engineering, Inc.
16207 Edison Avenue
Chesterfield, Missouri 63005
Phone: 636.536.7770 Fax: 636.536.7877
inc@sscengineering.com

Drawing Title
STRUCTURAL FRAMING PLANS AND DETAILS

Project Title
Renovate Vacated ICU, 6th Floor

Location 800 Hospital Drive
Columbia, MO 65201

Date 07/12/2017 | Checked MVV | Drawn JMH

Project Number 589A4-16-101
Building Number 01
Drawing Number 1-S2.1

Office of Facilities Management

VA FORM 08-6231, OCT 1978

9/7/2017 4:52:17 PM