




9 SOUTH TOWER COLUMN DETAIL
AS411 SCALE: 1/12" = 1'-0"

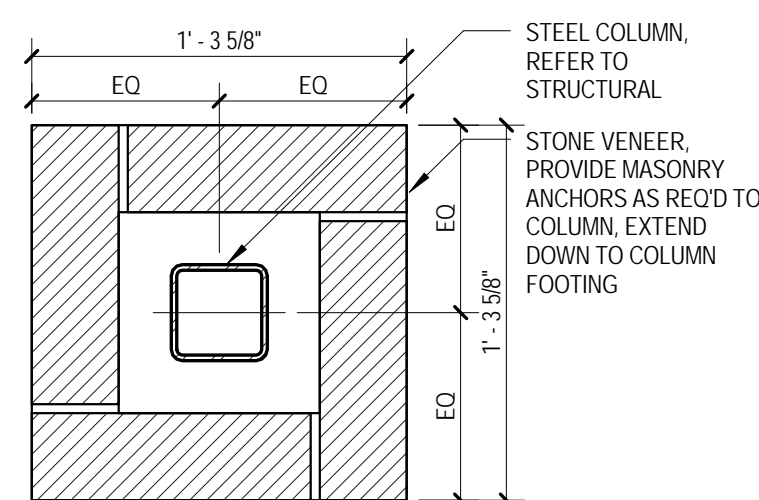


8 WALKWAY COLUMN DETAIL
AS411 SCALE: 1/12" = 1'-0"

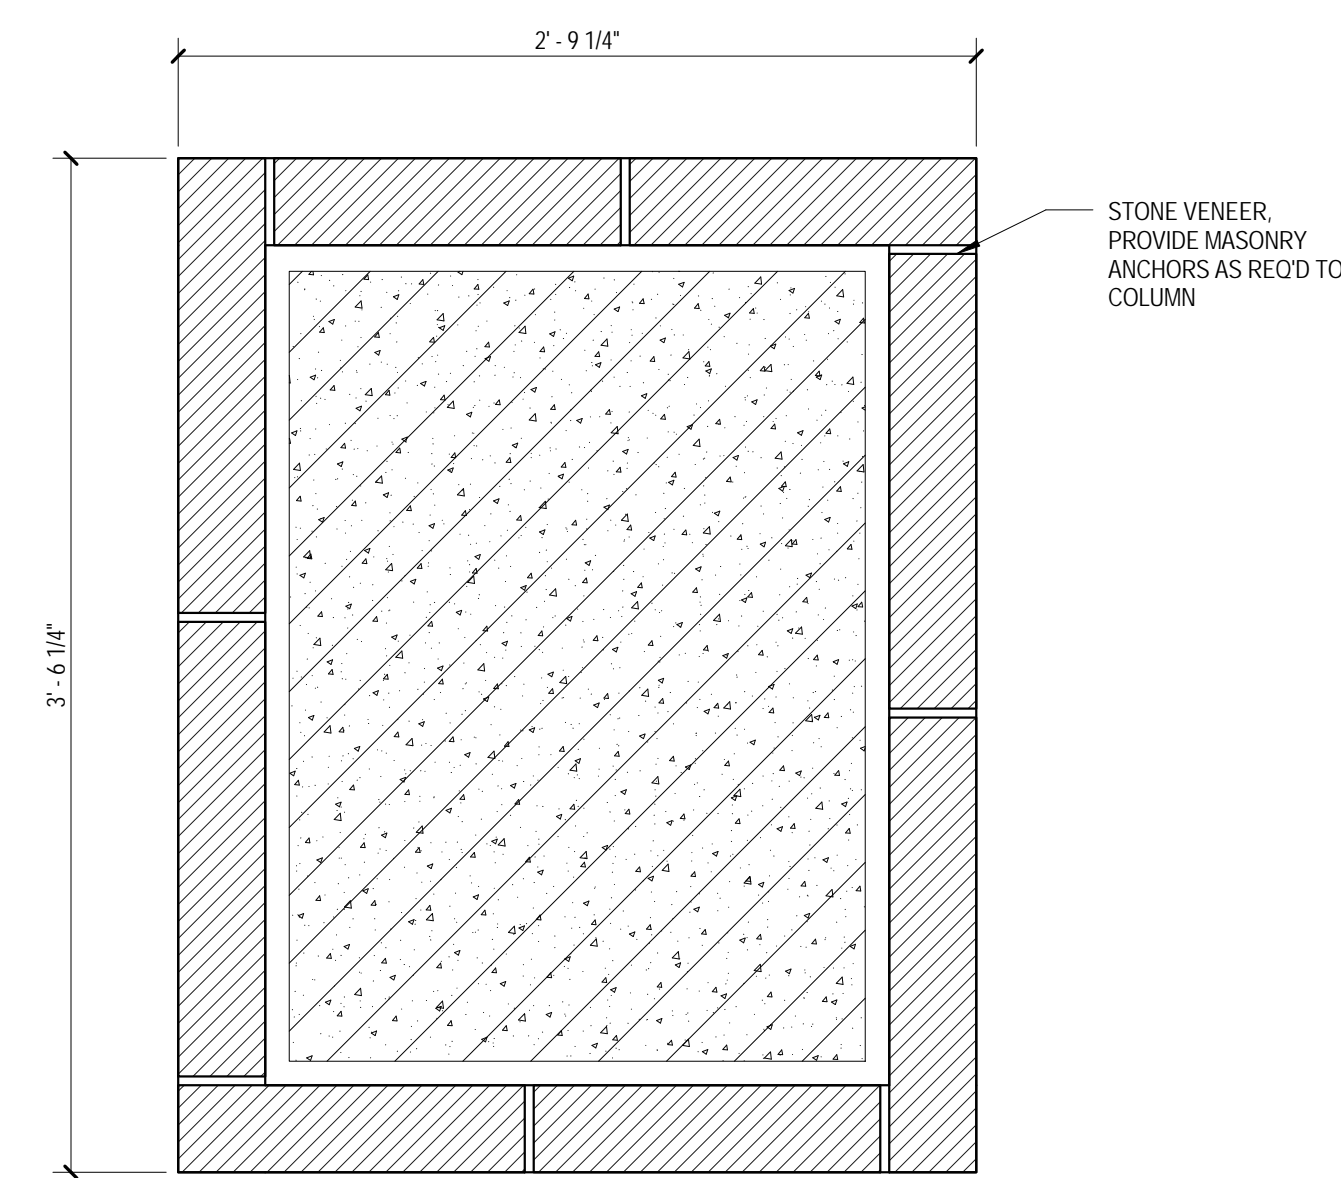


1 COLUMN DETAIL
AS411 SCALE: 1/12" = 1'-0"

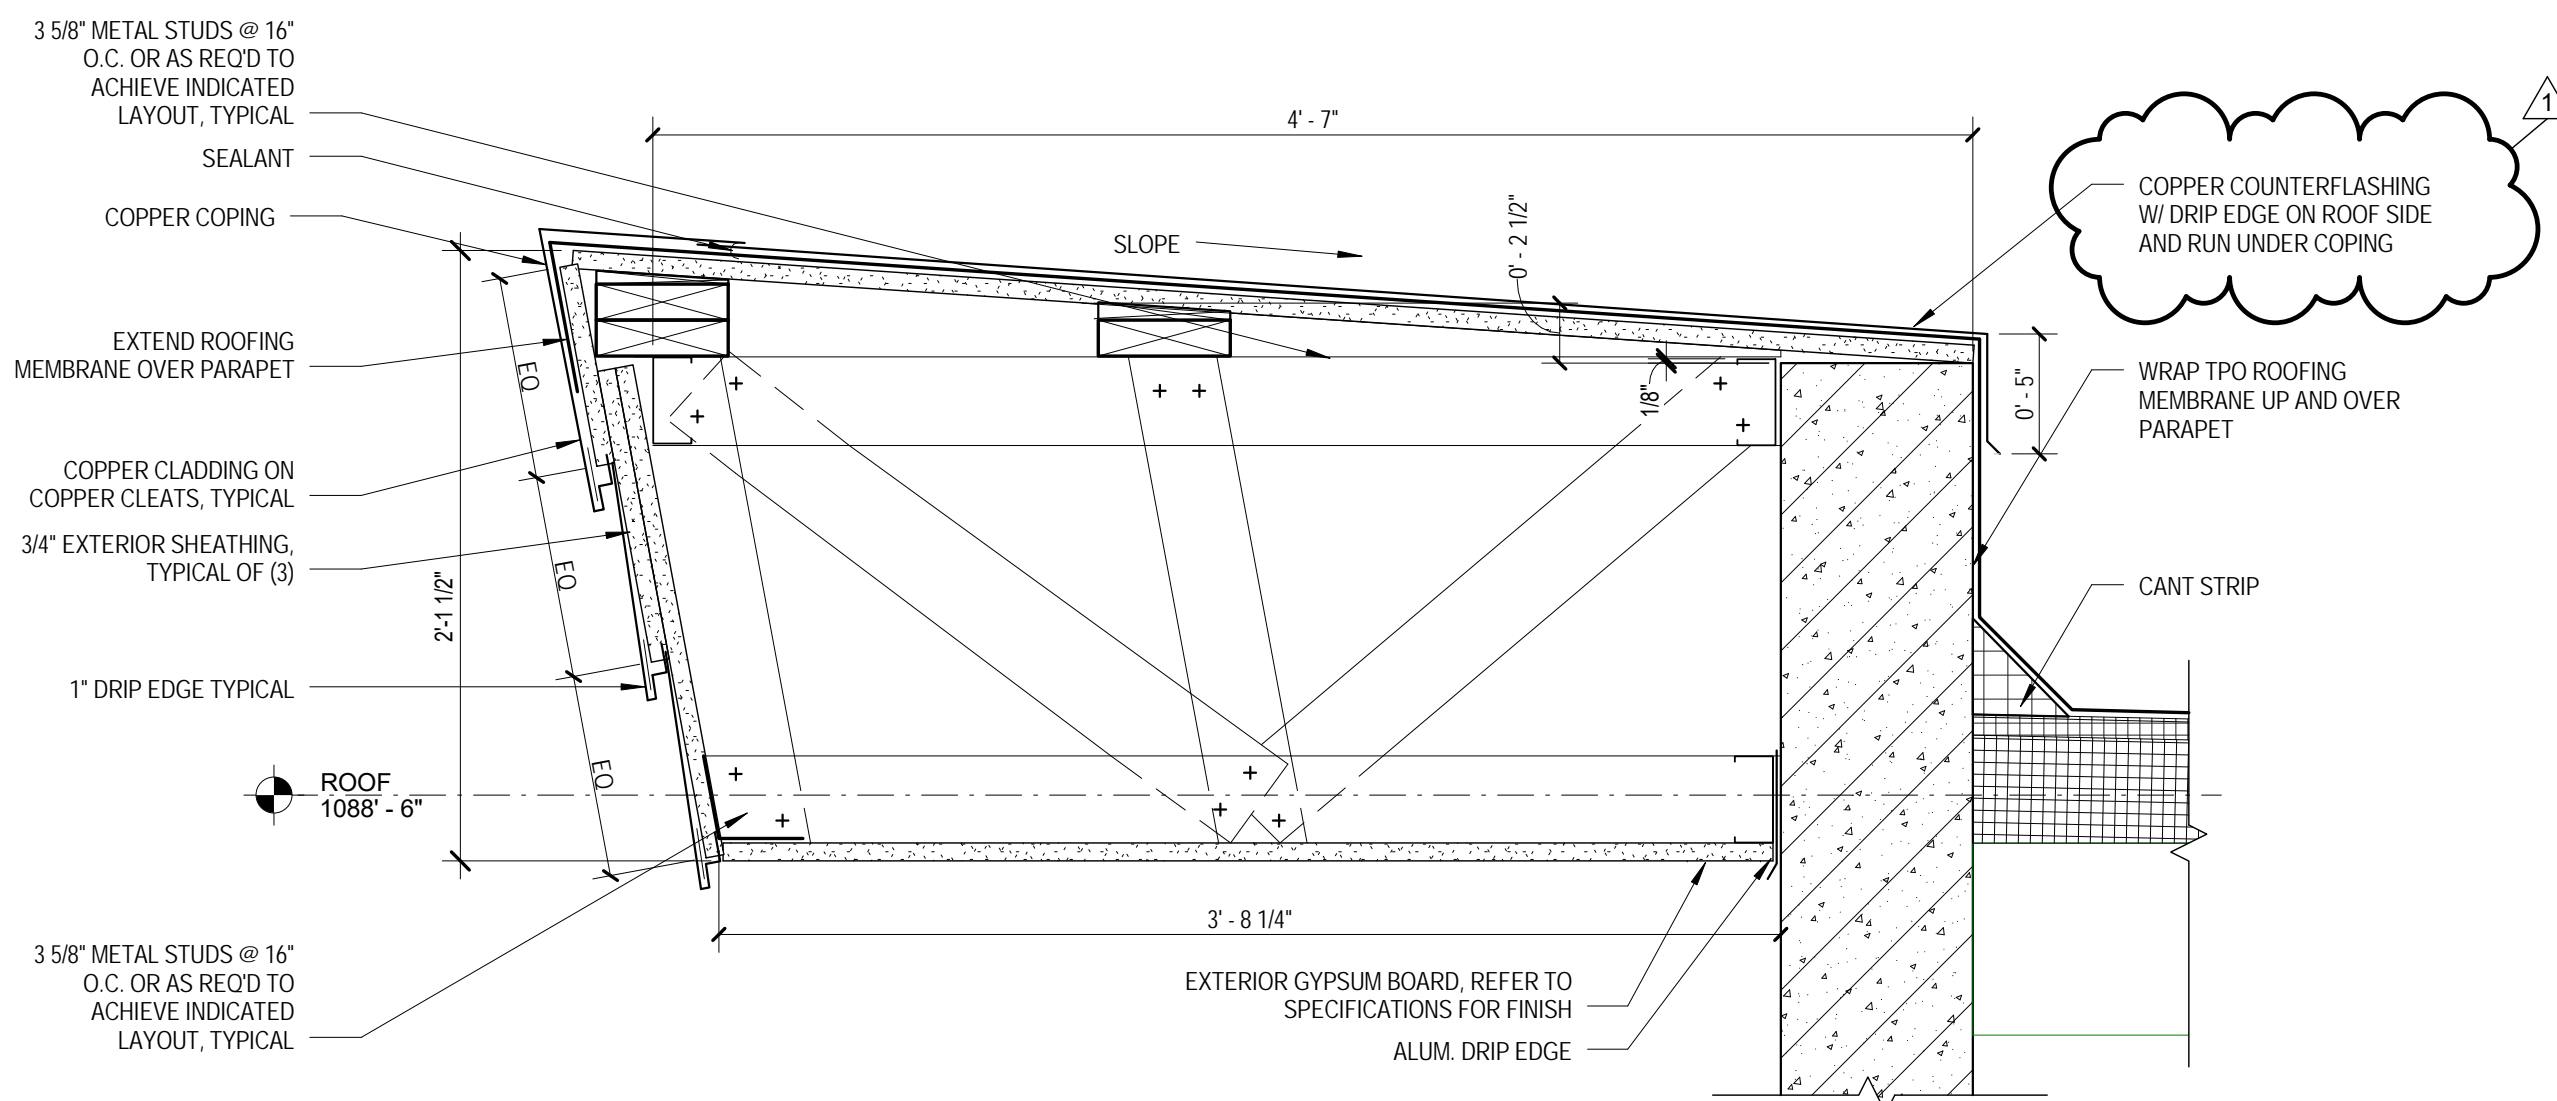


6 ENLARGED OVERHANG DETAIL
AS411 SCALE: 1/12" = 1'-0"

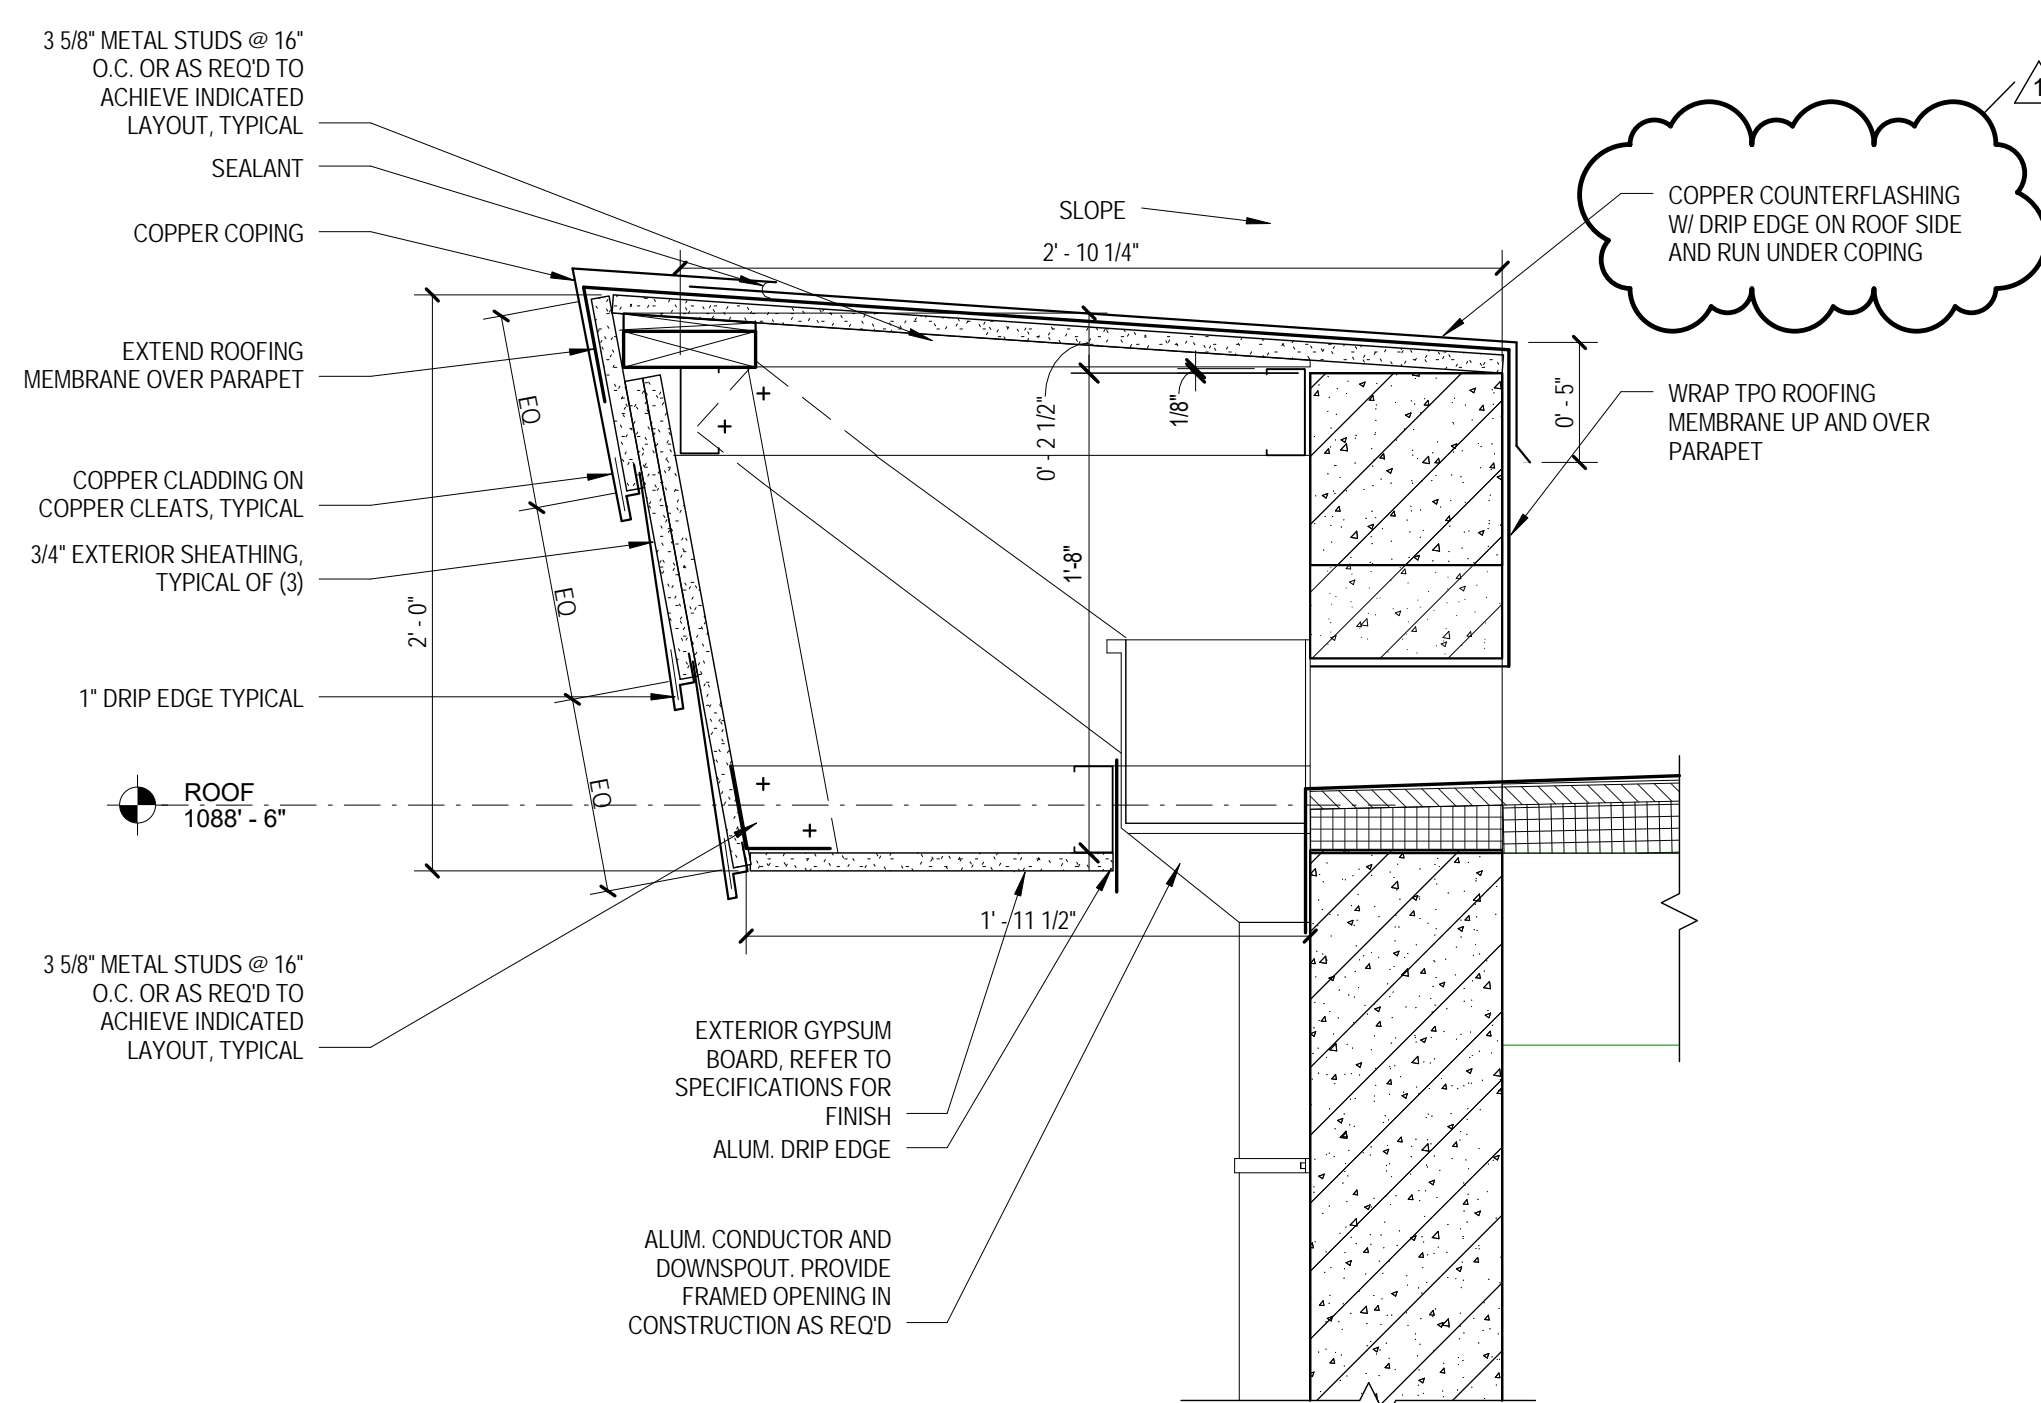


5 COPPER FASCIA / SCUPPER ROOF DETAIL
AS411 SCALE: 1/12" = 1'-0"

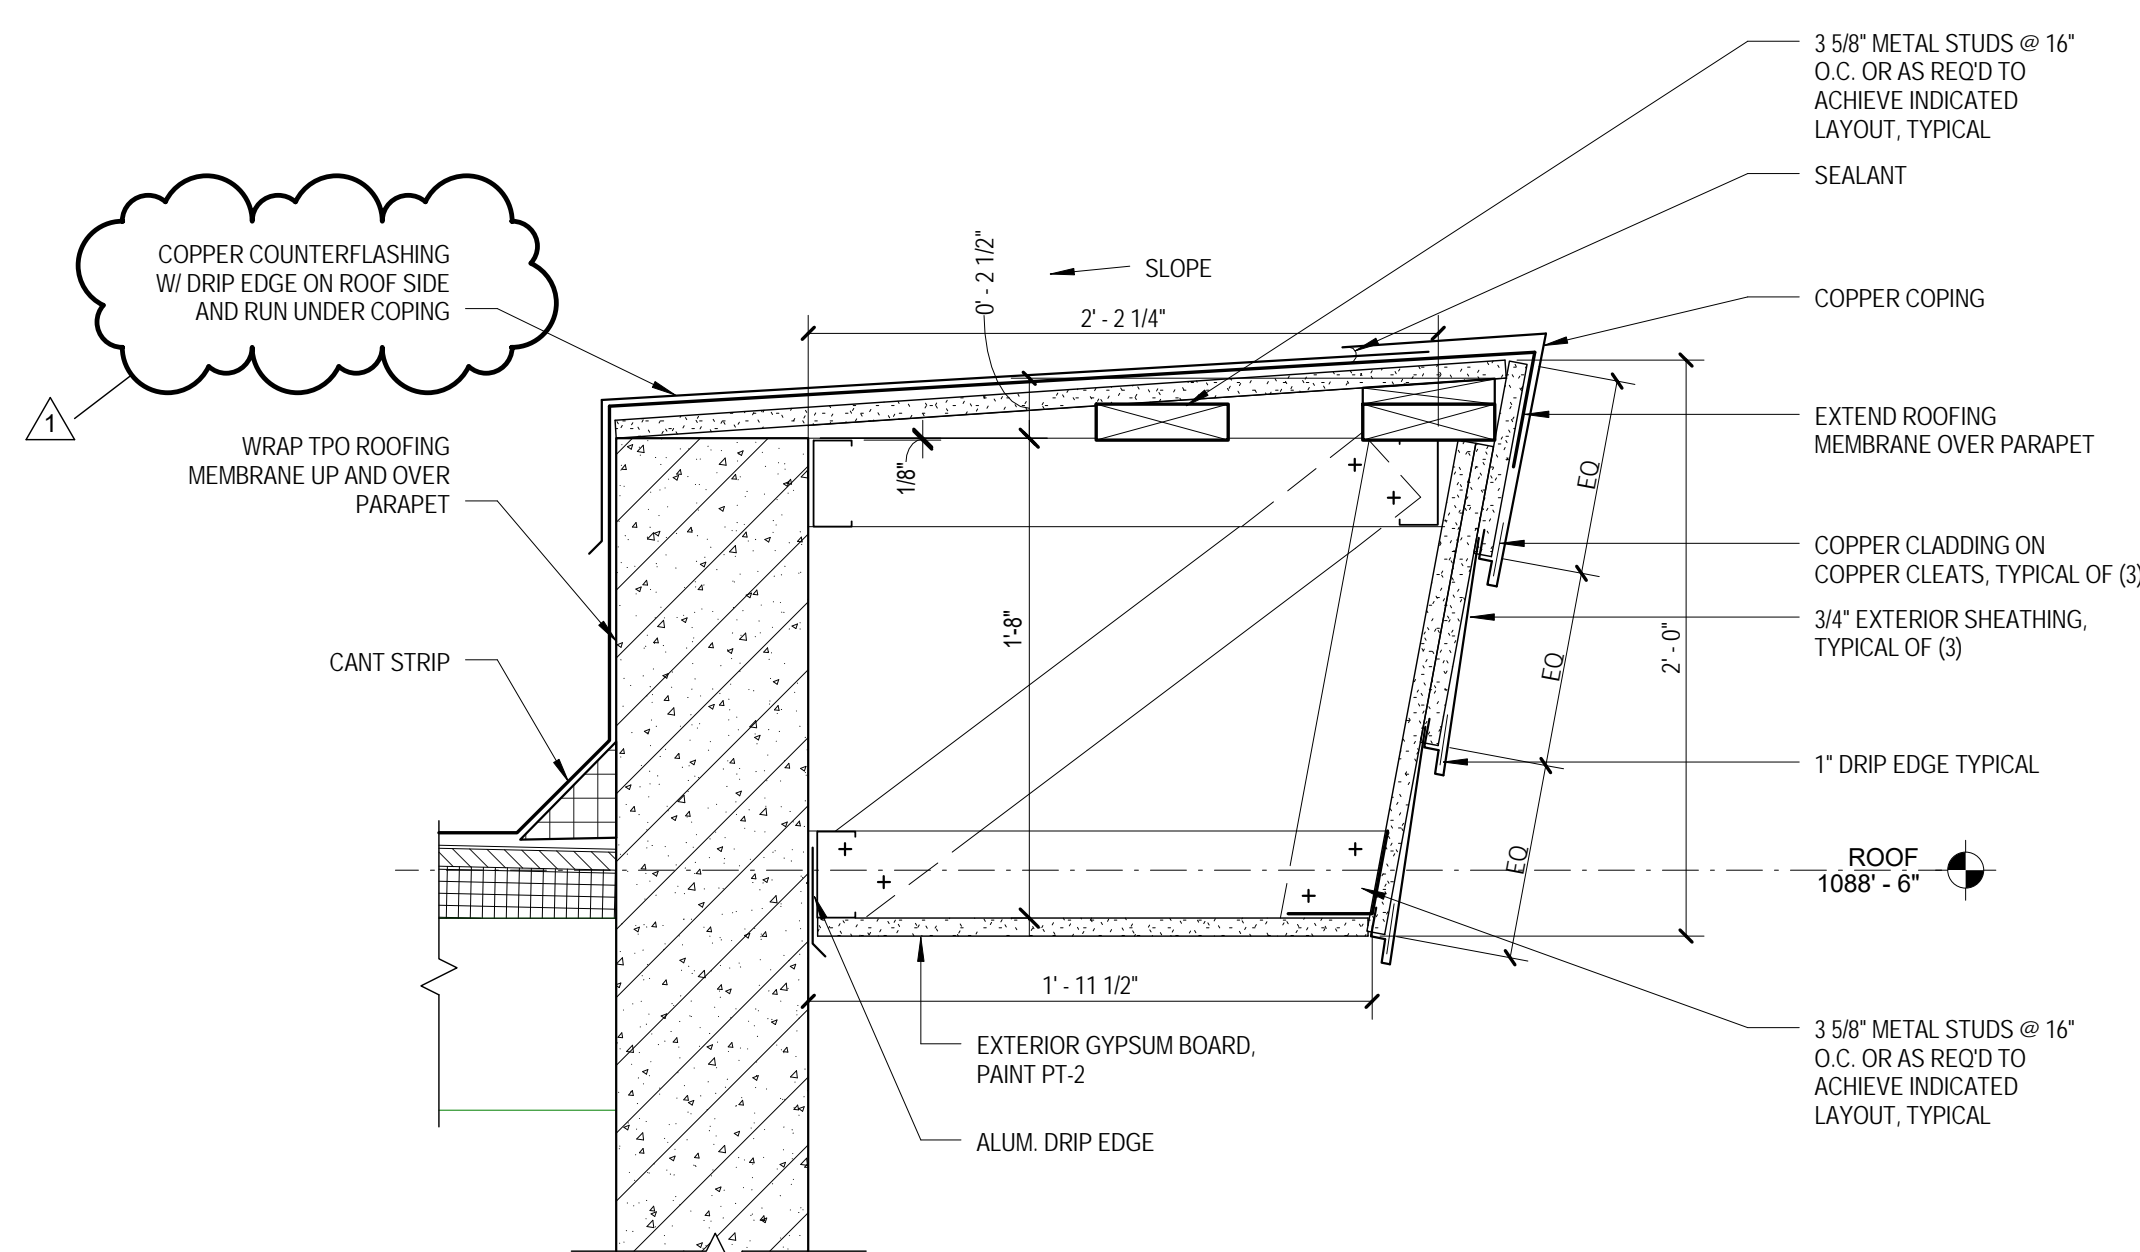


1 COPPER FASCIA ROOF DETAIL
AS411 SCALE: 1/12" = 1'-0"

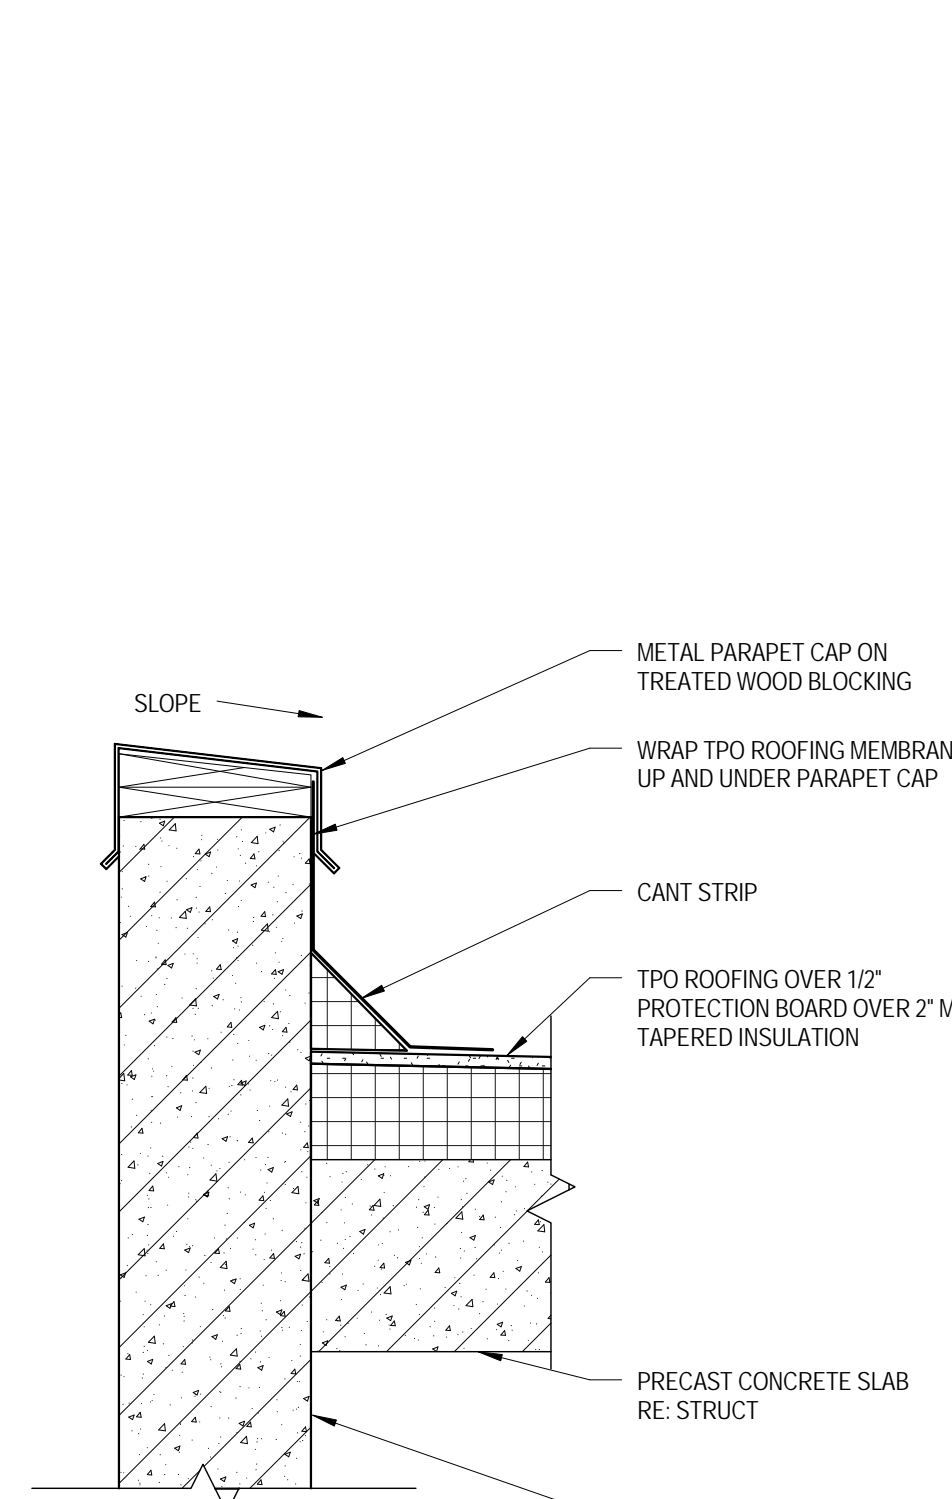

1 TYP PARAPET SECTION
AS411 SCALE: 1/12" = 1'-0"

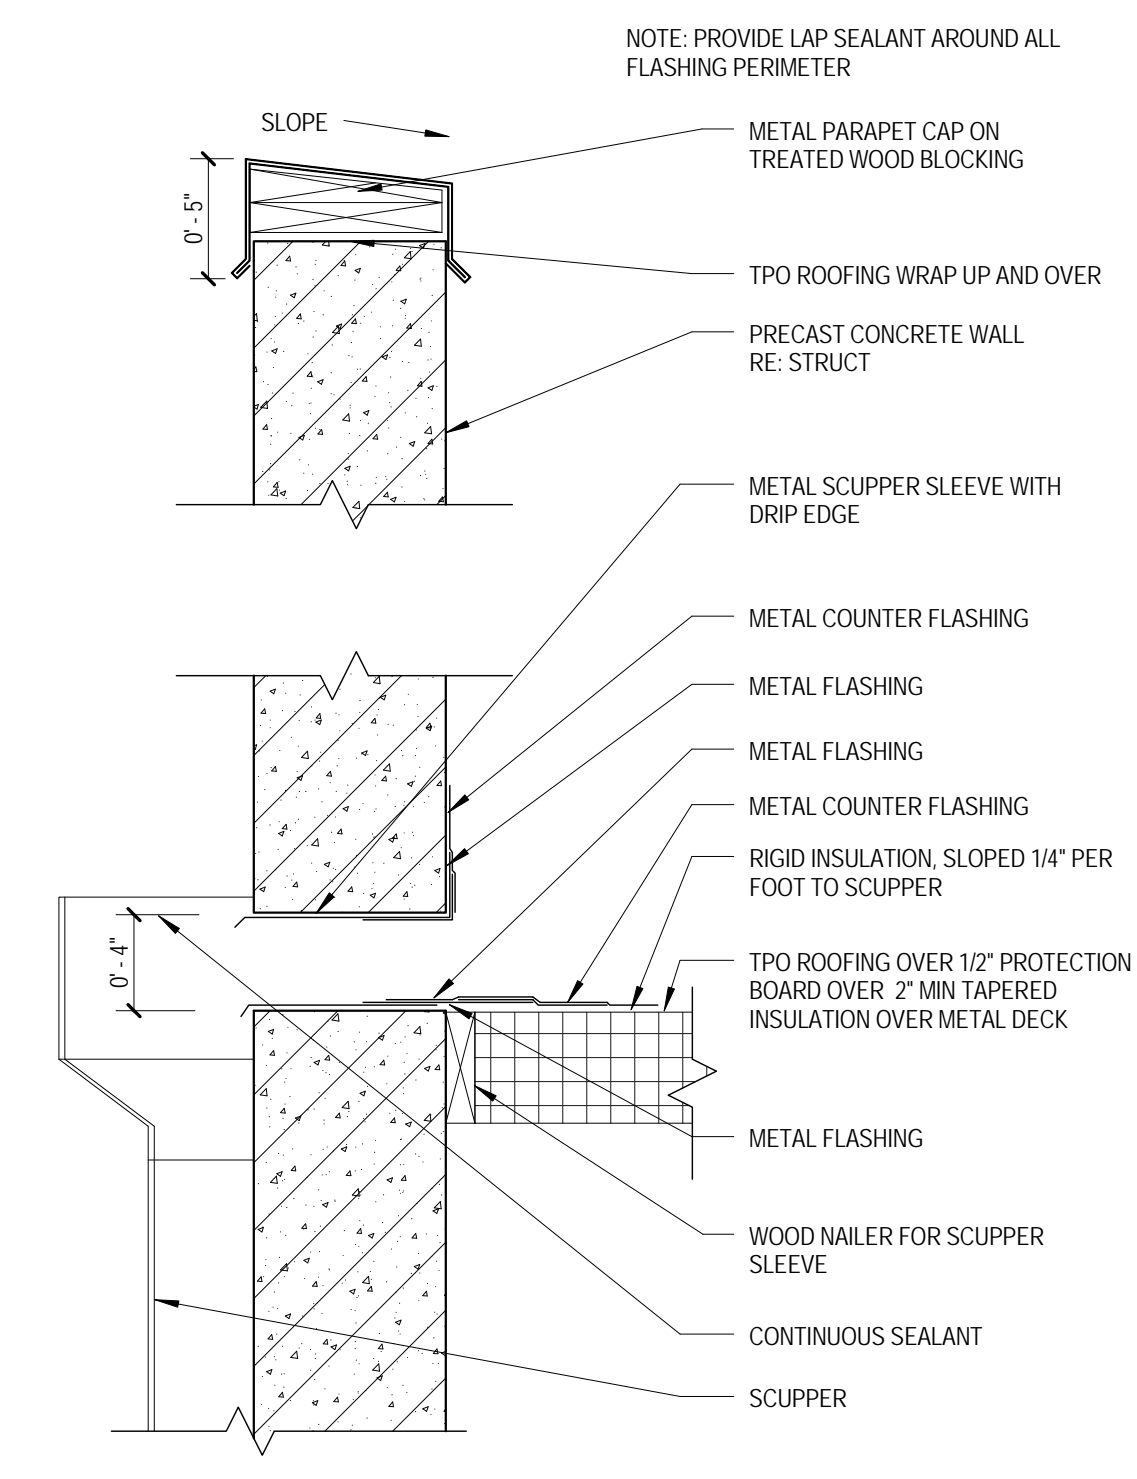

2 SCUPPER DETAIL
AS411 SCALE: 1/12" = 1'-0"

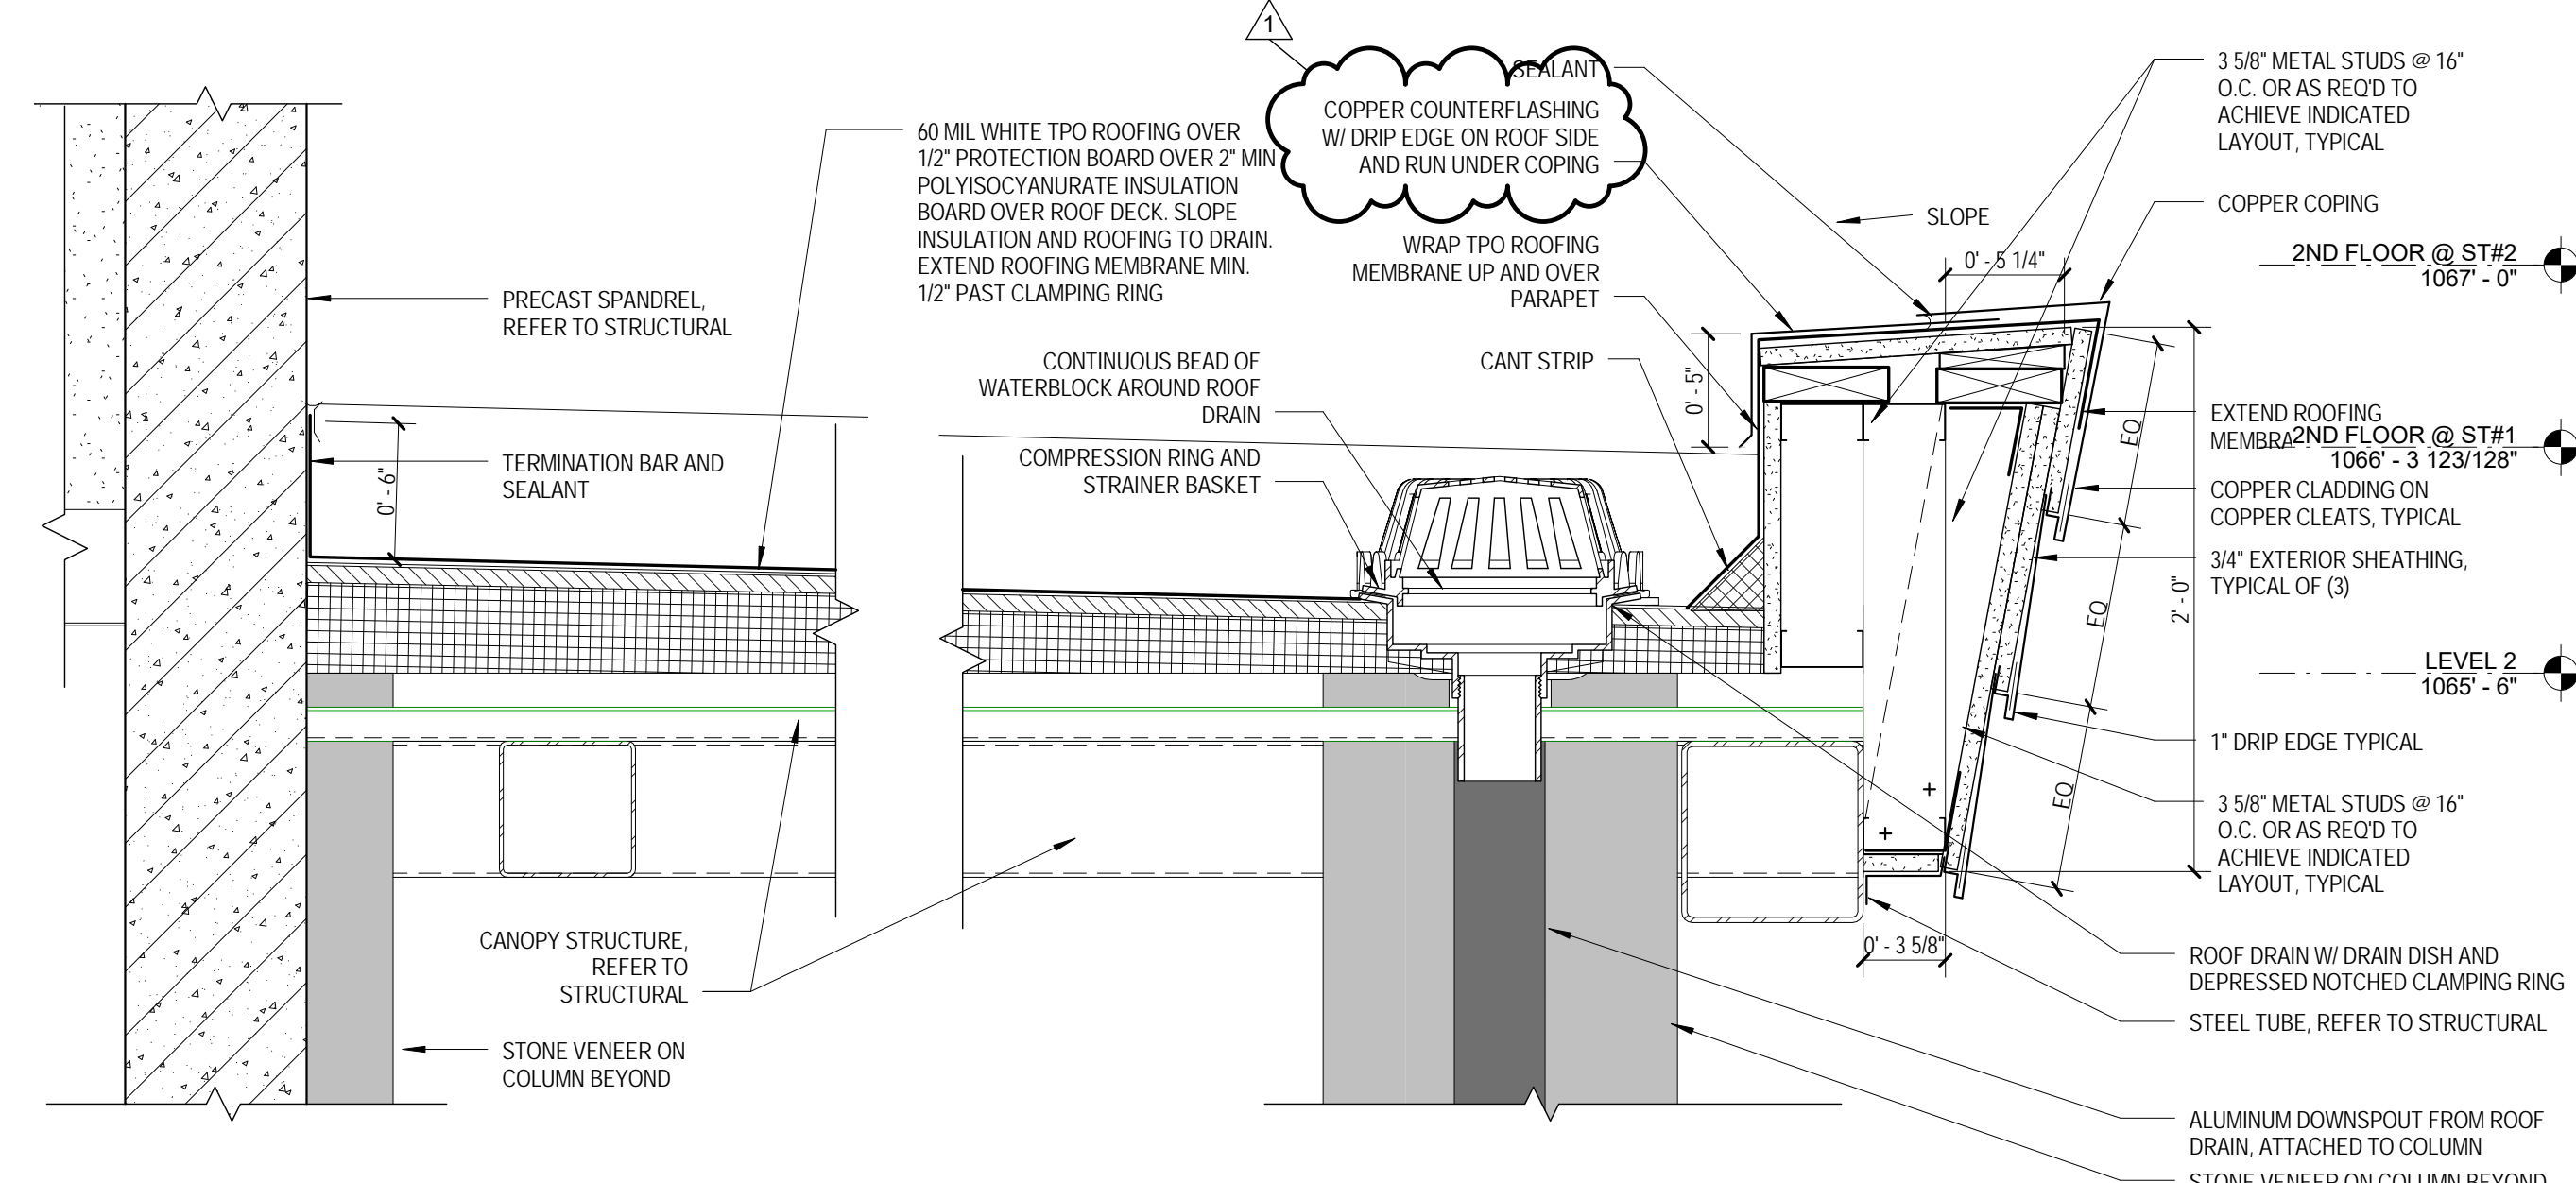

1 EAST CANOPY DETAIL
AS411 SCALE: 1/12" = 1'-0"



ARCHITECT/ENGINEERS:
PROJECT LEAD Architect, Structural Engineer, Civil Engineer
MEP Engineer AECOM
Functional Design Carl Walker Inc.
GUIDON DESIGN
905 N. CAPITOL AVE. SUITE 100 INDIANAPOLIS, IN. 46204
317.800.6388 WWW.GUIDONDESIGN.COM
SUSTAINABLE ARCHITECTURE + ENGINEERING
One Midtown Plaza 1360 Peachtree St. NE, Suite 500 Atlanta, GA 30309
14045 Ballantyne Corporate Place, Suite 380 Charlotte, NC 28277
Tele: 704-716-8000
Tele: 404-965-9600

COMPLETE DESIGN - ISSUED FOR CONSTRUCTION				
Drawing Title DETAILS	Project Title PARKING DECK, TRINKA DAVIS VETERANS VILLAGE		Project Number 16.1043	OFFICE OF FACILITIES MANAGEMENT
	Location CARROLLTON, GA		Building Number	
Approved for Design Concept: FACILITY MANAGEMENT DIVISION MANAGER	Date 07/05/2017		Drawing Number AS411	VA Project Number 508-342
	Checked By: KLA		Drawn By: KH	