HVAC AND PLUMBING SHEET KEYNOTES (#)

1.	BEGINNING AT THIS POINT, ROUTE STORM MAIN BELOW GRADE AT 1/4" PER FOOT SLOPE, ROUGHLY EQUAL TO GRADE OF PARKING DECK SURFACE, TO MAINTAIN ROUGHLY EQUAL COVER AND AVOID DEEP TRENCHING.
2.	SPILL CONDENSATE DRAINAGE TO DECK DRAIN.
3.	4" FP STANDPIPE UP WITH HOSE CONNECTION ON EACH LEVEL.
4.	4" FP STANDPIPE UP WITH HOSE CONNECTION AT INTERMEDIATE LANDINGS.
5.	SECTIONAL CONTROL VALVE AT BASE OF STANDPIPE.
6.	ALL NEW PARTITIONS ARE WALL TYPE M8.A1 UNLESS NOTED OTHERWISE.
7.	RETURN TO 1/8" PER FOOT SLOPE, WHERE DECK IS SLOPED AT 1/8" PER FOOT OR LESS.

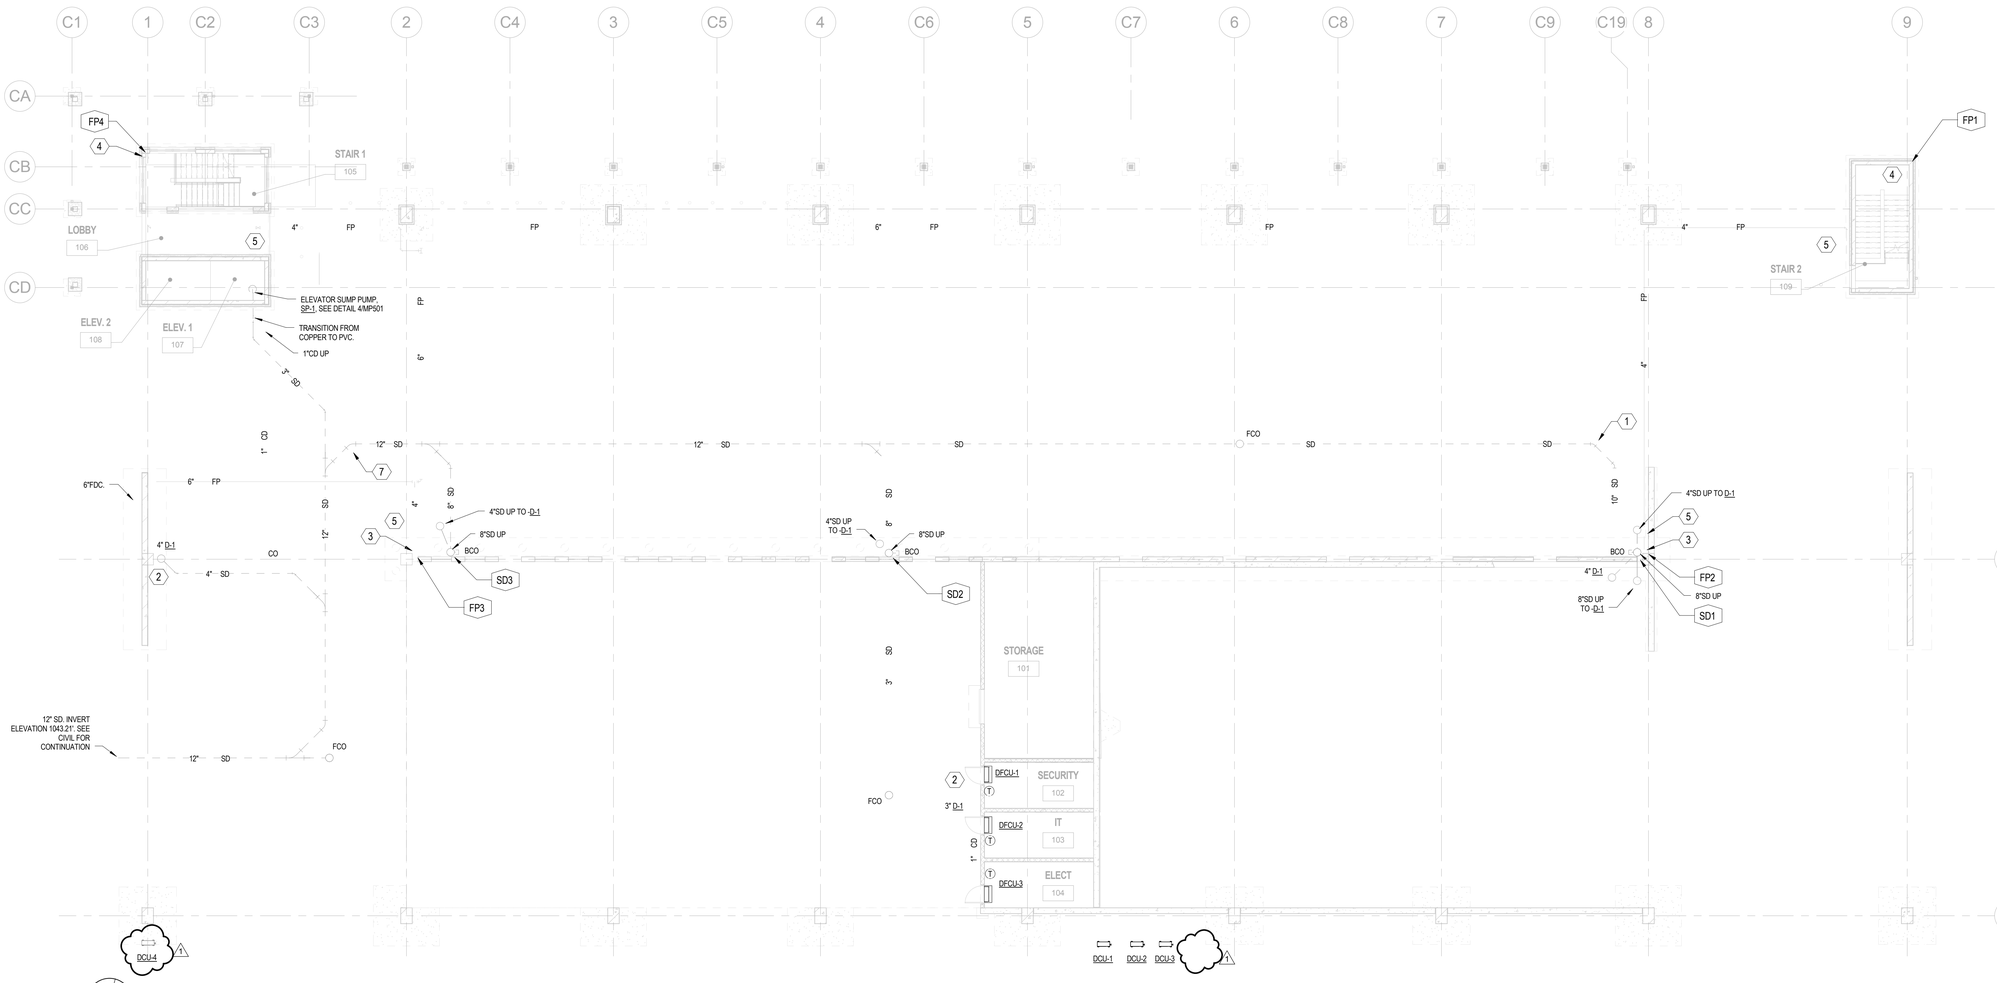

LEVEL 1 - HVAC AND PLUMBING PLAN

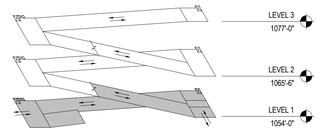

ISOMETRIC KEYPLAN LEVEL 1

Revisions:	Date
1 ADD. NO. 01	7 SEP 2017

VISN 7 NETWORK CONTRACTING OFFICE
LAVISTA BUSINESS PARK-BLDG A 2008 WEEMS RD
TUCKER, GA 30084

U.S. Department of Veterans Affairs

ARCHITECT/ENGINEERS:

PROJECT LEAD
Architect, Structural Engineer, Civil Engineer
GUIDON DESIGN
GUIDON DESIGN INC.
905 N. CAPITOL AVE. SUITE 100 | INDIANAPOLIS, IN. 46204
317.800.6388 | WWW.GUIDONDESIGN.COM
SUSTAINABLE ARCHITECTURE + ENGINEERING

MEP Engineer
AECOM
One Midtown Plaza
1360 Peachtree Street NE
Atlanta, GA 30309
Tele: 404 965-9600

Functional Design
Carl Walker Inc.
14045 Ballantyne Corporate Place, Suite 380
Charlotte, NC 28277
Tele: 704-716-8000

COMPLETE DESIGN - ISSUED FOR CONSTRUCTION

Drawing Title: LEVEL 1 - HVAC AND PLUMBING PLAN	Project Title: PARKING DECK, TRINKA DAVIS VETERANS VILLAGE	Project Number: 16.1043	OFFICE OF FACILITIES MANAGEMENT
		Building Number:	
Approved for Design Concept: **FACILITY MANAGEMENT DIVISION MANAGER**	Location: CARROLLTON, GA	Drawing Number: MP101	VA Project Number: **508-342**
	Date: 07/05/2017 · Checked By: BMS · Drawn By: SPS		U.S. Department of Veterans Affairs

C:\Revit\Local\16.1043-MI-VA Trinka Davis Parking Garage_matthew.bodine.rvt