





Job Number 108402 Sheet _____ of _____ Page _____
Project Marion VA Remodel
By JML Date 9/7/17
Checked _____ Date _____
Subject HSS 8x8 Column Base Plates @ Y.01-8.1, Y.01-14.5, Z.8-12.1

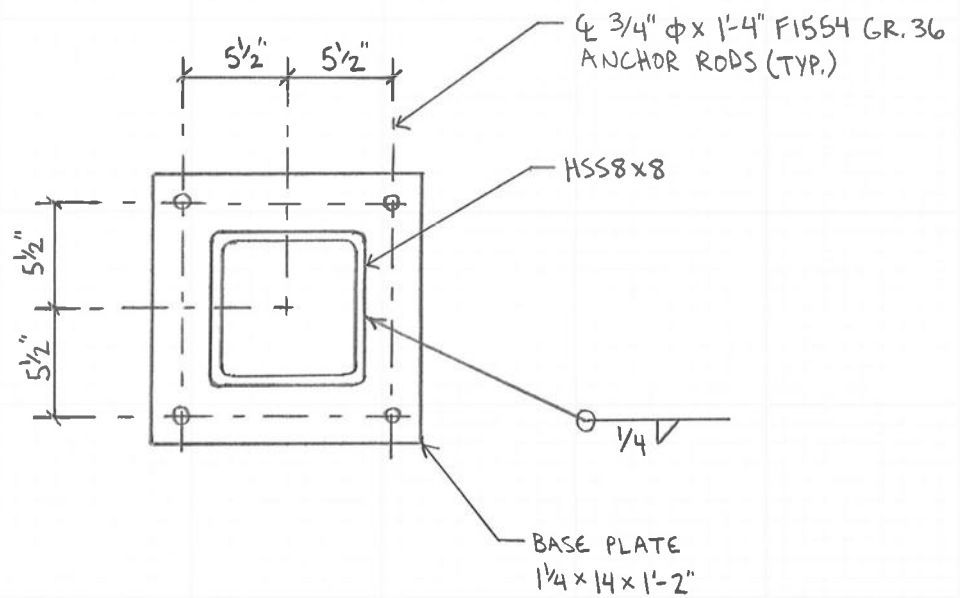




Job Number 108402 Sheet _____ of _____ Page _____
Project Marion VA Remodel
By JML Date 9/7/17
Checked _____ Date _____
Subject HSS5x5 Column Base Plates @ Y.5-14.5, Y.5-14.8, Z.1-14.8

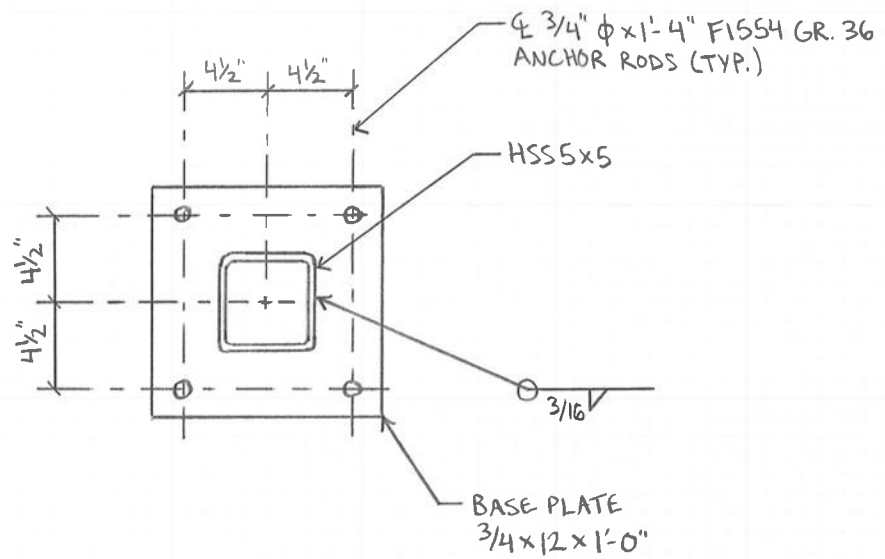

Welds for Column Base Plates @ Y.01-4.4 and Z.5-4.4

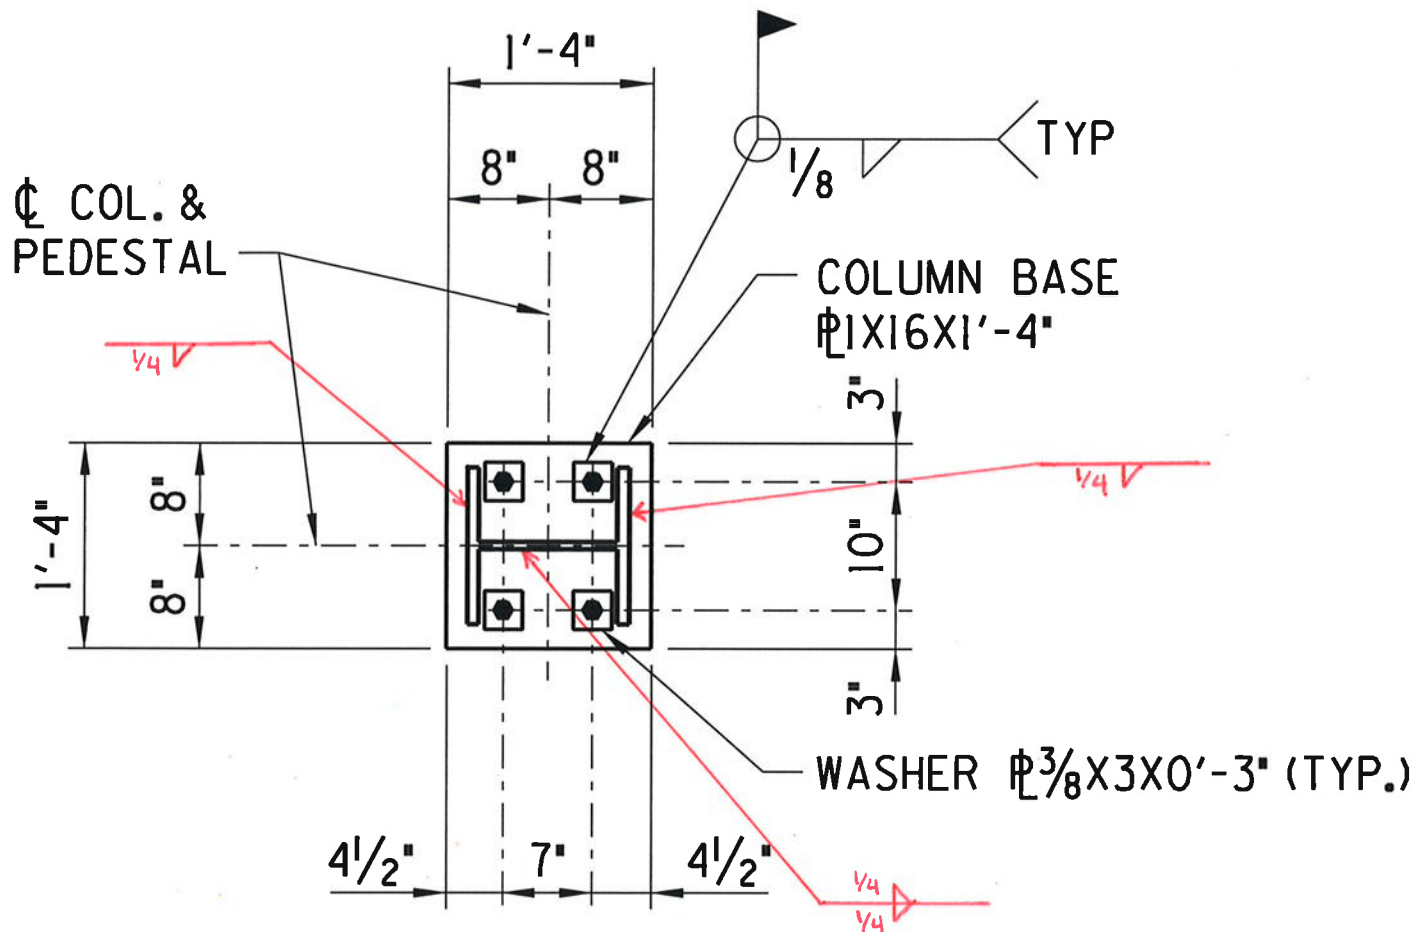

SECTION

SCALE: NOT TO SCALE

F60

S204