


George E. Wahlen Department of Veterans
Affairs Medical Center
Salt Lake City, Utah 84148


Limited Asbestos Material Survey : Building 14 (First Level)

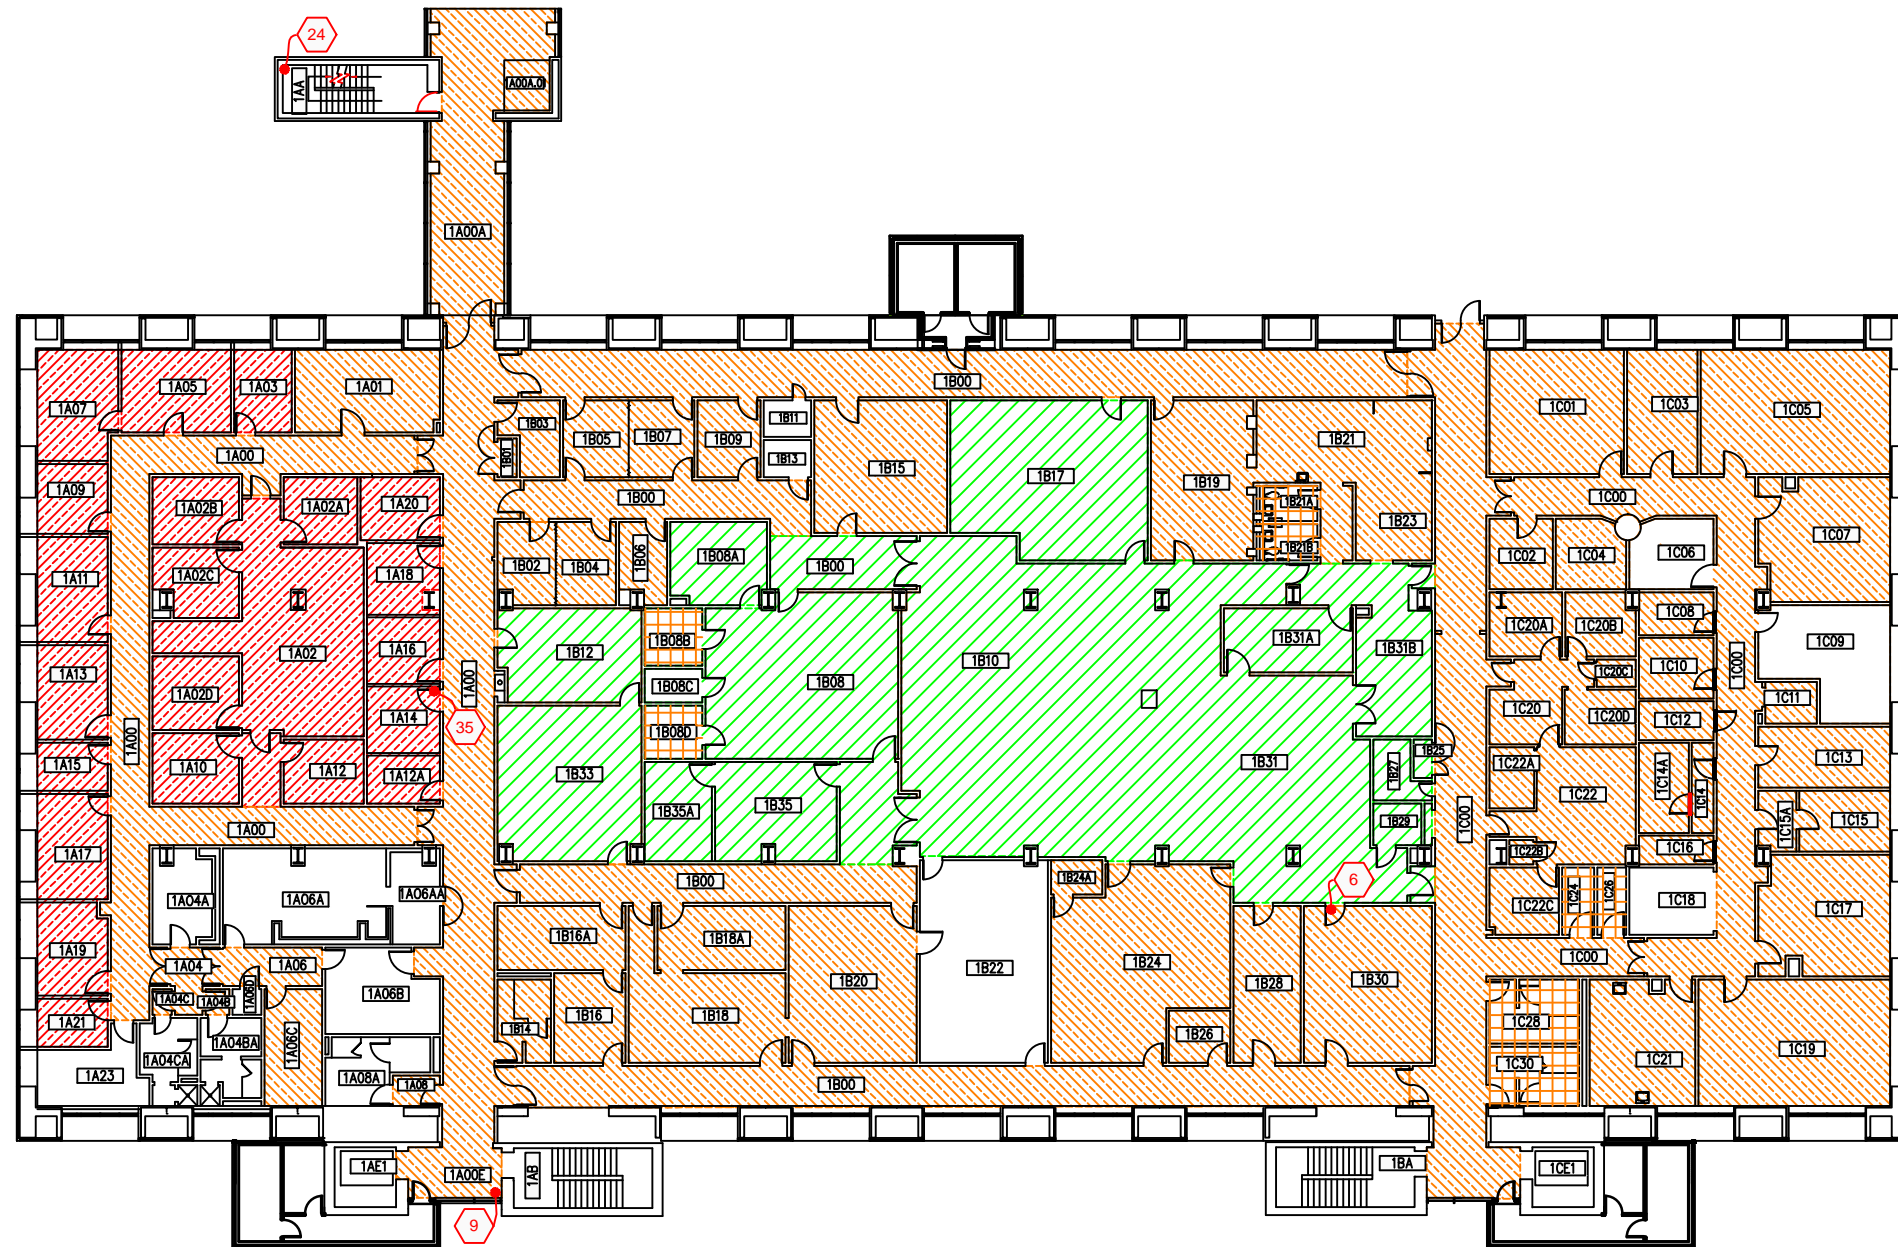

Explanation:

- 2B40 Room Numbers
- xxx Asbestos Sample Locations And Numbers
- Asbestos-containing Floor Tile
- Asbestos-containing Floor Tile And Black Mastic
- Asbestos-containing Floor Tile And Black Mastic Under Glued-down Carpet
- Asbestos-containing ceramic tile (Assumed)

Note : Black Floor Mastic is ACM

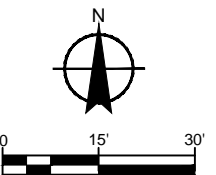

| | |
|--------------|-----------|
| PROJECT No: | 14950.01 |
| SHEET: | 3 |
| DRAWN BY: | S. Rahman |
| DATE: | 11-12-10 |
| REVISED BY: | Tom |
| DATE: | 2-17-2017 |
| REVIEWED BY: | |
| DATE: | |