one eighth inch = one foot

one quarter inch = one foot

three eighths inch = one foot

one half inch = one foot

three quarters inch = one foot

one inch = one foot

one and one half inches = one foot

three inches = one foot

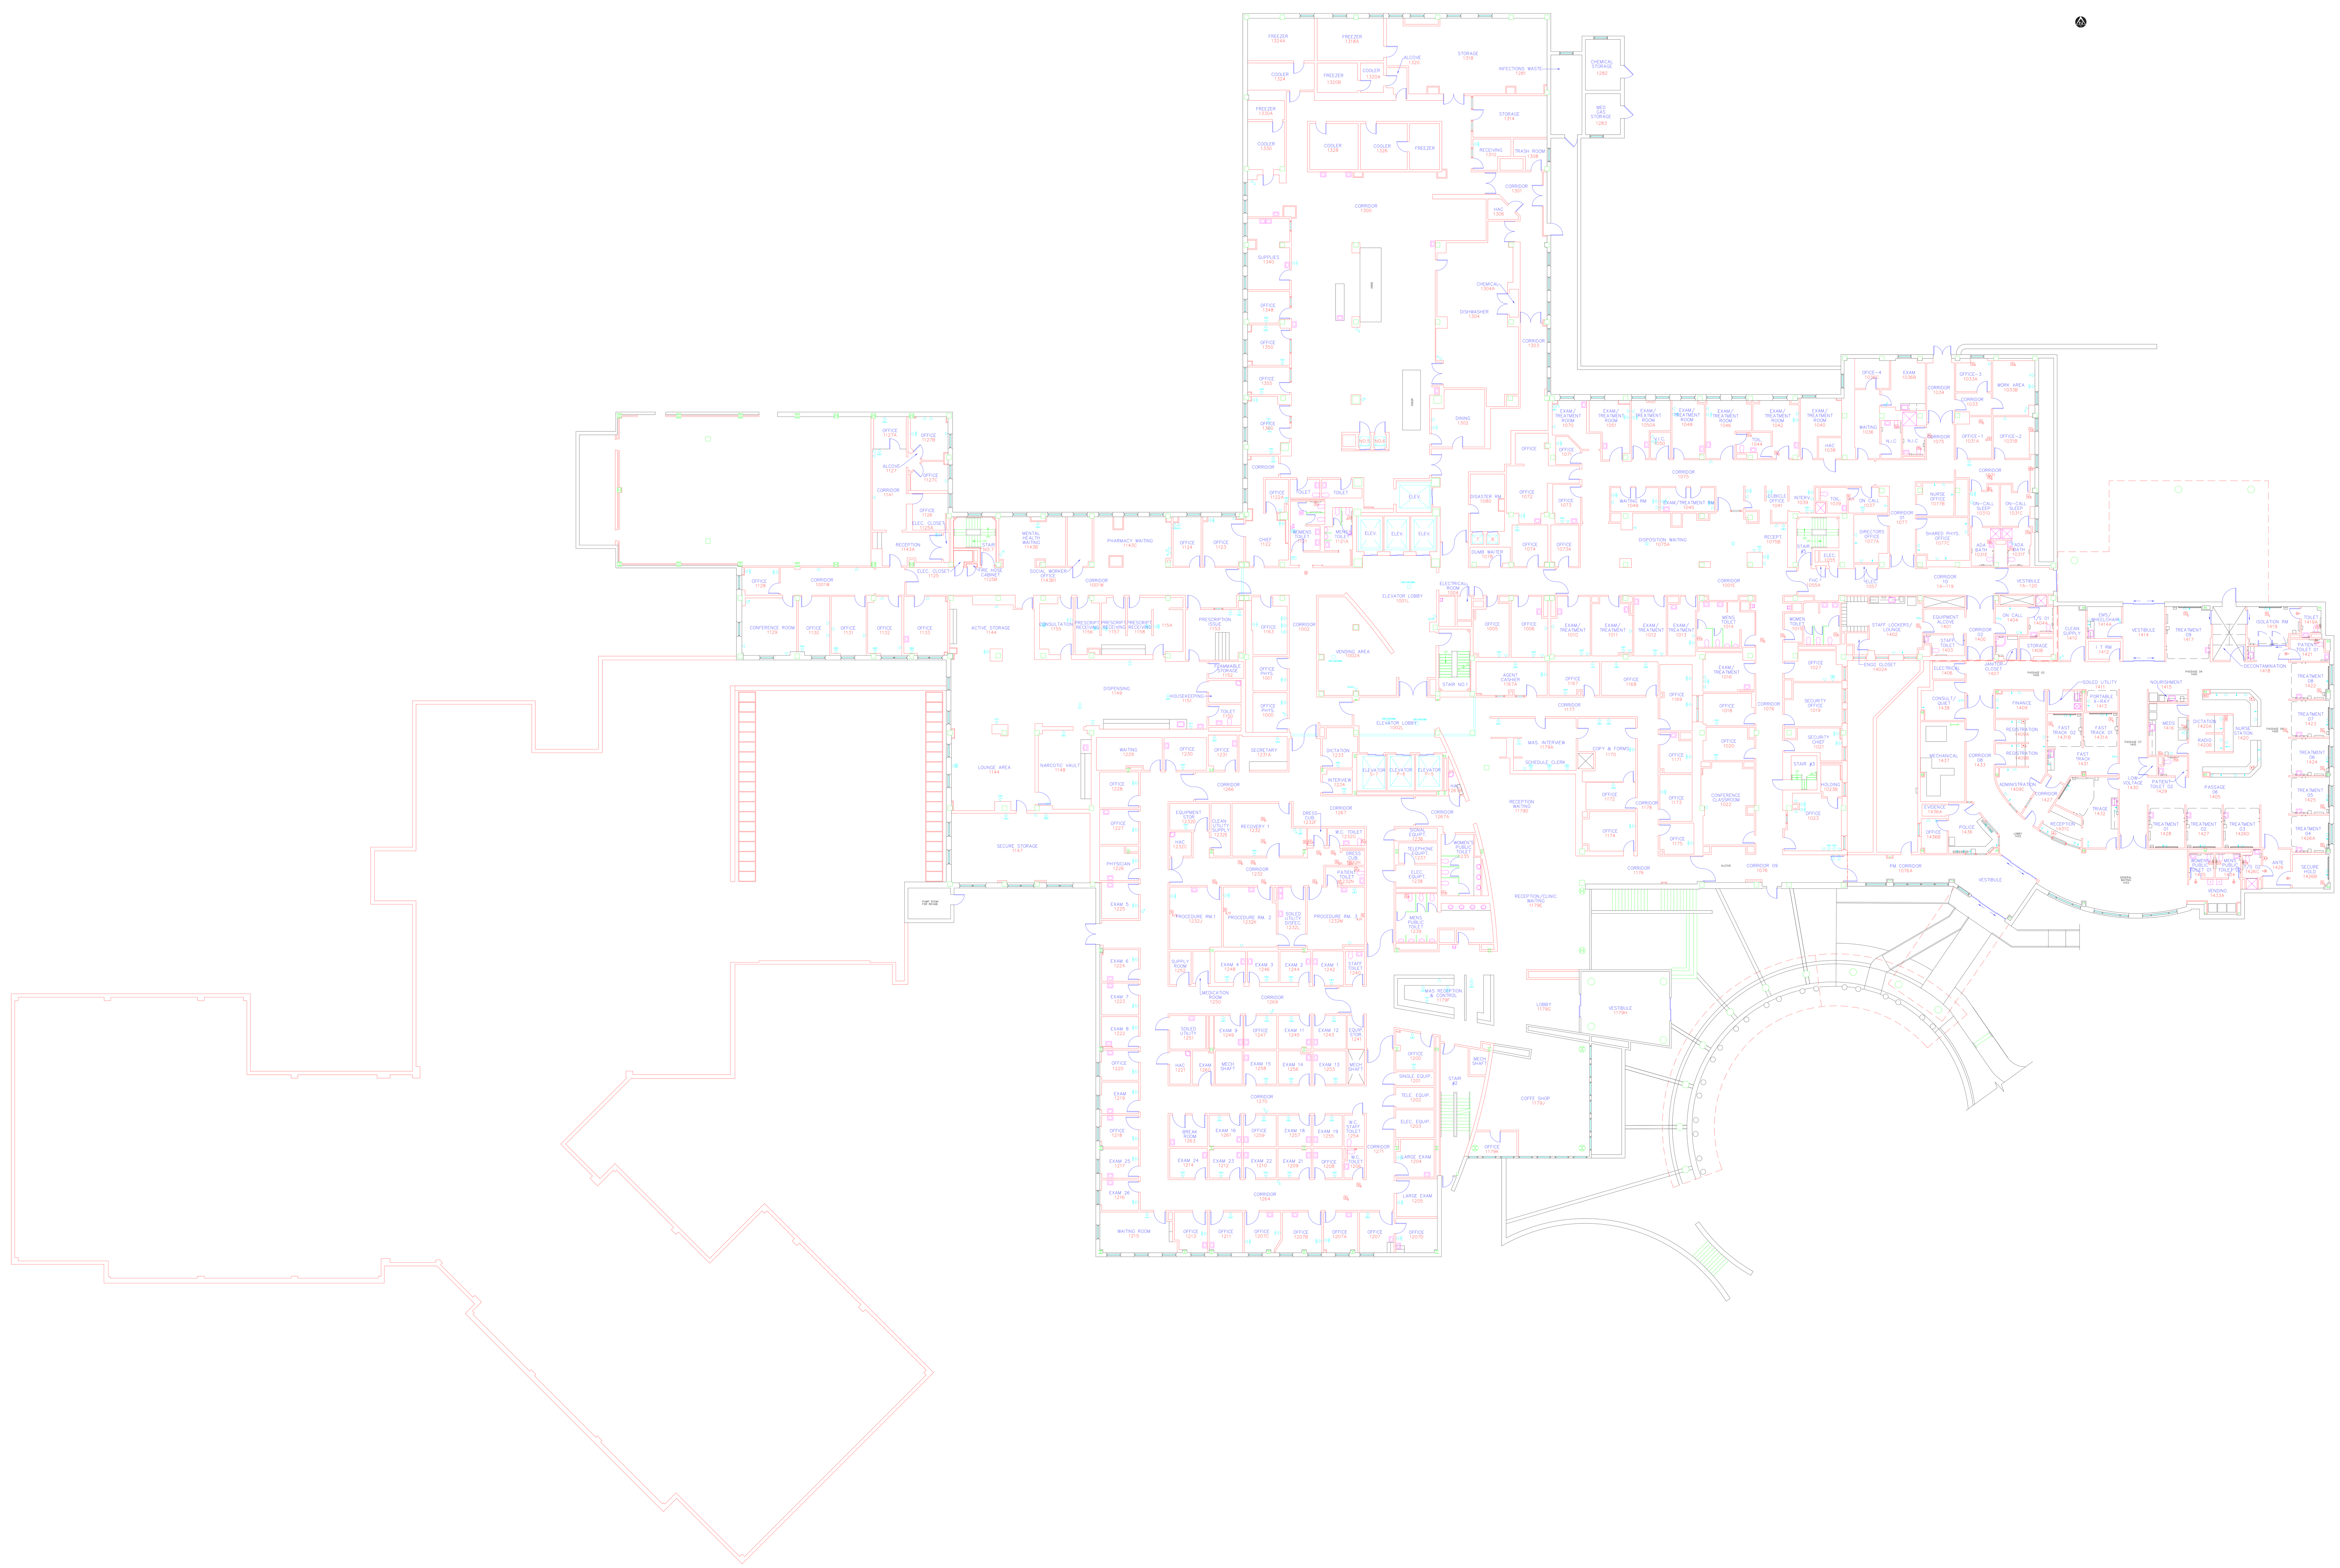

LEGEND

SYMBOL	DESCRIPTION
	TELEPHONE OUTLET
	1-DATA
	2-DATA
	3-DATA
	4-DATA
	5-DATA
	NURSE CALL STATION
	MASTER ANTENNA OUTLET BOX
	EMERGENCY POWER SHUTOFF BUTTON
	OUTLET FOR TV MONITOR (CCTV SYSTEM)
	REMOTE DICTATING SYSTEM OUTLET MTD
	NURSE CALL MASTER STATION
	NURSE CALL STATION EMERGENCY
	NURSE CALL STATION EMERGENCY
	NURSES CALL DOME LIGHT
	NURSES CALL DUTY STATION
	NURSES CALL DUTY STATION WALL MOUNTED
	SPEAKER
	NURSE CALL AUDIO VISUAL WALL STATION
	NURSE CALL DOME LIGHT CEILING MOUNTED
	SMOKE DETECTOR
	FIRE ALARM STROBE
	PUSH PLATE
	TELEPHONE OUTLET (WALL TYPE)

Revisions | Date

Professional Seal

Indus Systems, Inc.
2352, Main Street, Concord MA 01742
Tel: 978-461-0555
www.indus-systems.com

Drawing Title: FIRST FLOOR PLAN TELECOMMUNICATION

Approved:

Approved:

Project Title: AS-BUILT Drawings

Building Number: 01

Checked

Drawn

Location: VAMC WILMINGTON DELAWARE

Date: 08-15-2015

Project No.

Drawing No. 460-1-1-TL

VAMC, WILMINGTON

VA Department of Veterans Affairs

VA FORM 08-6231, OCT 1978