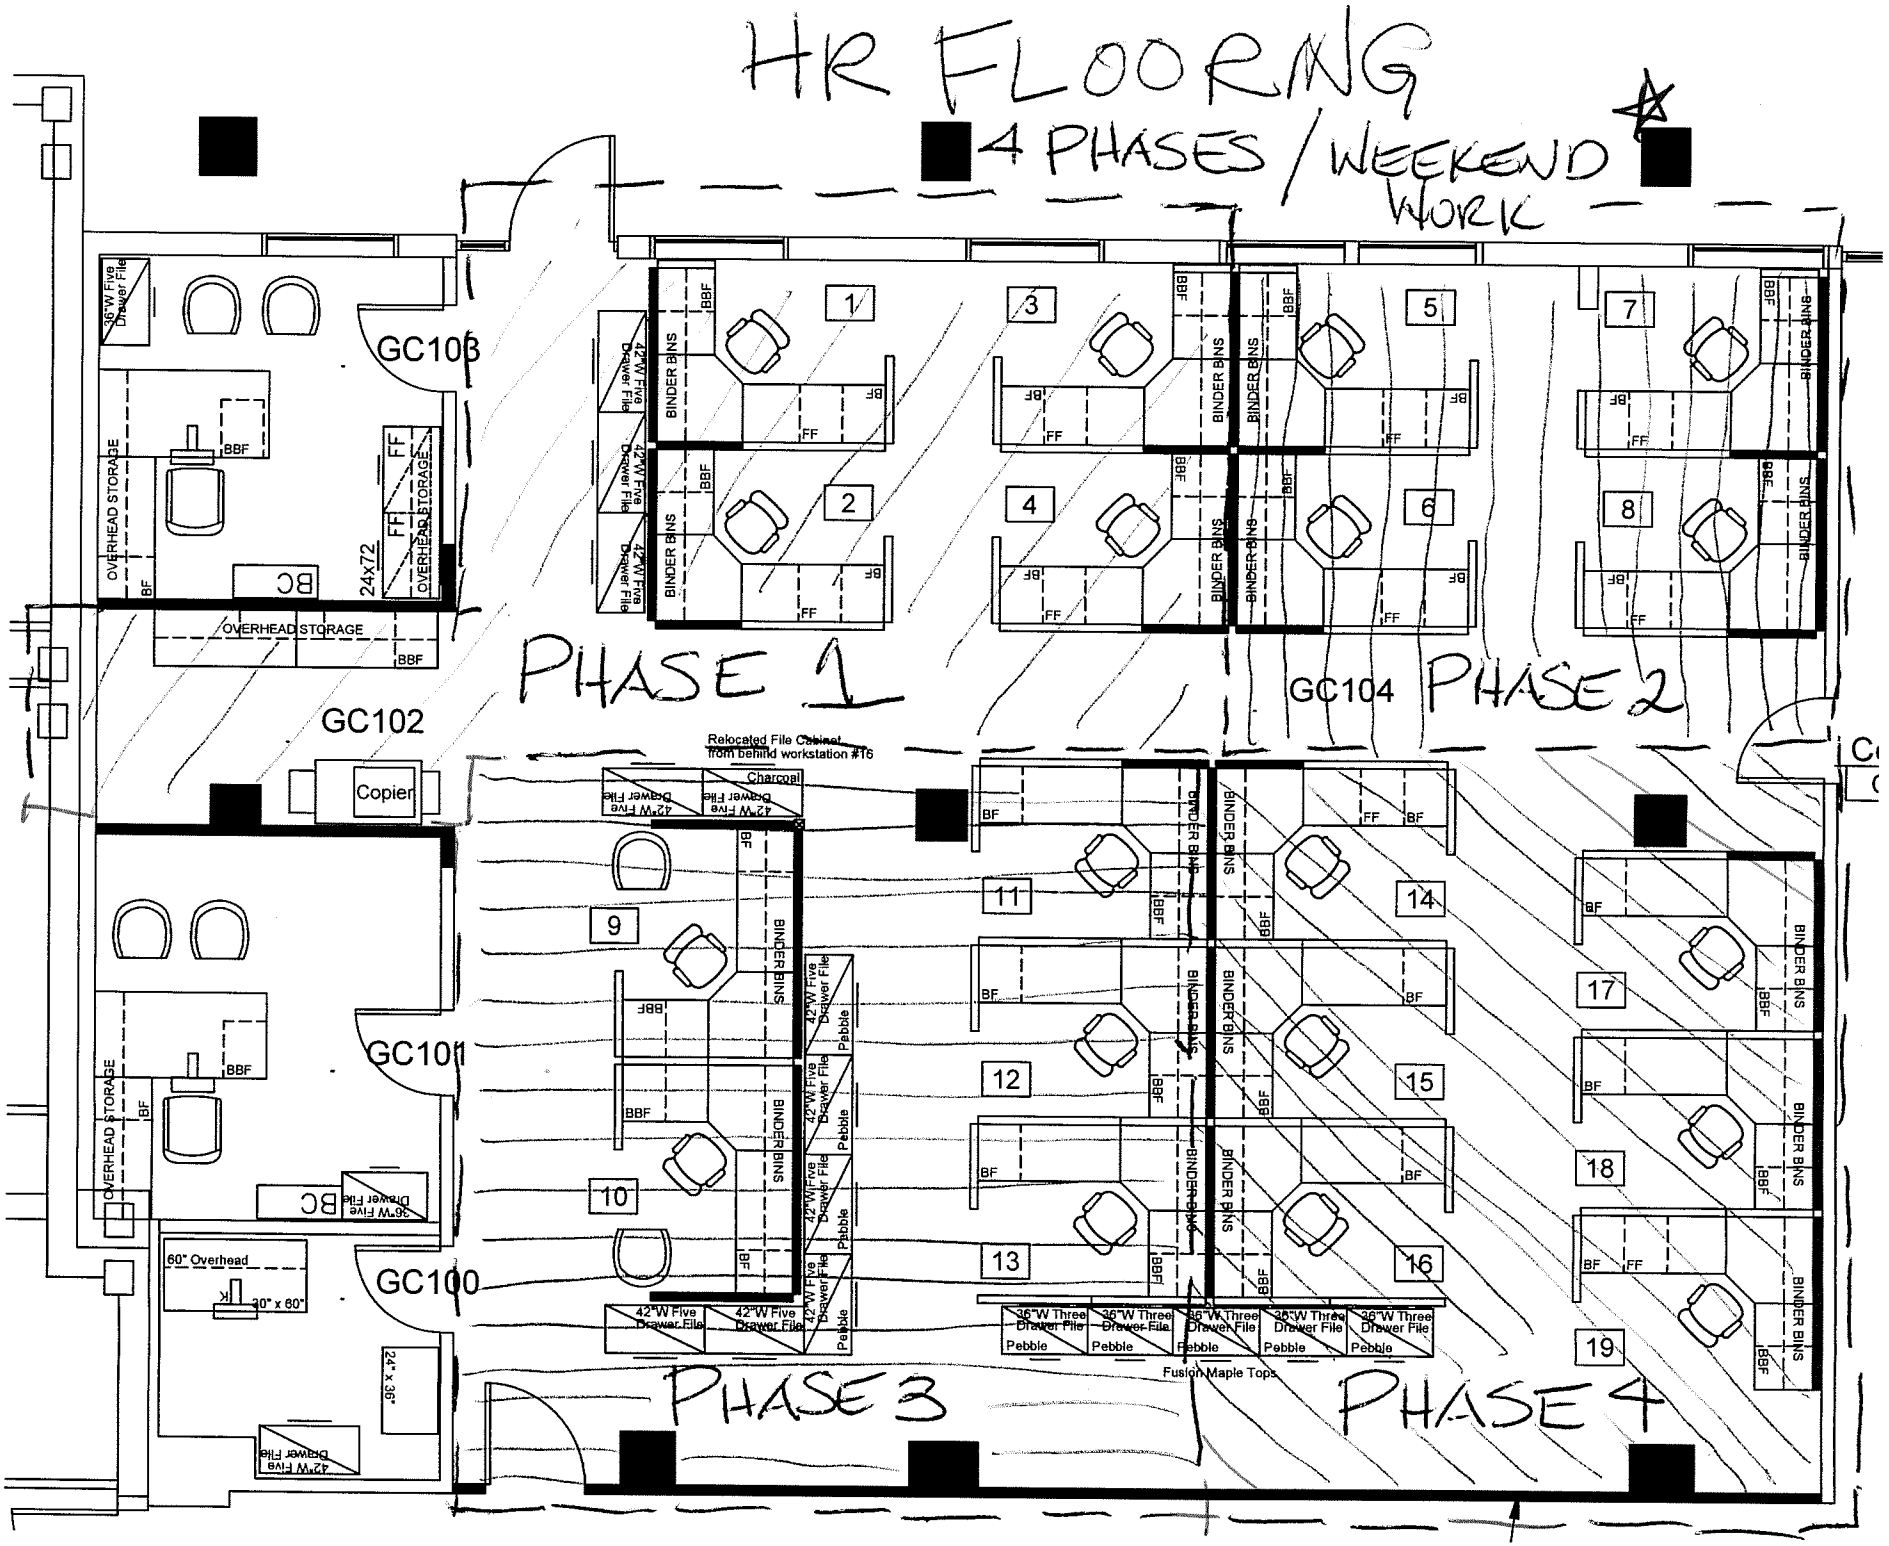
HR FLOORING
4 PHASES / WEEKEND WORK
PHASE 1
PHASE 2
PHASE 3
PHASE 4
GC103
GC102
GC101
GC100
GC104
Copier
Relocated File Cabinet from behind workstation #16
Charcoal
Fusion Maple Tops
OVERHEAD STORAGE
BINDER BINS
36"W Five Drawer File
42"W Five Drawer File
36"W Three Drawer File
Pebble
60" Overhead
30" x 60"
24" x 36"
24x72
BC
BBF
BF
FF
1
2
3
4
5
6
7
8
9
10
11
12
13
14
15
16
17
18
19