


SANITARY AND VENT RISER DIAGRAM
N.T.S.

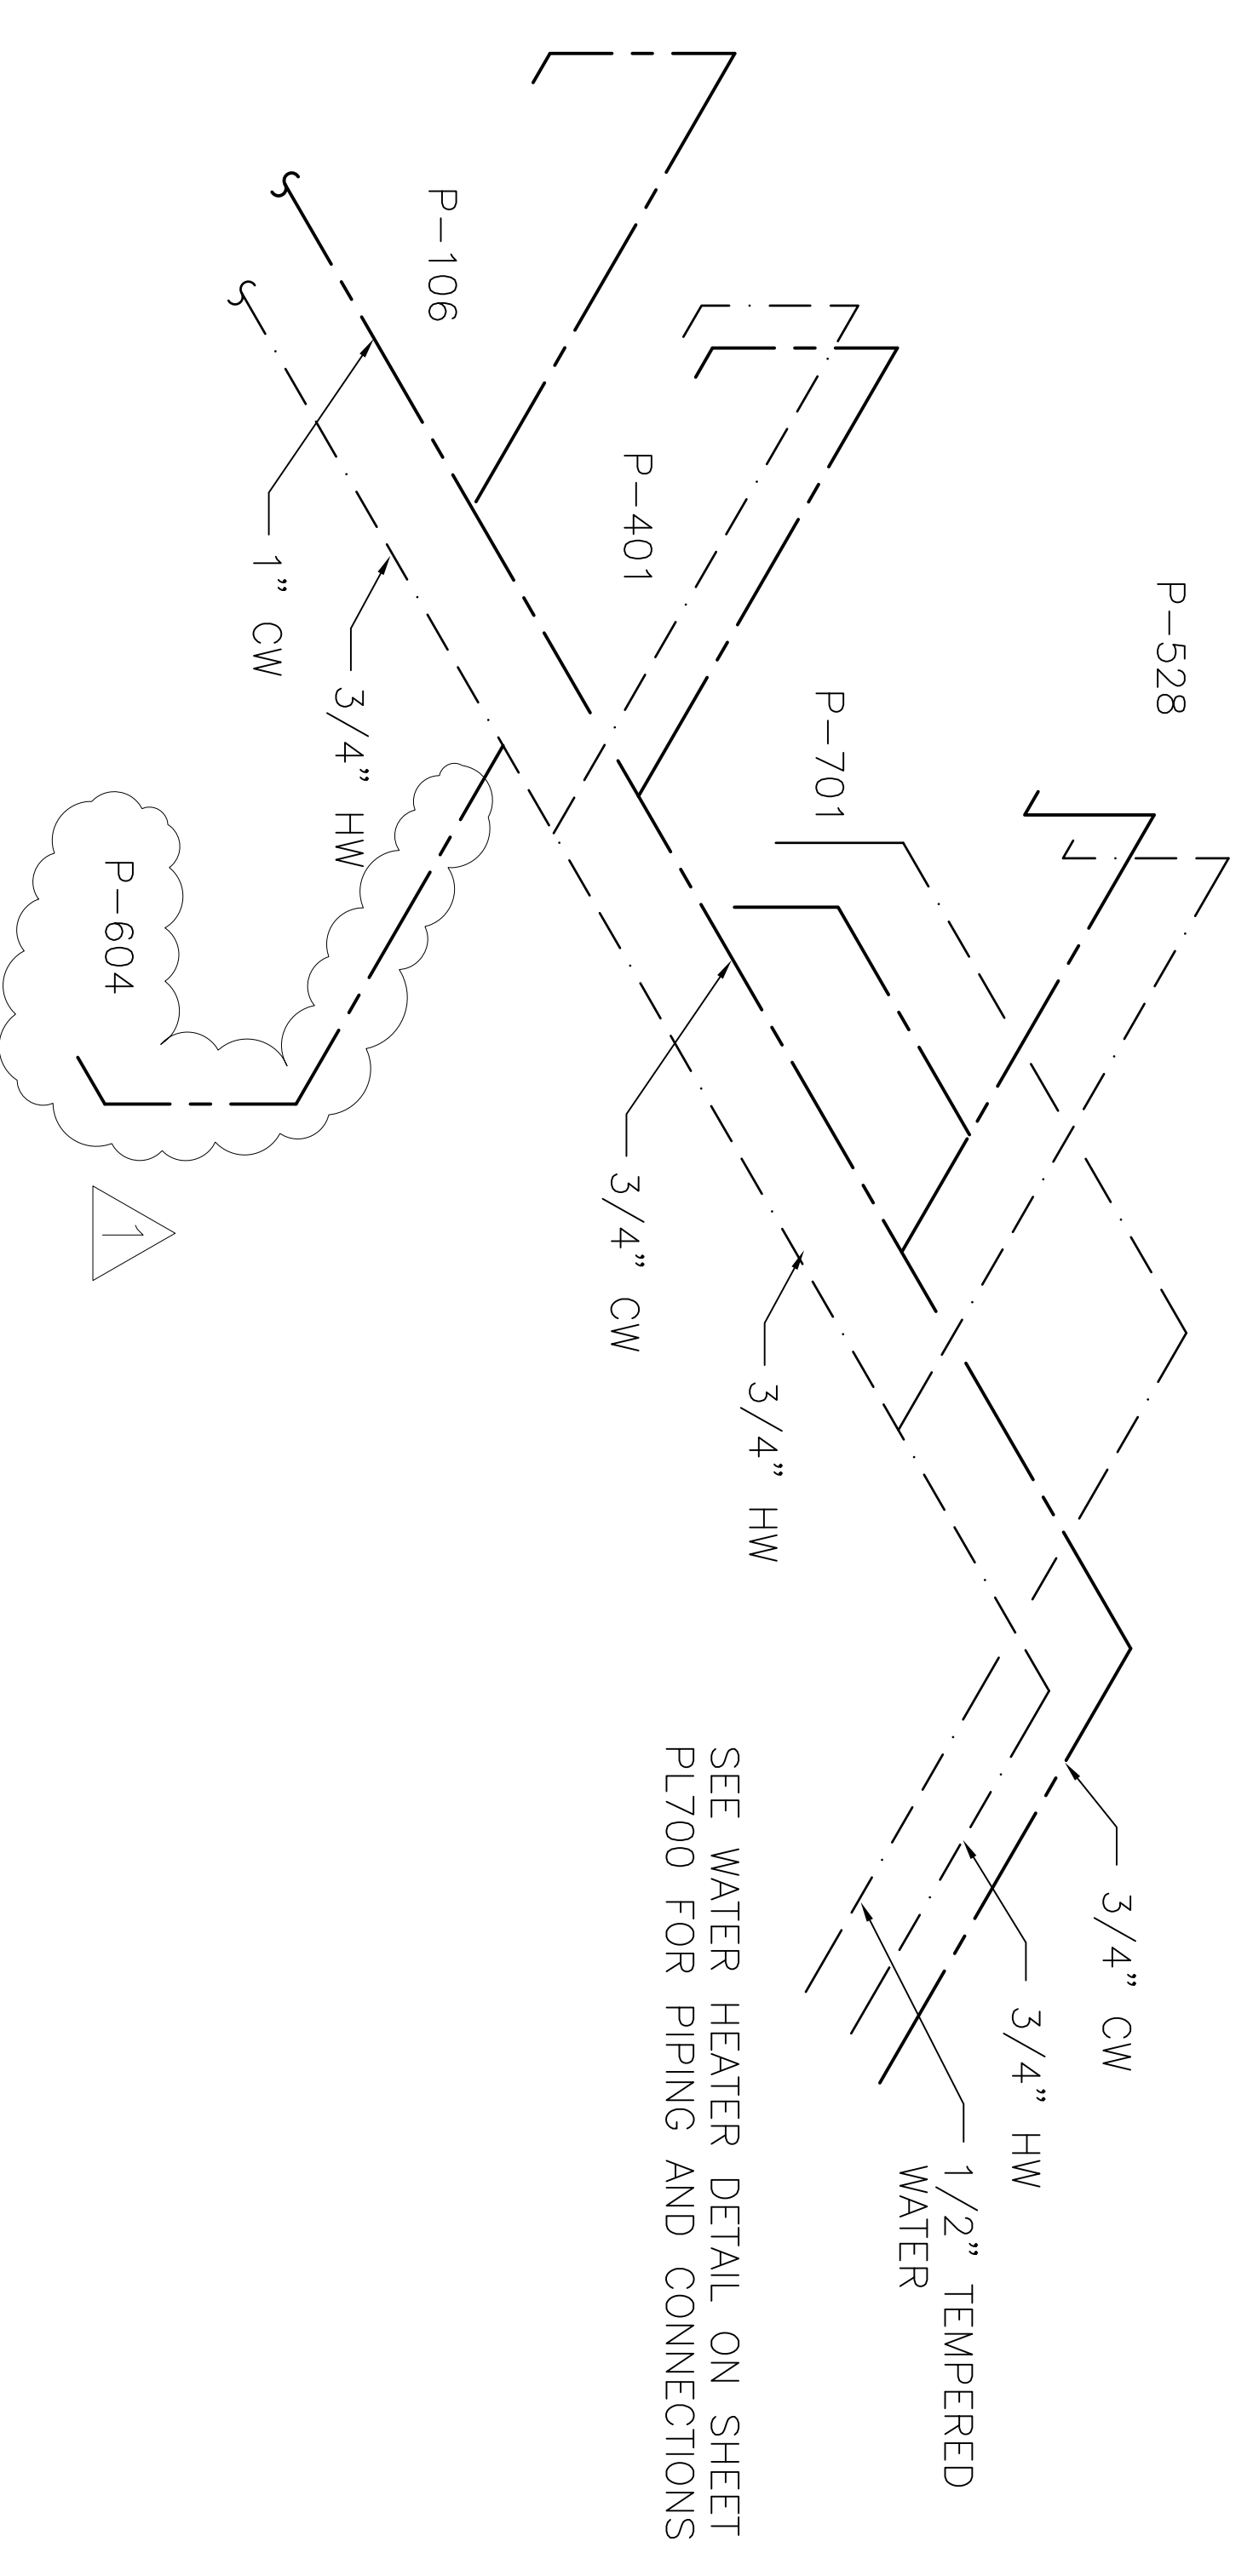

HOT AND COLD WATER RISER DIAGRAM
N.T.S.

Addendum 3 odd EWC	9-8-17
DATE	

CONSULTANTS: SHEPHERD-AFENBERG STEPHEN T. STREBE P.E. NO. 70349	ARCHITECT/ENGINEERS: ARCA INC. 3603 NW 98th Street, Suite B Ocala, FL 32908 Phone: (352) 474-6124 Fax: (352) 553-4437 OOK: FL #26903 ARCA Project No. 083-14
Drawing Title SANITARY AND WATER PIPING RISER DIAGRAMS Approved: Project Director	Project Title REPLACE BOILERS - FCA D. ENERGY AT THE MALCOM RANDALL VAMC Location GAINESVILLE, FLORIDA Date JULY 8, 2016 Checked STS Drawn CRF
	Project Number 573-14-600 Building Number PL800 Drawing Number PL800
Office of Construction and Facilities Management Department of Veterans Affairs	

FINAL DESIGN
APPROVED FOR CONSTRUCTION