


three inches = one foot
 one and one half inches = one foot
 one inch = one foot
 three quarters inch = one foot
 one half inch = one foot
 three eighths inch = one foot
 one quarter inch = one foot
 one eighth inch = one foot

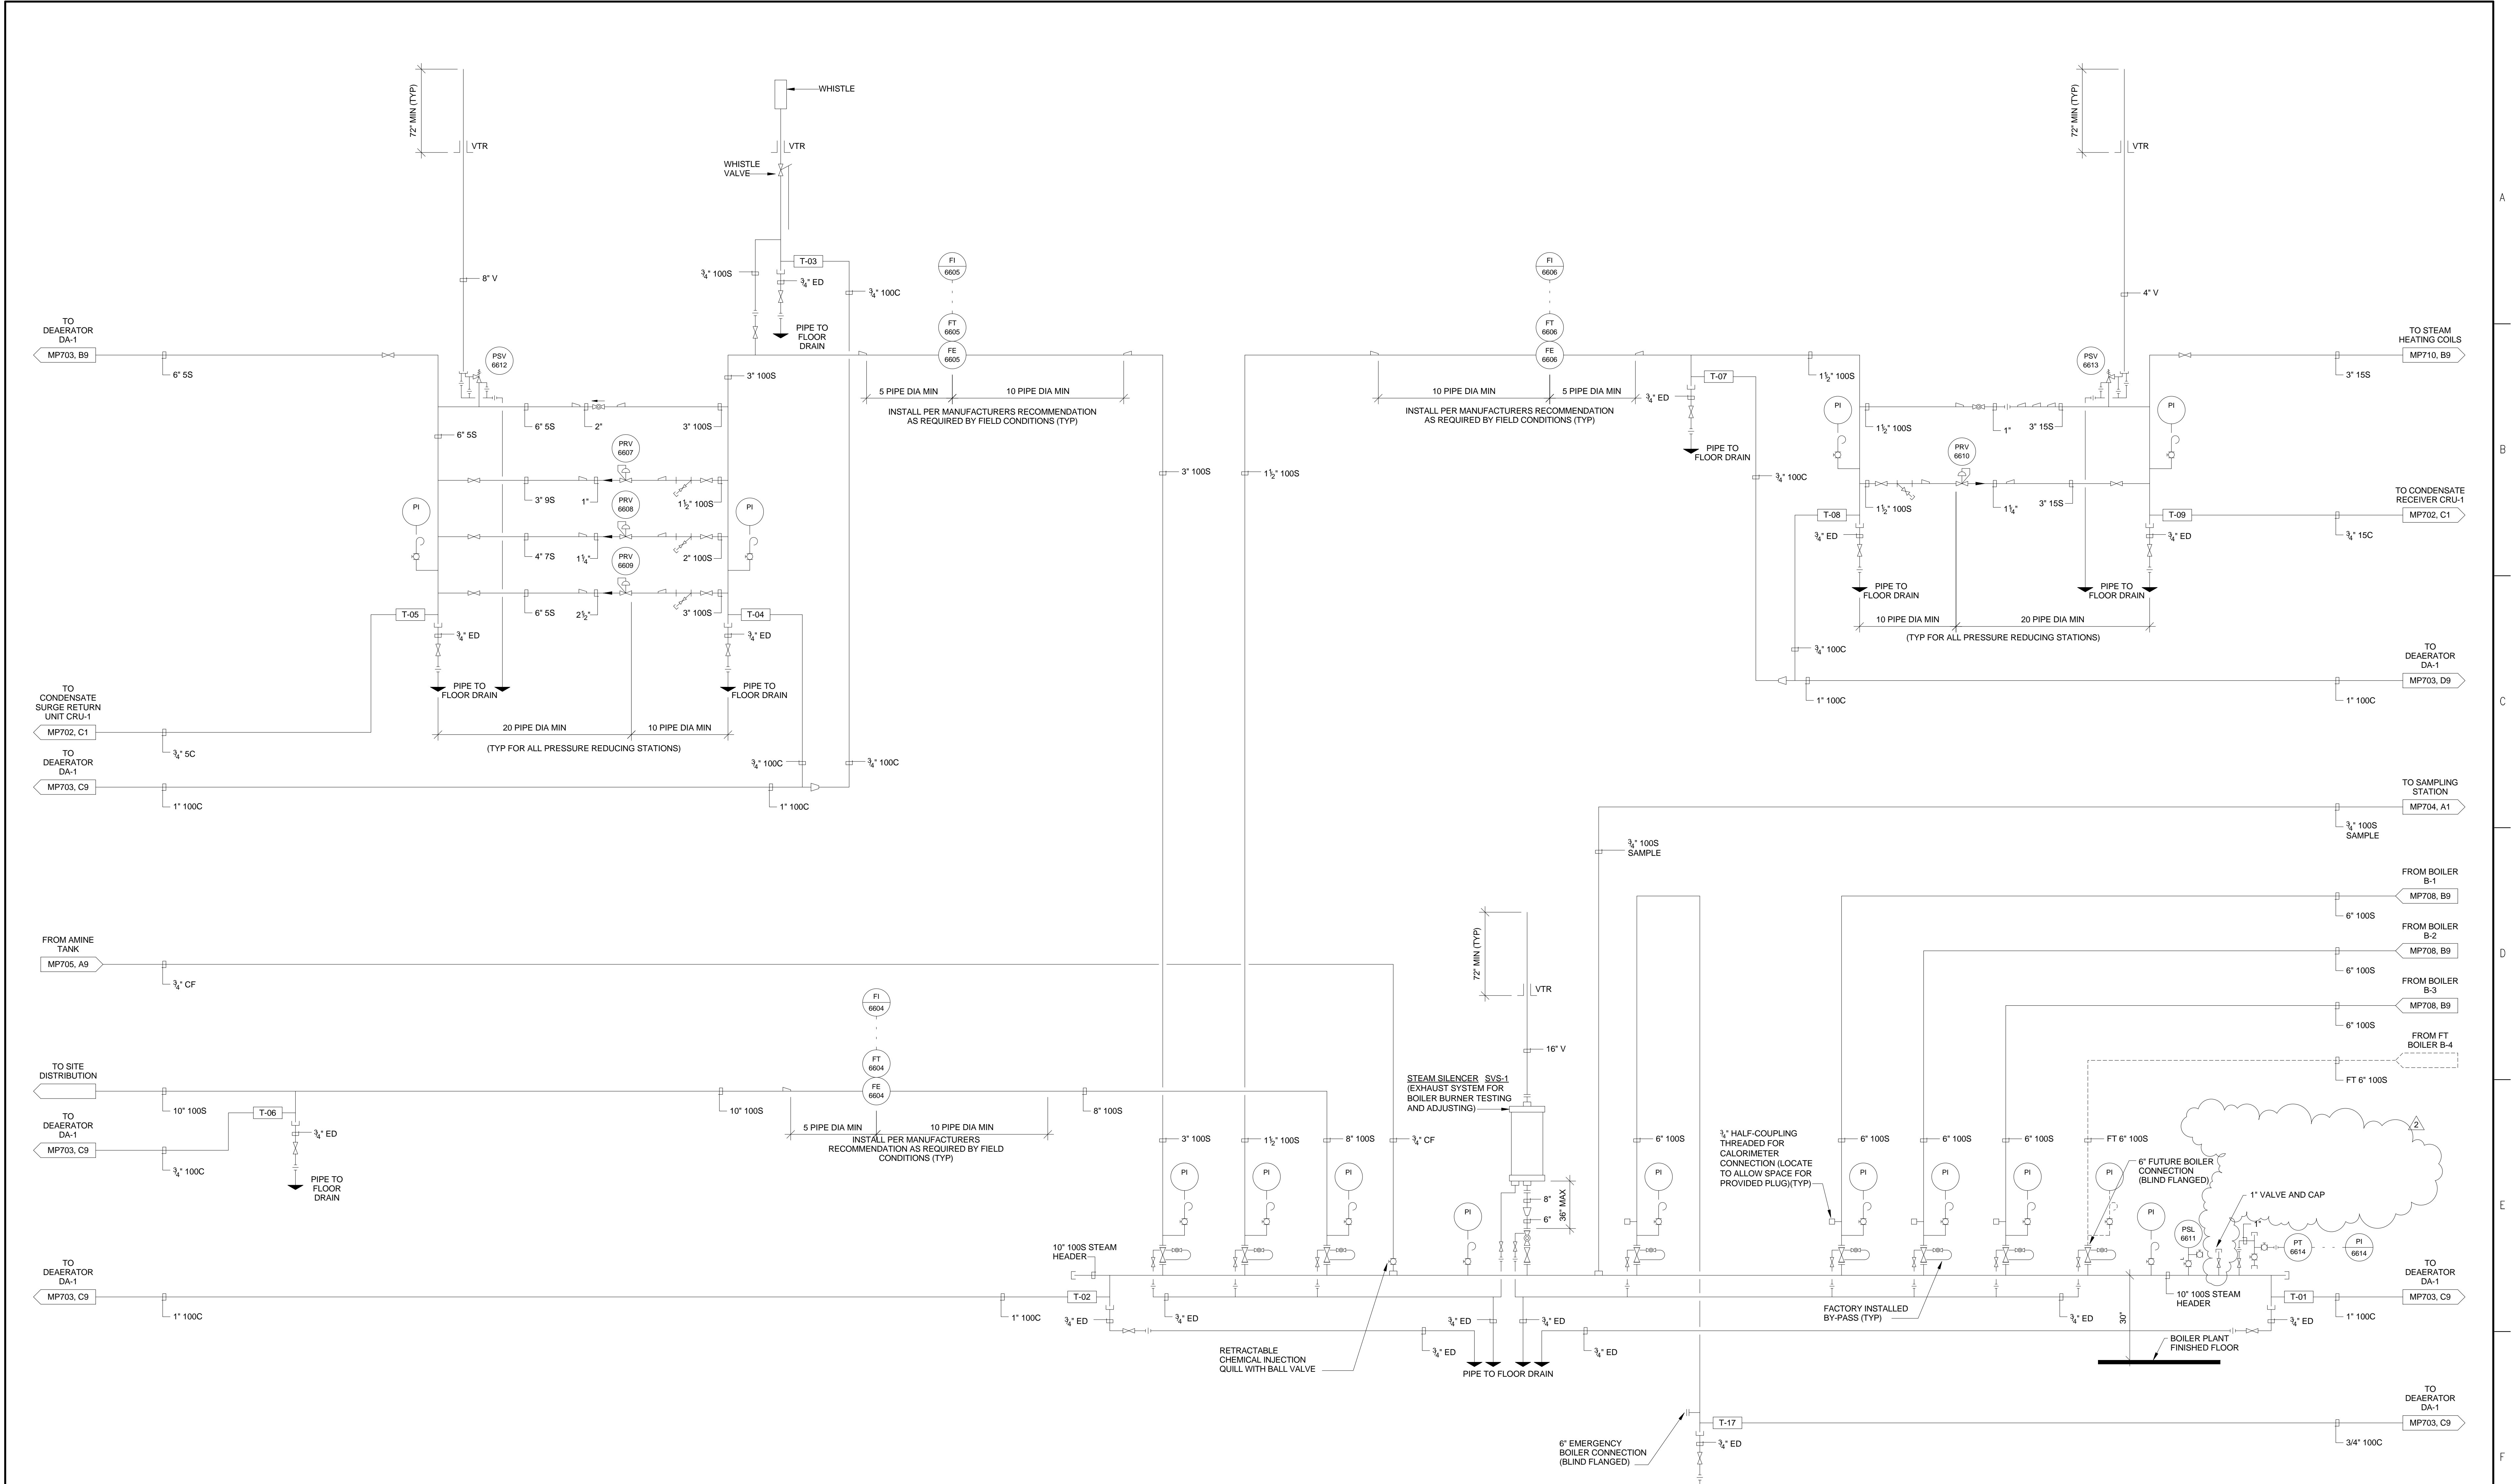

STEAM SYSTEM SCHEMATIC

FINAL DESIGN
APPROVED FOR CONSTRUCTION

CONSULTANTS: Affiliated Engineers SE, Inc. Tioga Town Center 12921 SW 1st Road Ste 205 Gainesville, Florida 32669 Tel 352.376.5500 Fax 352.375.3479 CA-6140		ENGINEER-OF-RECORD: JACK STEWART NEALE FL P.E. NO. 42678		ARCHITECT/ENGINEERS: 3603 NW 98th Street, Suite B Gainesville, FL 32606 Phone: (352) 474-6124 Fax: (352) 553-4437 COA: FL #26693 AKEA Project No. 083-14		Drawing Title STEAM SYSTEM SCHEMATIC		Project Title REPLACE BOILERS - FCA D, ENERGY AT THE MALCOM RANDALL VAMC		Project Number 573-14-600 Building Number		Office of Construction and Facilities Management 	
Revisions: 2 - Addendum #3 09/08/17 1 - Addendum #2 08/30/17		Approved: Project Director		Location GAINESVILLE, FLORIDA		Drawing Number MP701		Date JULY 8, 2016		Checked JSN			Drawn RWD