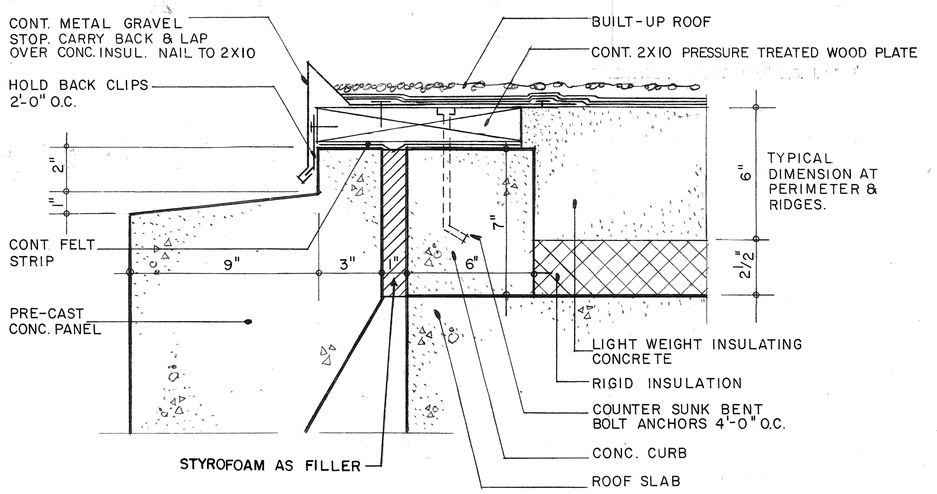

FLASHING DETAIL (F1)
3" = 1'-0"

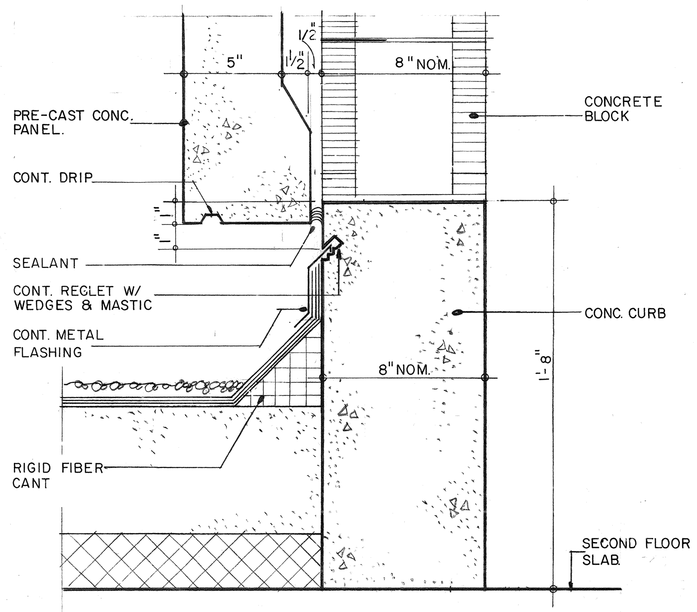

FLASHING DETAIL (F2)
3" = 1'-0"

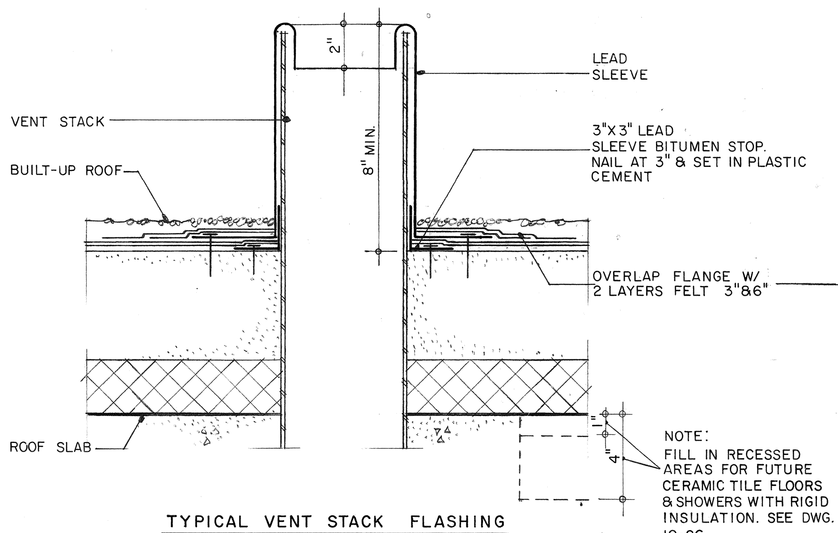

TYPICAL VENT STACK FLASHING
3" = 1'-0"

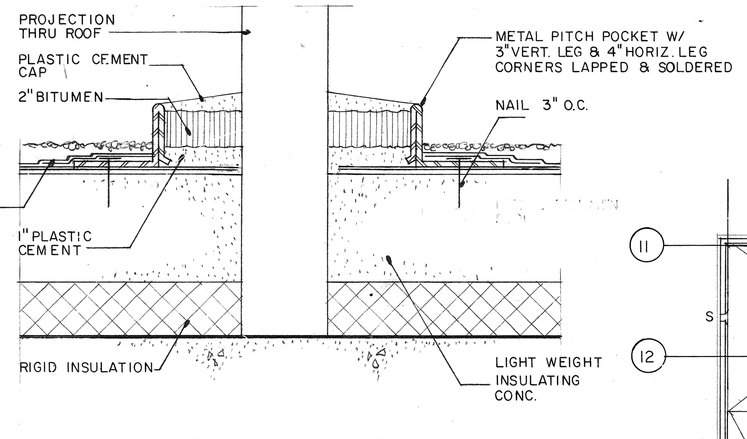

PITCH POCKET DETAIL
3" = 1'-0"

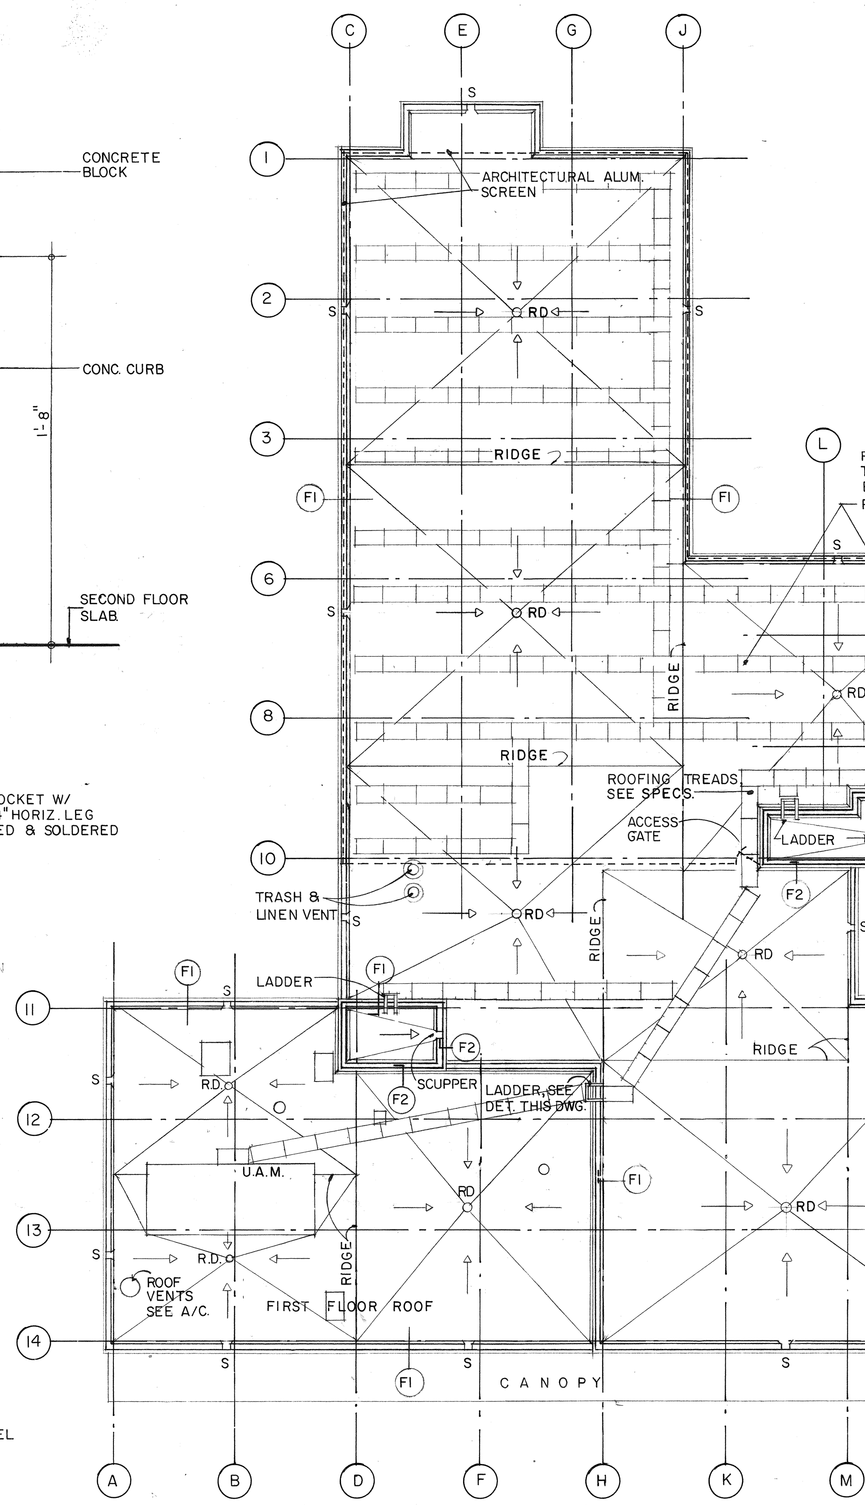

ROOF PLAN
1/16" = 1'-0"

FLASHING DETAIL

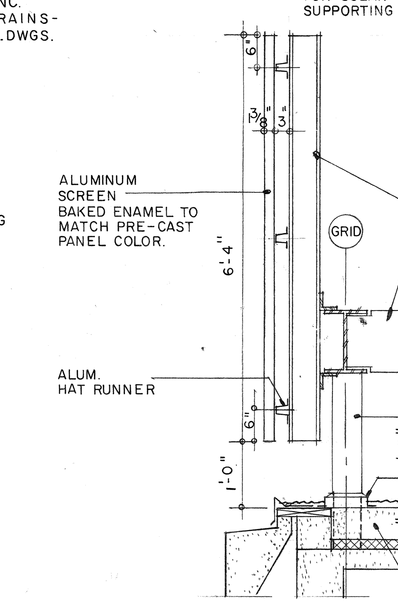

SECTION OF ARCHITECTURAL ALUMINUM SCREEN
3/4" = 1'-0"

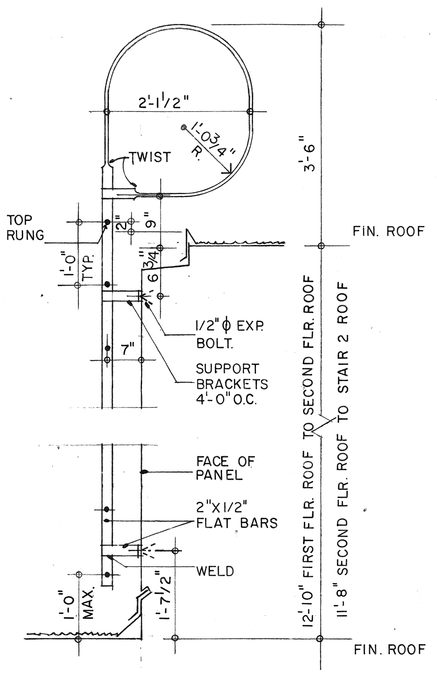

SECTION

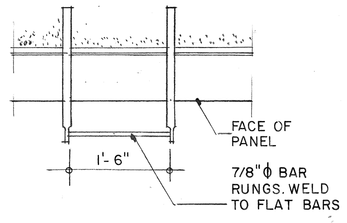

PLAN

ROOF ACCESS LADDER DETAIL
3/4" = 1'-0"

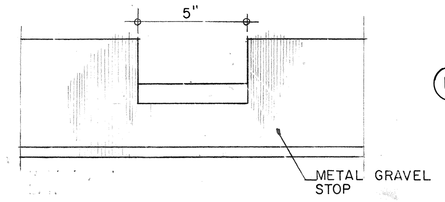

ELEVATION

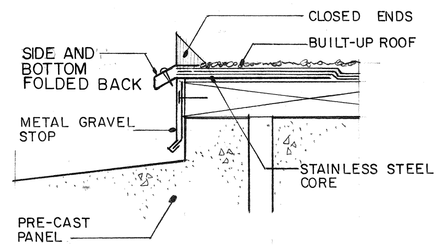

SECTION

OVERFLOW SCUPPER DETAIL
3" = 1'-0"

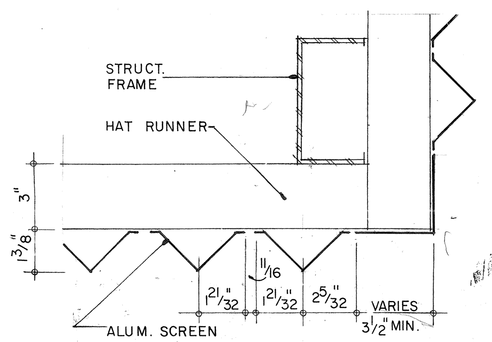

PLAN SECTION - ARCHITECTURAL ALUMINUM SCREEN
3" = 1'-0"

5-3-2-1446

NO.	DATE	REVISIONS
1	8-12-80	AS-BUILT

SHEET TITLE
ROOF PLAN, FLASHING DETAILS
LADDER DETAIL

BLDG. NO. 10
PROJECT TITLE: 120 Bed Nursing Home Care Unit

DRAWN: STIMSON
CHECKED: Walter Hubbard
DATE: JAN 16 1978

The Smith, Korach, Hayet, Haynie Partnership
Architects, Engineers, Planners
175 Fontainbleau Boulevard
Miami, Florida

DRAWING NUMBER: 10 o 4
DWG. 21 OF 122

APPROVED : PROJECT DIRECTOR

PROJECT NUMBER: 546-007

VETERANS ADMINISTRATION

LOCATION: V.A.H. Miami, Florida

STATE OF FLORIDA · WALTER J. HUBBARD · 1834 · MIAMI · REGISTERED ARCHITECT

THREE INCHES EQUALS ONE FOOT
ONE AND ONE HALF INCHES EQUALS ONE FOOT
ONE INCH EQUALS ONE FOOT
THREE QUARTER INCH EQUALS ONE FOOT
ONE HALF INCH EQUALS ONE FOOT
THREE EIGHTH INCH EQUALS ONE FOOT
ONE QUARTER INCH EQUALS ONE FOOT
ONE EIGHTH INCH EQUALS ONE FOOT