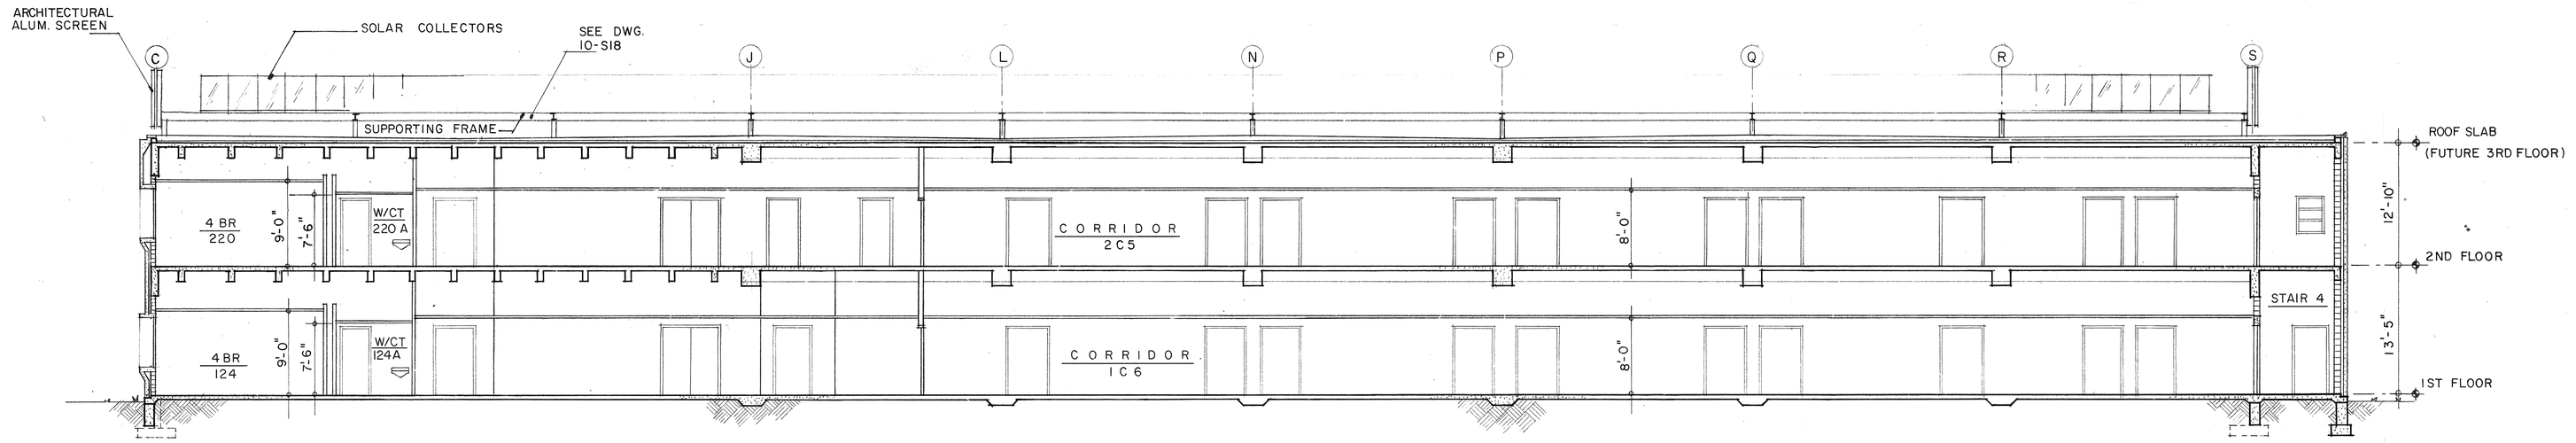

BUILDING SECTION
1/8"=1'-0"

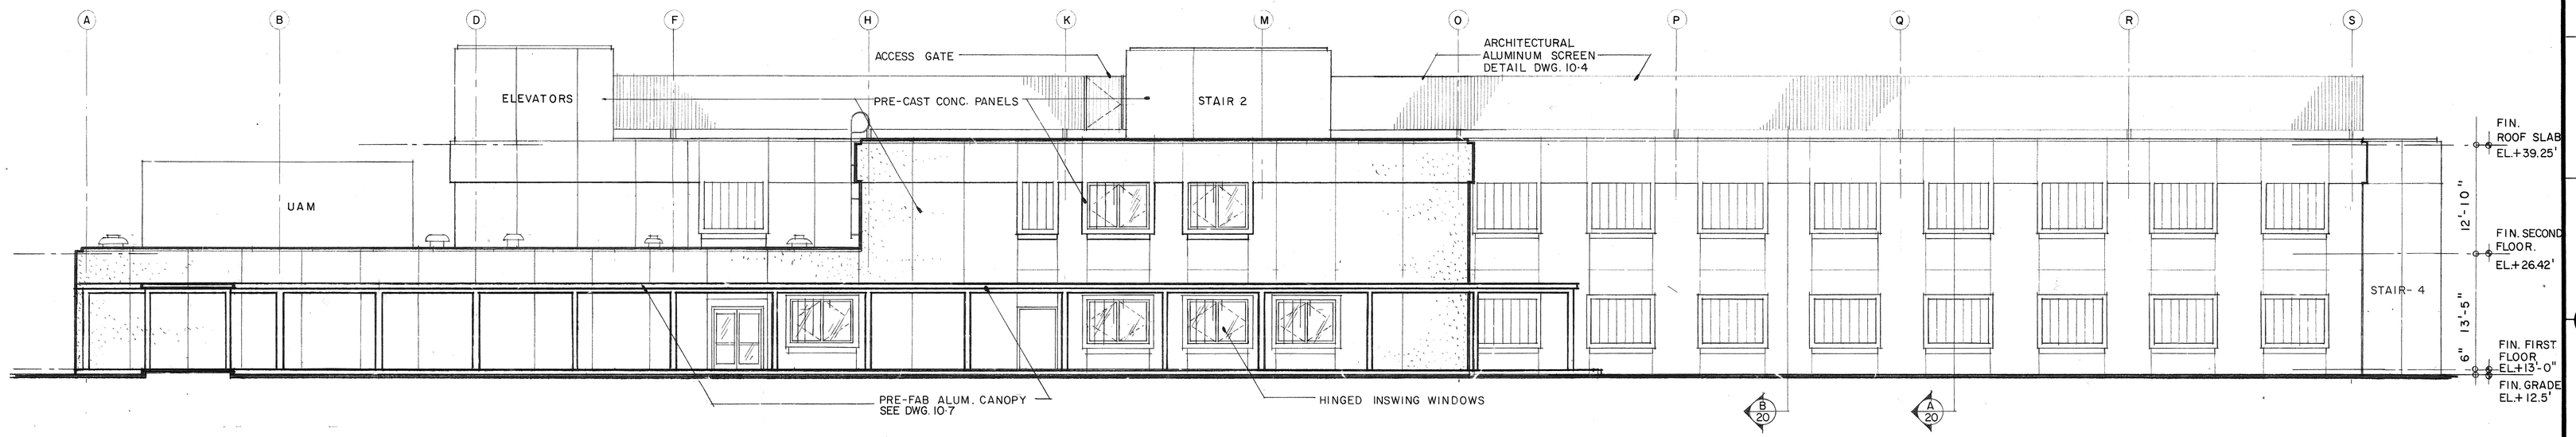

SOUTH ELEVATION
1/8"=1'-0"

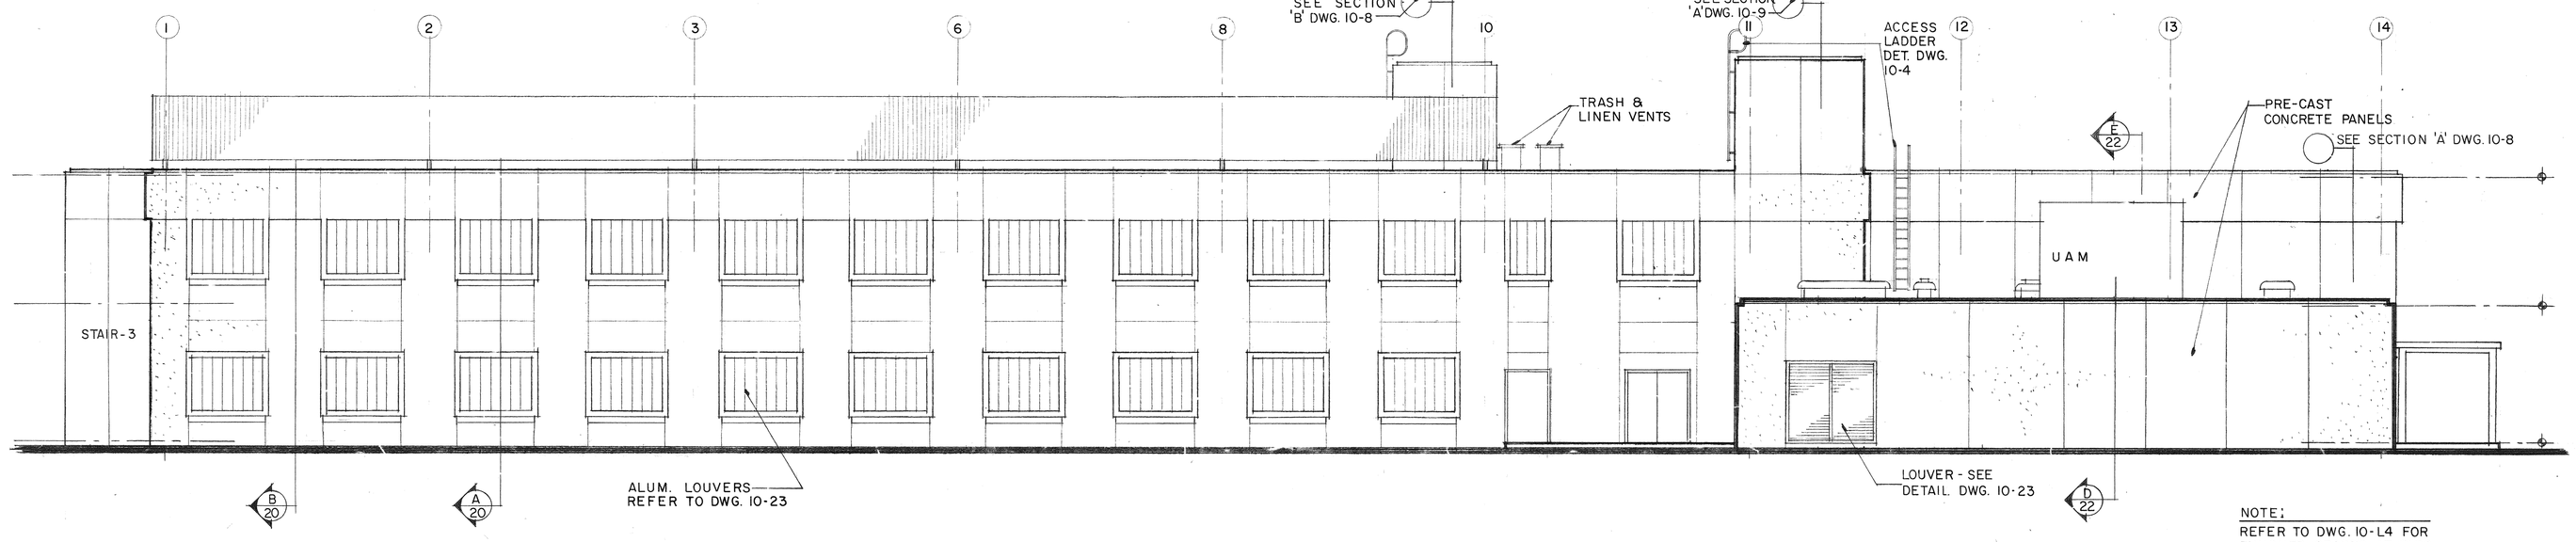

WEST ELEVATION
1/8"=1'-0"

NOTE:
REFER TO DWG. 10-L4 FOR FINISHED GRADES AT BLDG.

5-3-2-1447

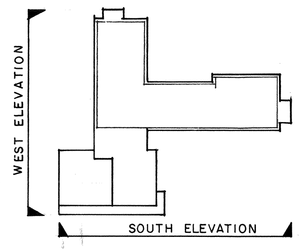

KEY PLAN
NORTH

NO.	DATE	REVISIONS
1	8-12-80	AS-BUILT

SHEET TITLE
BUILDING SECTION AA, SOUTH & WEST ELEVATIONS

BLDG. NO. 10

PROJECT TITLE
120 Bed Nursing Home Care Unit

DRAWN: STIMSON
CHECKED: Walter Hubbard
DATE: JAN 16 1978

The Smith, Korach, Hayet, Haynie Partnership
Architects, Engineers, Planners
175 Fontainbleau Boulevard
Miami, Florida

DRAWING NUMBER: 10 o 5
DWG. 22 OF 122

APPROVED: PROJECT DIRECTOR

PROJECT NUMBER: 546-007

VETERANS ADMINISTRATION

LOCATION
V.A.H. Miami, Florida

STATE OF FLORIDA * WALTER J. HUBBARD * 1834 MIAMI REGISTERED ARCHITECT

THREE INCHES EQUALS ONE FOOT
ONE AND ONE HALF INCHES EQUALS ONE FOOT
ONE INCH EQUALS ONE FOOT
THREE QUARTER INCH EQUALS ONE FOOT
ONE HALF INCH EQUALS ONE FOOT
THREE EIGHTH INCH EQUALS ONE FOOT
ONE QUARTER INCH EQUALS ONE FOOT
ONE EIGHTH INCH EQUALS ONE FOOT