


PLAN - COVERED WALKWAY
1/8" = 1'-0"

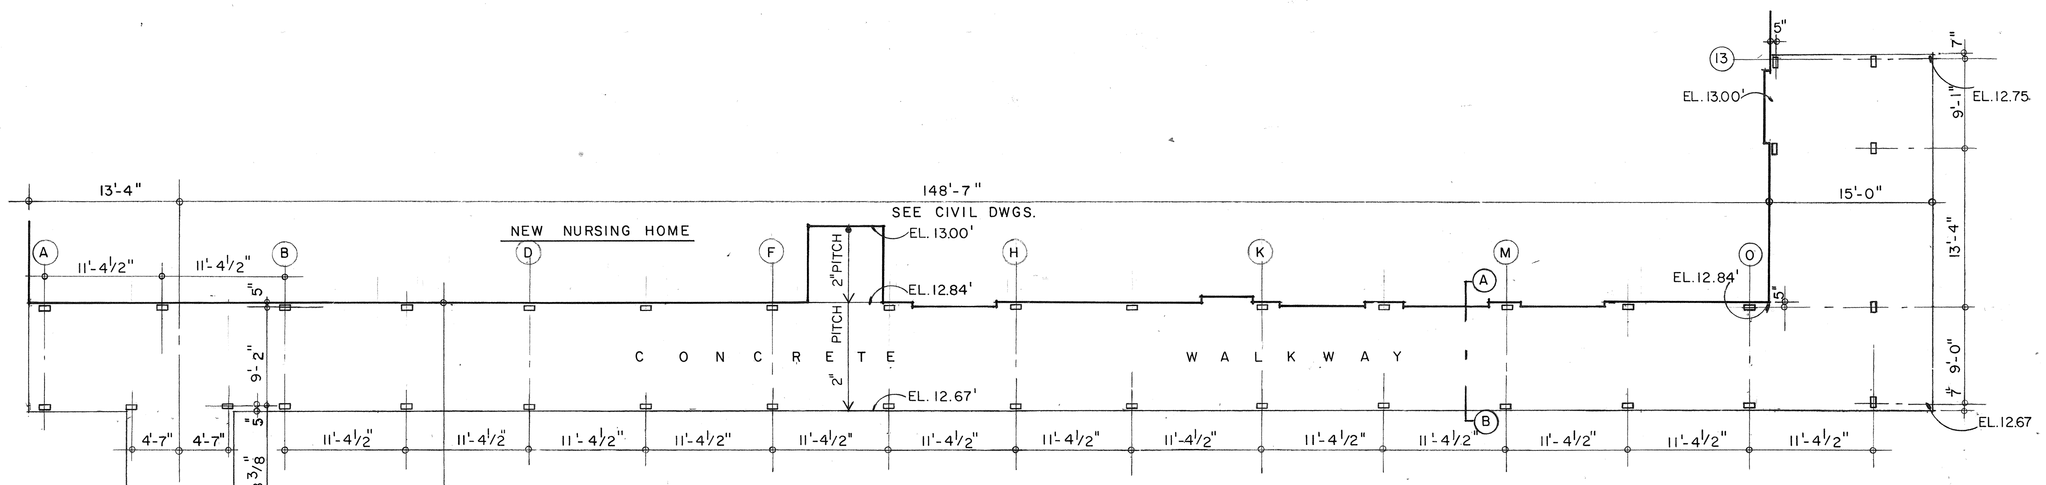


CANOPY FRAMING PLAN
1/4" = 1'-0"

NOTE: DITTMER ALUMINUM DETAILS USED FOR REFERENCE ONLY. ALL ALUMINUM TO BE BRONZE ANNODIZED TO MATCH DINING ROOM WINDOW FRAMES.




SECTION (A)

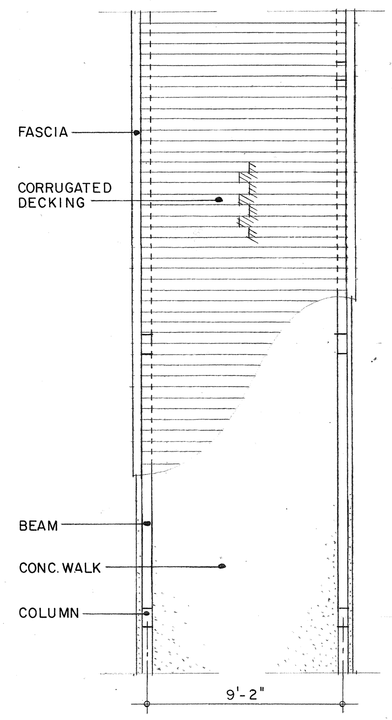SECTION (B)

CANOPY SECTION
3/4" = 1'-0"

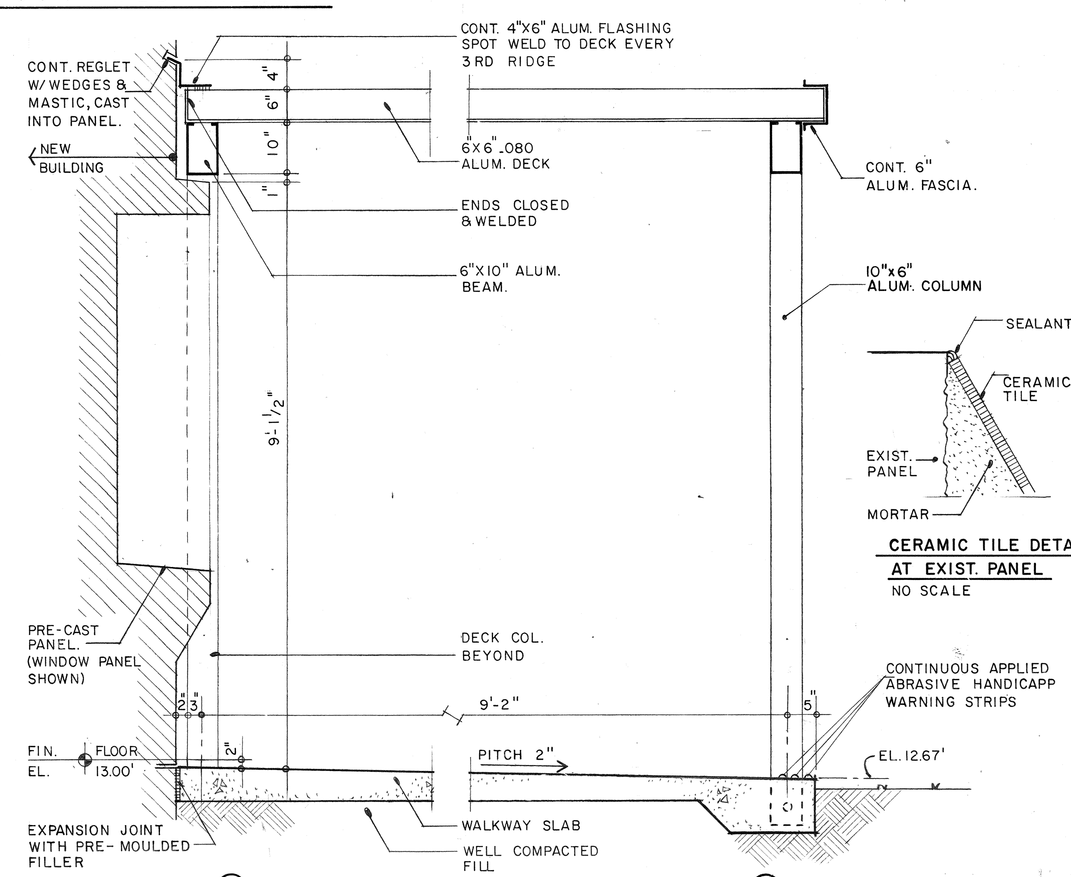


NEW ENTRANCE DETAILS
3" = 1'-0"




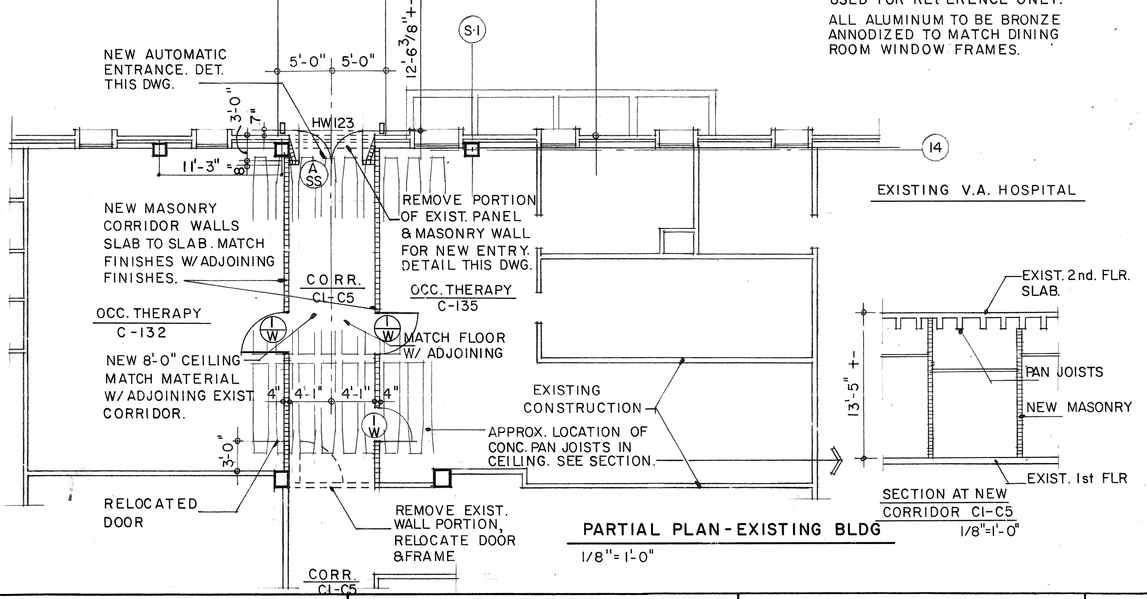


PARTIAL PLAN-EXISTING BLDG
1/8" = 1'-0"

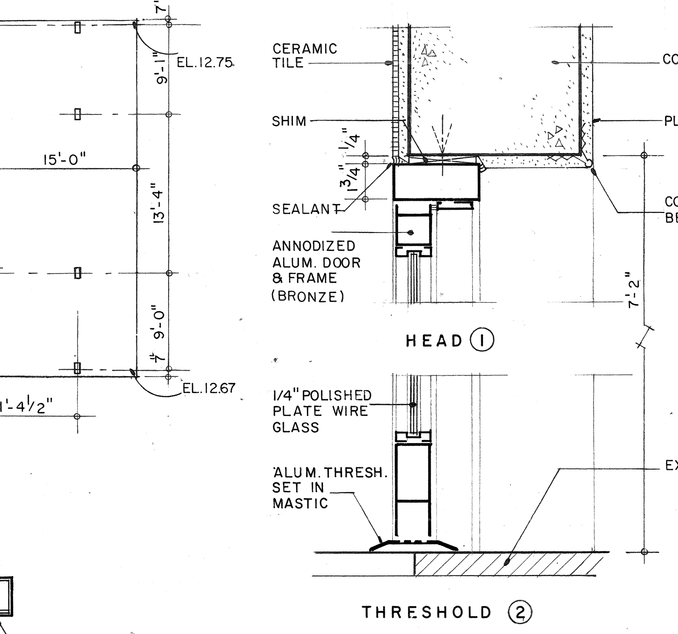


PARTIAL ELEVATION- EXISTING BLDG.
1/8" = 1'-0"




PLAN - NEW ENTRY
3/4" = 1'-0"

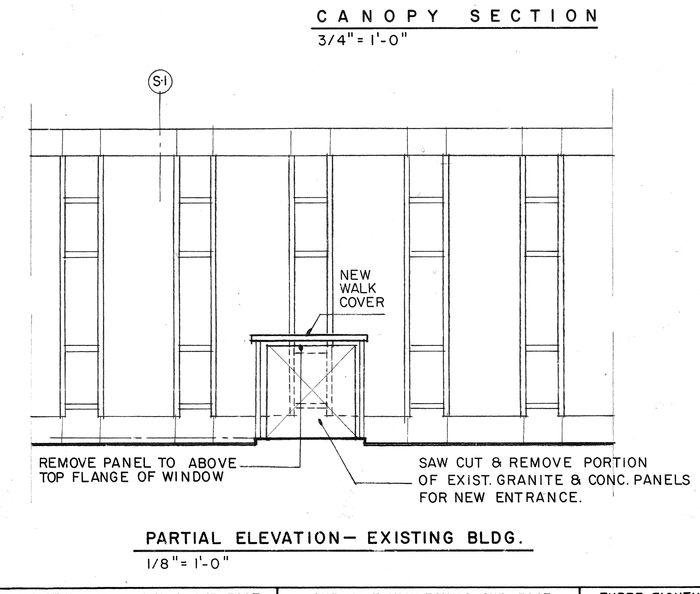


CERAMIC TILE DETAIL AT EXIST. PANEL
NO SCALE

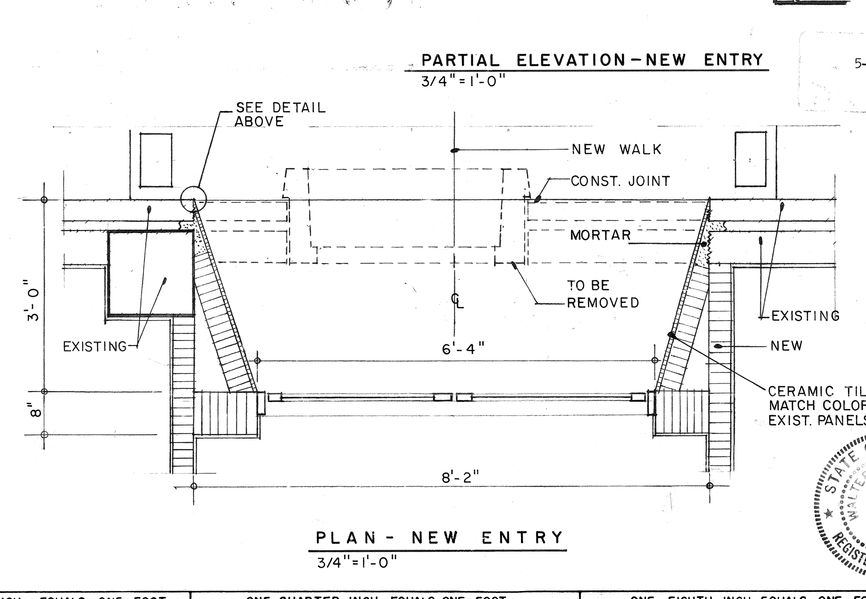


PARTIAL ELEVATION - NEW ENTRY
3/4" = 1'-0"

SECTION AT NEW ENTRY
3/4" = 1'-0"

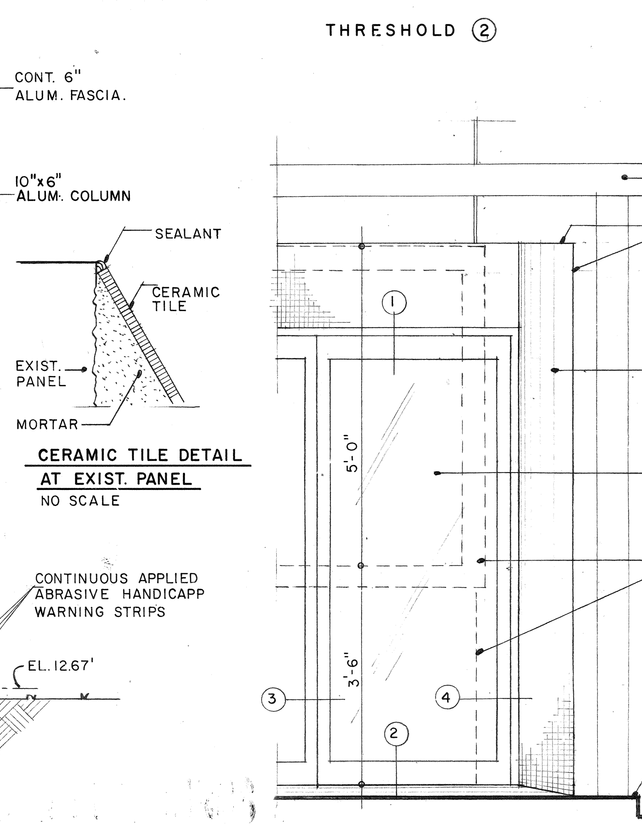5-3-2-1449

| NO. | DATE | DESCRIPTION |
|---|---|---|
| ⚠ | 8-12-80 | AS-BUILT |

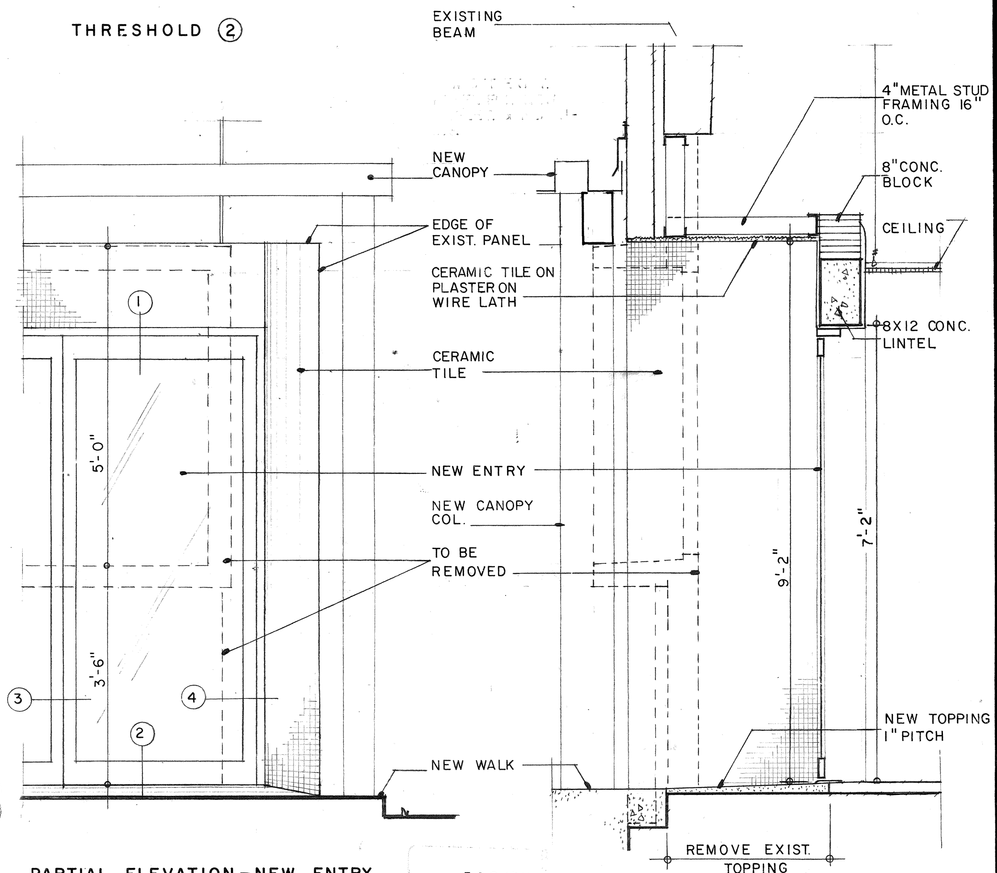REVISIONS

SHEET TITLE: PLANS - ELEVATIONS - DETAILS COVERED WALK

BLDG. NO. 10

PROJECT TITLE: 120 Bed Nursing Home Care Unit

DRAWN: STIMSON

CHECKED: Walter Hubbard

DATE: JAN 16 1978

The Smith, Korach, Hayet, Haynie Partnership
Architects, Engineers, Planners
175 Fontainbleau Boulevard
Miami, Florida

DRAWING NUMBER: 10o7

DWG. 24 OF 122

APPROVED : PROJECT DIRECTOR: J.H. Bell

PROJECT NUMBER: 546-007

VETERANS ADMINISTRATION

LOCATION: V.A.H. Miami, Florida

STATE OF FLORIDA WALTER J. HUBBARD 1834 MIAMI REGISTERED ARCHITECT

THREE INCHES EQUALS ONE FOOT | ONE AND ONE HALF INCHES EQUALS ONE FOOT | ONE INCH EQUALS ONE FOOT | THREE QUARTER INCH EQUALS ONE FOOT | ONE HALF INCH EQUALS ONE FOOT | THREE EIGHTH INCH EQUALS ONE FOOT | ONE QUARTER INCH EQUALS ONE FOOT | ONE EIGHTH INCH EQUALS ONE FOOT