

1 2 3 4 5 6 7 8 9

A

B

C

D

E

F

A

B



C

D

E


F

three inches = one foot
one and one half inches = one foot
one inch = one foot
three quarters inch = one foot
one half inch = one foot
three eighths inch = one foot
one quarter inch = one foot
one eighth inch = one foot

 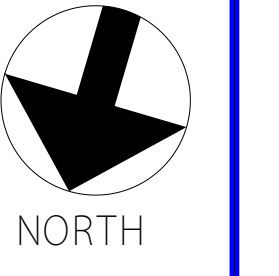

Revisions	Date

Professional Seal

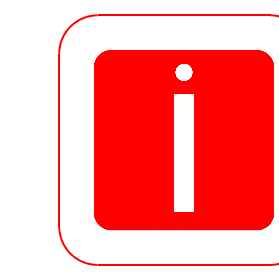

Indus Systems, Inc.
2352, Main Street, Concord MA 01742
Tel: 978 - 461 - 0555
www.indus-systems.com

Drawing Title BASEMENT FLOOR PLAN ARCHITECTURAL	
Approved:	
Approved:	

Project Title AS - BUILT Drawings	
Building Number 18	Checked
Location VAMC TUSCALOOSA	Drawn

Date 02 - 24 - 2010
Project No.
Drawing No.

VAMC, TUSCALOOSA

Department of Veterans Affairs
VA

1 2 3 4 5 6 7 8 9