
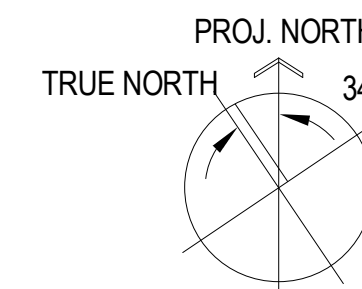


SHEET NOTES

- = INTERIOR DOORS NEED ACTUATORS, SENSOR, PADELS
- = INTERIOR DOORS NEED ACTUATORS, SENSOR, PADEL AND PUSH BUTTONS
- = EXTERIOR DOORS NEED ACTUATORS, SENSOR, PODIUM
- = INTERIOR DOORS NEED ACTUATORS, SENSOR, PADELS AND PUCH BUTTON AT RECEPTION
- = PADEL/PUSH BUTTON LOCATIONS

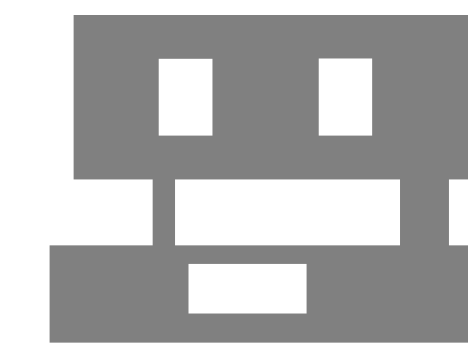

FULLY SPRINKLERED

CONSTRUCTION DOCUMENTS

CONSULTANTS:

Seals and Signatures

ARCHITECT/ENGINEERS:

SMITHGROUP
architecture engineering interiors planning
301 BATTERY STREET, 7TH FLOOR
SAN FRANCISCO, CA 94111
T 415.227.0100 F 415.908.0862
www.smithgroup.com

Associate Architect:
The Design Partnership LLP
Architects + Planners
1412 VAN NESS AVE., 2ND FLOOR
SAN FRANCISCO, CA 94109
T 415.777.3737 F 415.777.3476
www.dpsf.com

Drawing Title
OVERALL FLOOR PLAN LEVEL 1

Approved: Project Director

Melan Arskic

Project Title
**CENTERS FOR AMBULATORY CARE,
POLYTRAUMA AND BLIND REHABILITATION**
Polytrauma and Blind Rehabilitation Center

Location
3801 Miranda Ave., Palo Alto CA
Date
Jan 17, 2014
Checked
JG
Drawn
NW

Project Number
640-424
Building Number
500
Drawing Number
AE2.1.1
Dwg. of

Office of
Construction
and Facilities
Management



54 FLOOR PLAN LEVEL 1
SCALE: 1/16" = 1'-0"