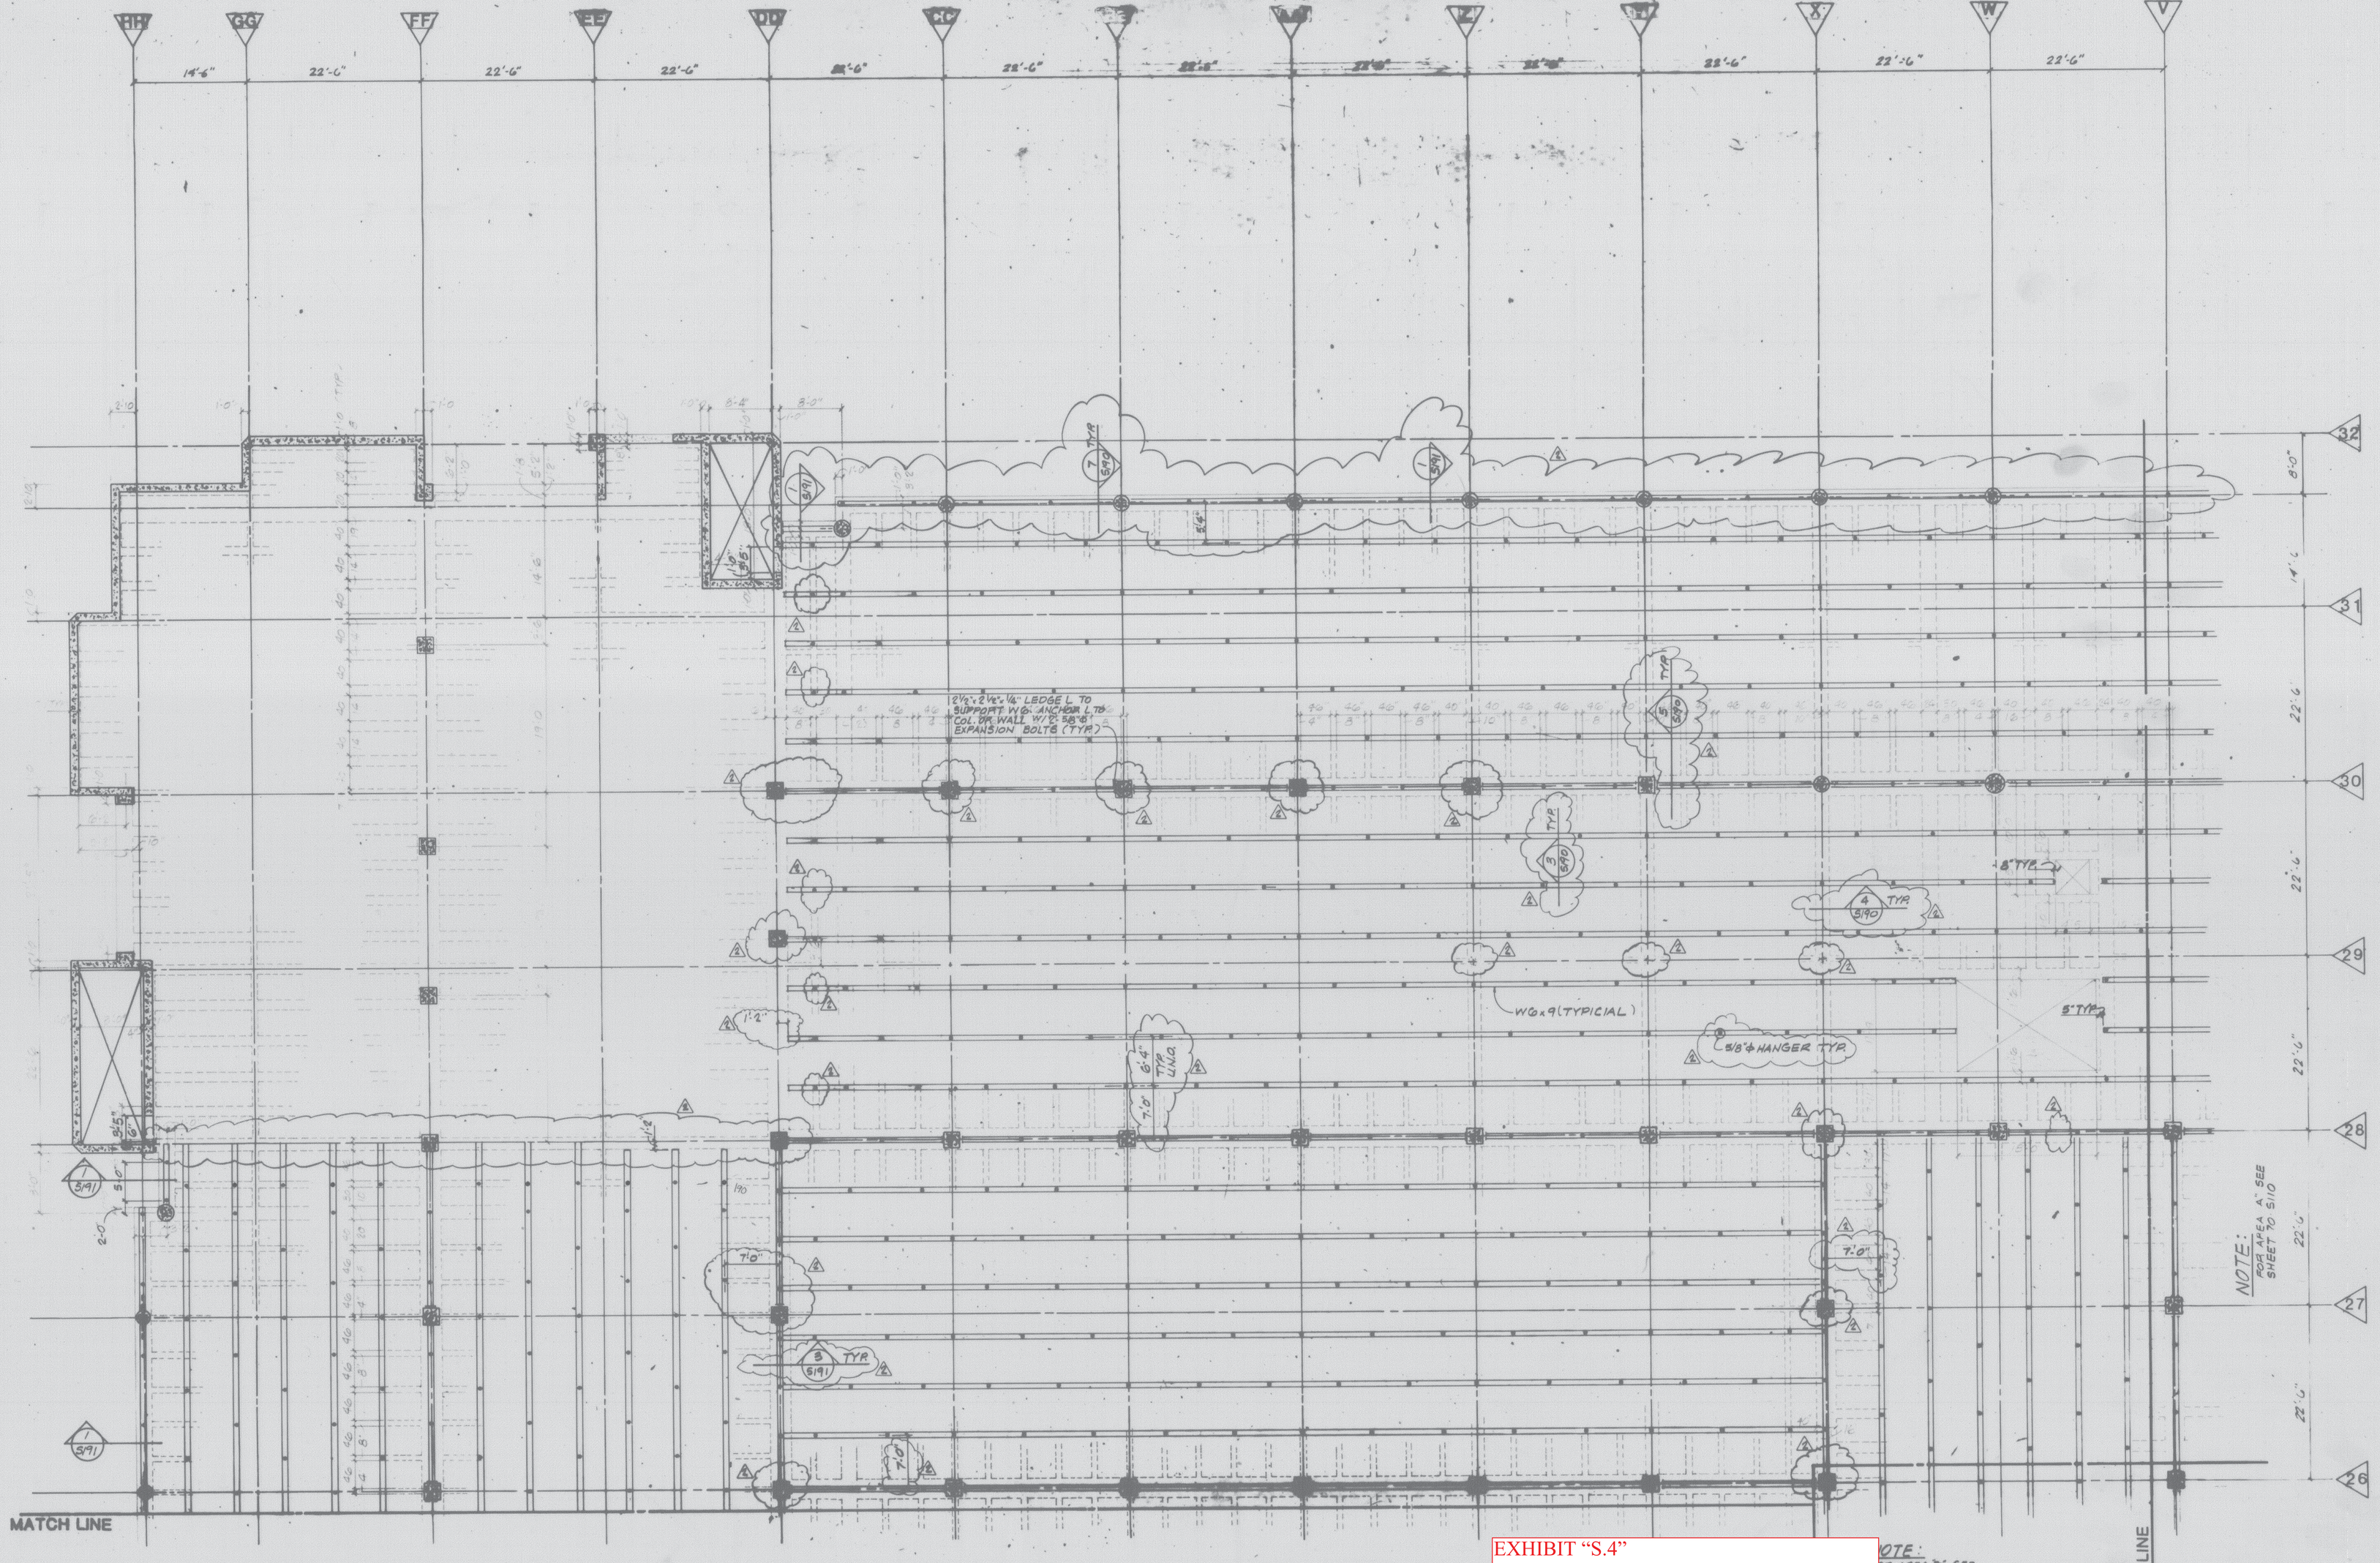

EXHIBIT "S.4"
INSTALL OPERATING ROOM BOOMS
PHASE 2
PROJECT NO.: 618-12-302
EXISTING INTERSTITIAL STRUC. PLAN

7-1-2-2322

AS BUILT 8/29/88

THIS DRAWING SUPERSEDES DRAWING NO 70-5121

UNA GROUP
A Joint Venture
HGA Hammel, Green and Abrahamson, Inc.
SGA Sating, Gisler and Associates, Inc.
HDR

Building Title: THIRD INTERSTITIAL FLOOR FRAMING PLAN AREA 'M'
SCALE: 1/8"=1'-0"
Project Title: EXCAVATION, FOUNDATION, STRUCTURAL FRAME & ENCLOSURE PHASE IV
Date: 2-14-84
Project No: 615-001D
Approved Project Director
Drawn: C.L.H.
Checked: N.S.
Building Number: 70
Location: Minneapolis, Minn
Drawing No: 70-S121R
Sheet 46 of 59

Veterans Administration